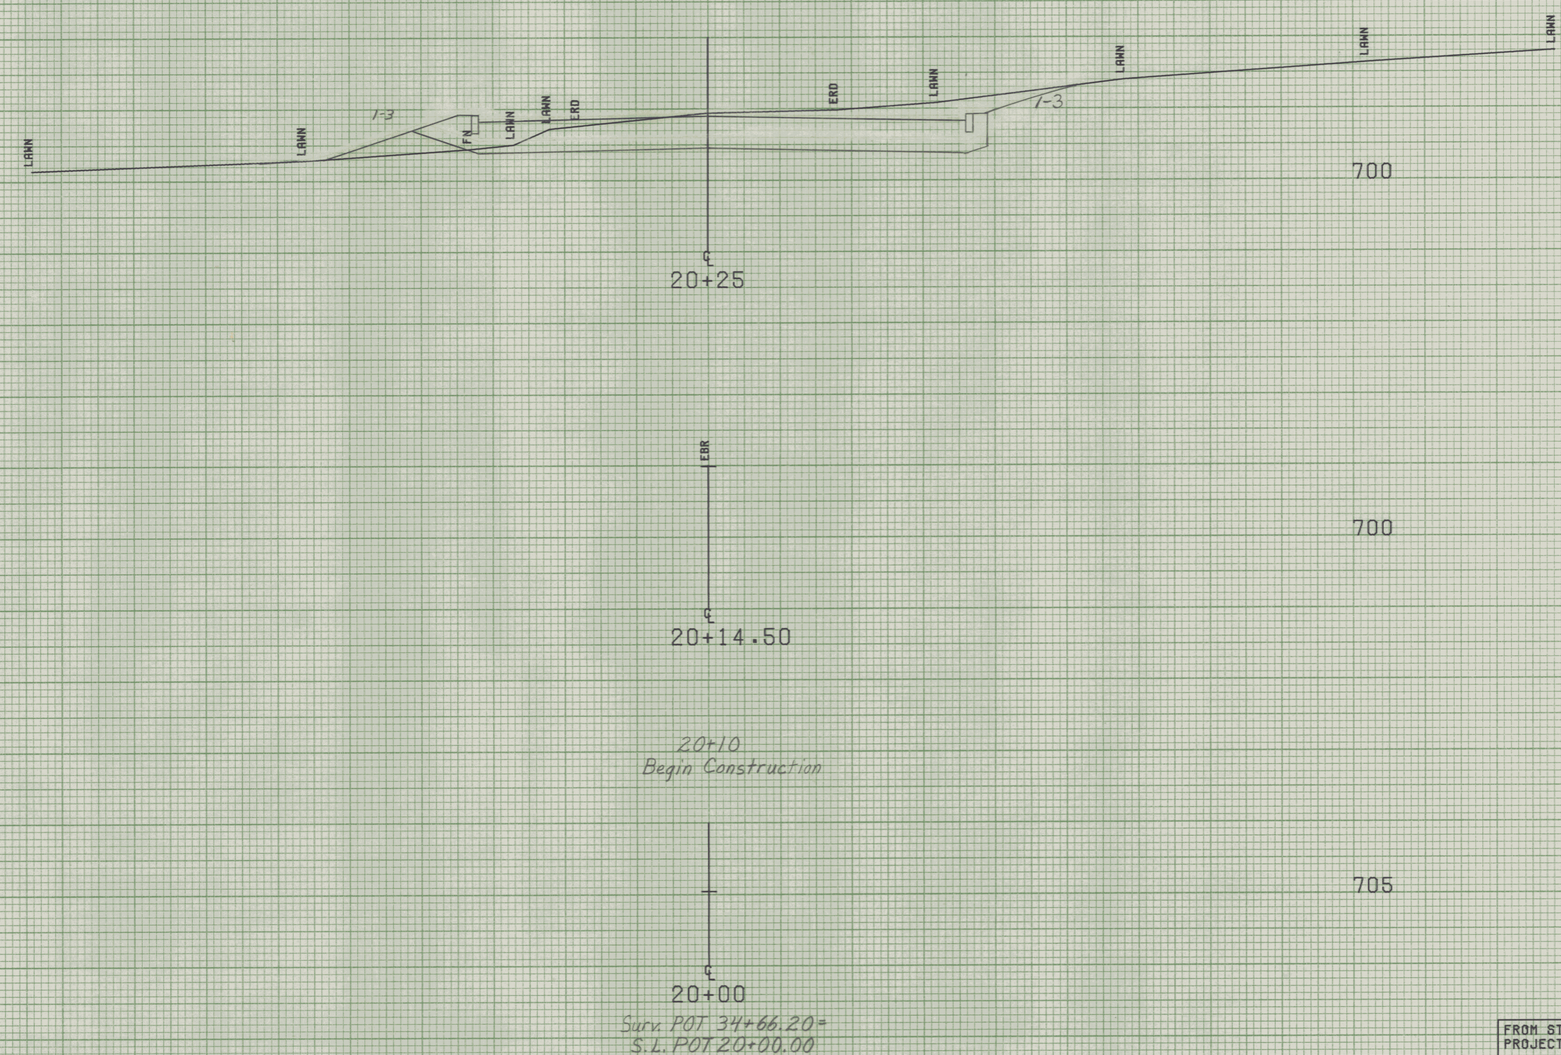

SCALE 5 FEET

FROM STA. 20+00		TO STA. 20+25	
PROJECT NAME	MONTPELIER	BLODGETT	
NO.	M6400(7)		PLOTTED 08/05/85
SURVEYED BY	KASTNER-MOREAU JUNE 1985		
SHEET 264 OF 335 SHEETS			