


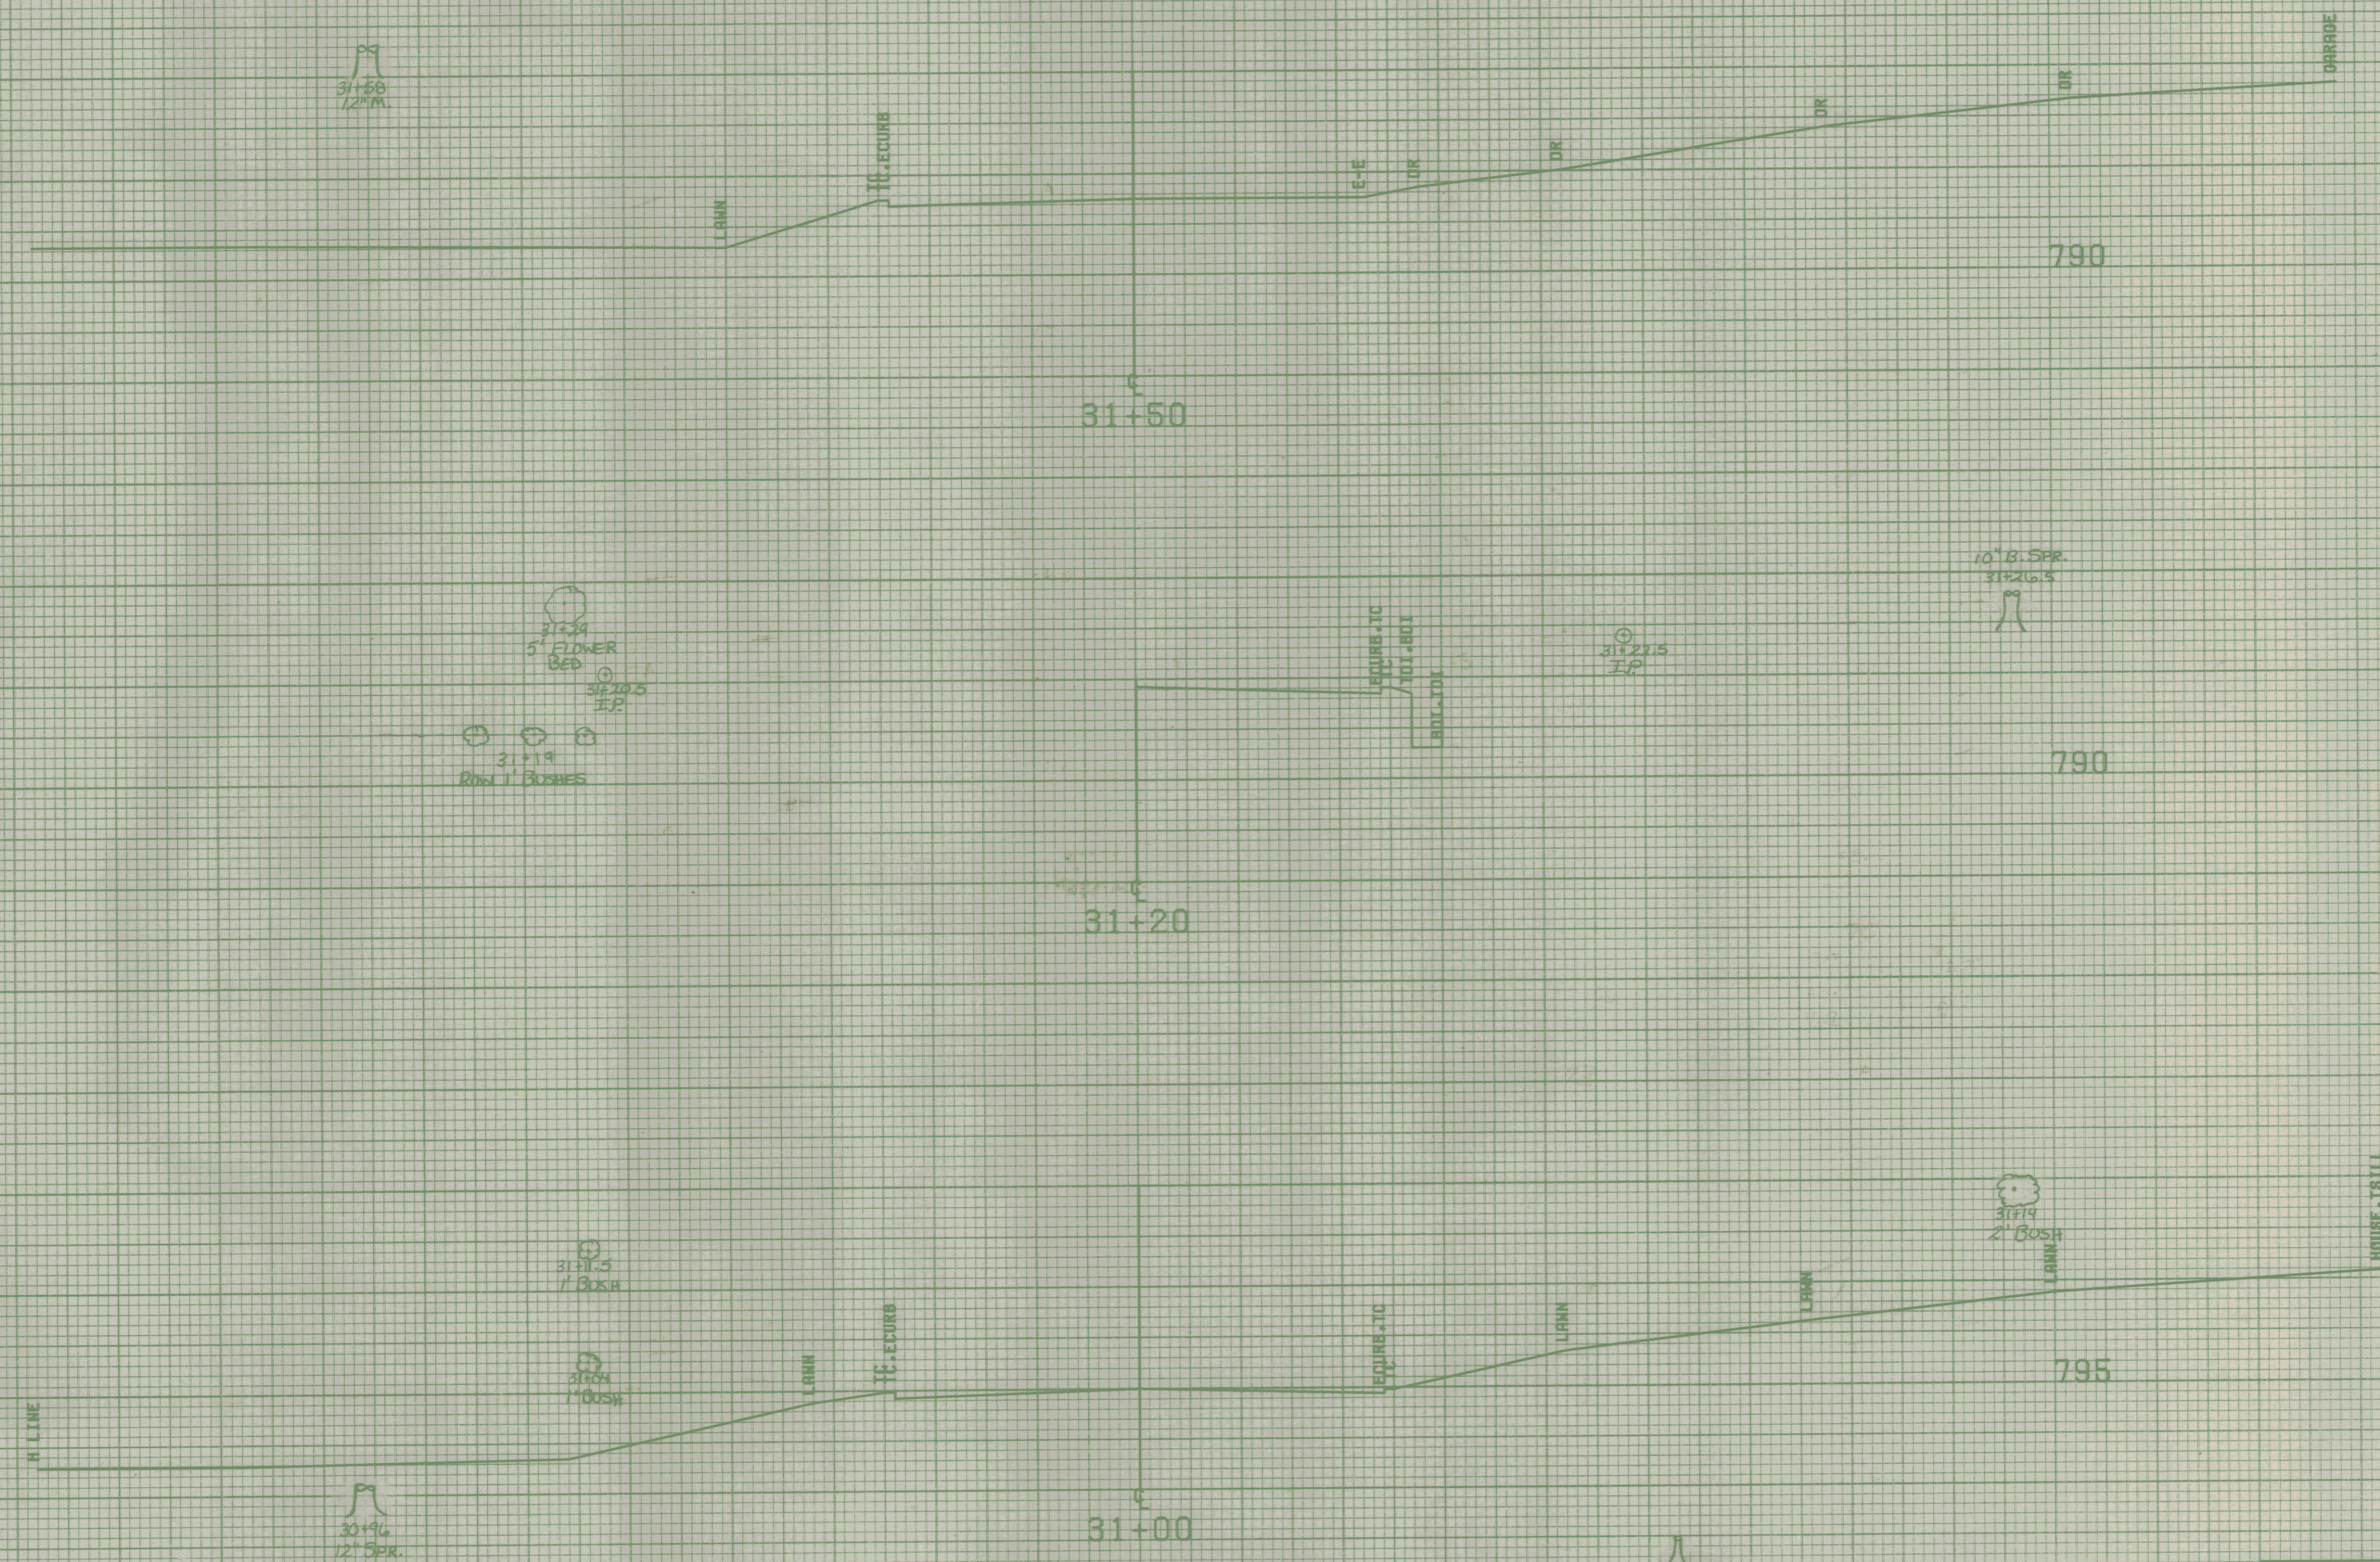

FROM STA. 31+00 TO STA. 31+50
PROJECT NAME MONTPELIER VALERIE
NO. M6400(7) PLOTTED 06/05/85
SURVEYED BY KASNER-MOREAU JUNE 1985
SHEET 271 OF 335 SHEETS

SCALE 1" = 5 FEET