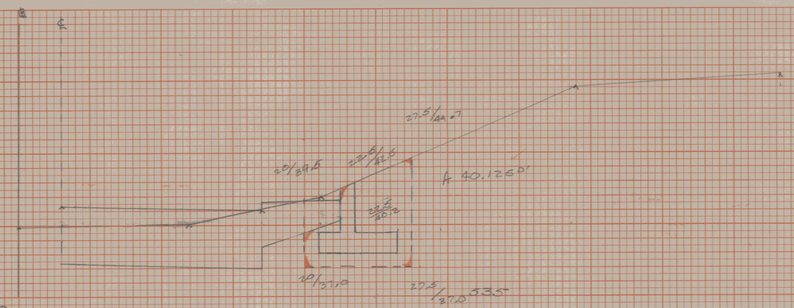

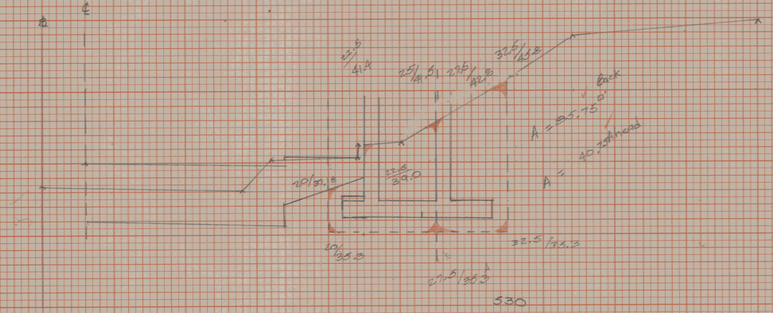

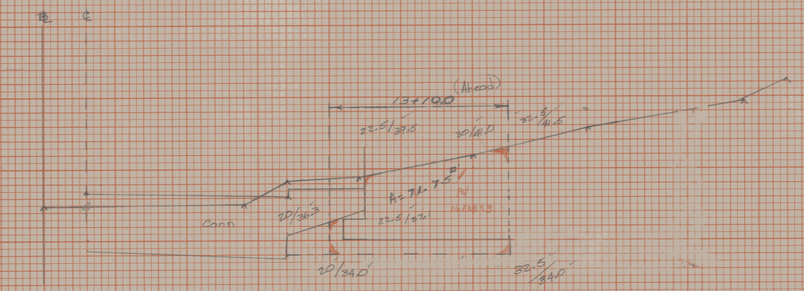

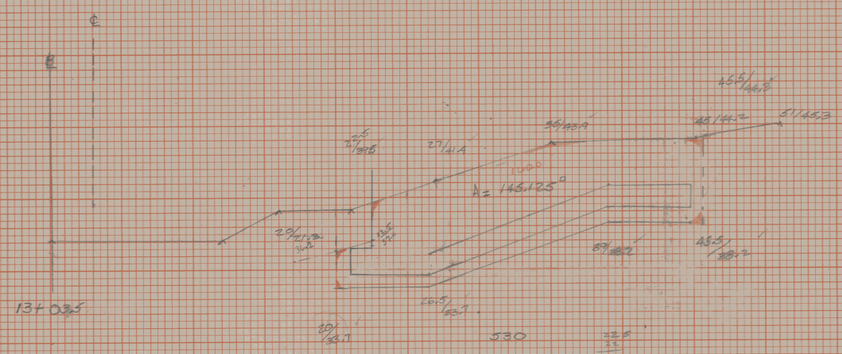

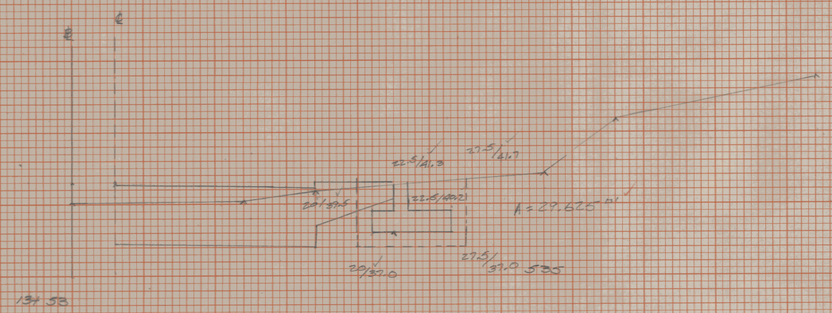

Structure Excavation			Granular Backfill for structures	
Station	Area	Volume	Area	Volume
13+03.5	145.1		0	
0.5		349		
+10.0	145.1			
		2		
+10.0	71.8			
		67.1		
+33.0	85.8			
+33.0	40.3			
		25.3		
+50	40.1			
+53	29.6 Sq	3.9		

13+1.2 FS 10-11-91
13+1.3 PW 10 FEB 93
to BK 3 Page 8

Montpelier MESCM 6400 (2)
Structure Sections
Wall #3

FINAL SURVEY — NOTE BOOK No. — SURVEYED / PLOTTED / TEMPLATE / AREAS / AREAS CHECKED — BY — DATE

ORIGINAL SURVEY — NOTE BOOK No. — SURVEYED / PLOTTED / TEMPLATE / AREAS / AREAS CHECKED — BY — DATE

351+51