

BEGIN RELINQUISHMENT NO. I
STA. 7+06 & LENGTH 247'


END RELINQUISHMENT NO. I
BEGIN MAINT. AGREE. AREA NO. I
STA. 9+53 & LENGTH 74'

THIS SHEET TO BE USED
FOR ROW INFORMATION ONLY

END MAINT. AGREE. AREA NO. I
BEGIN RELINQUISHMENT NO. II
STA. 10+27 & LENGTH 1108'

CURVE DATA
Δ 9° 53' 30" LT
D 2"
R 286479
T 247.91
L 494.58
E 10.71
BANK 0.027 FVFT

ESTATE OF
SEVERANCE, J. HERBERT
& JUANITA M.

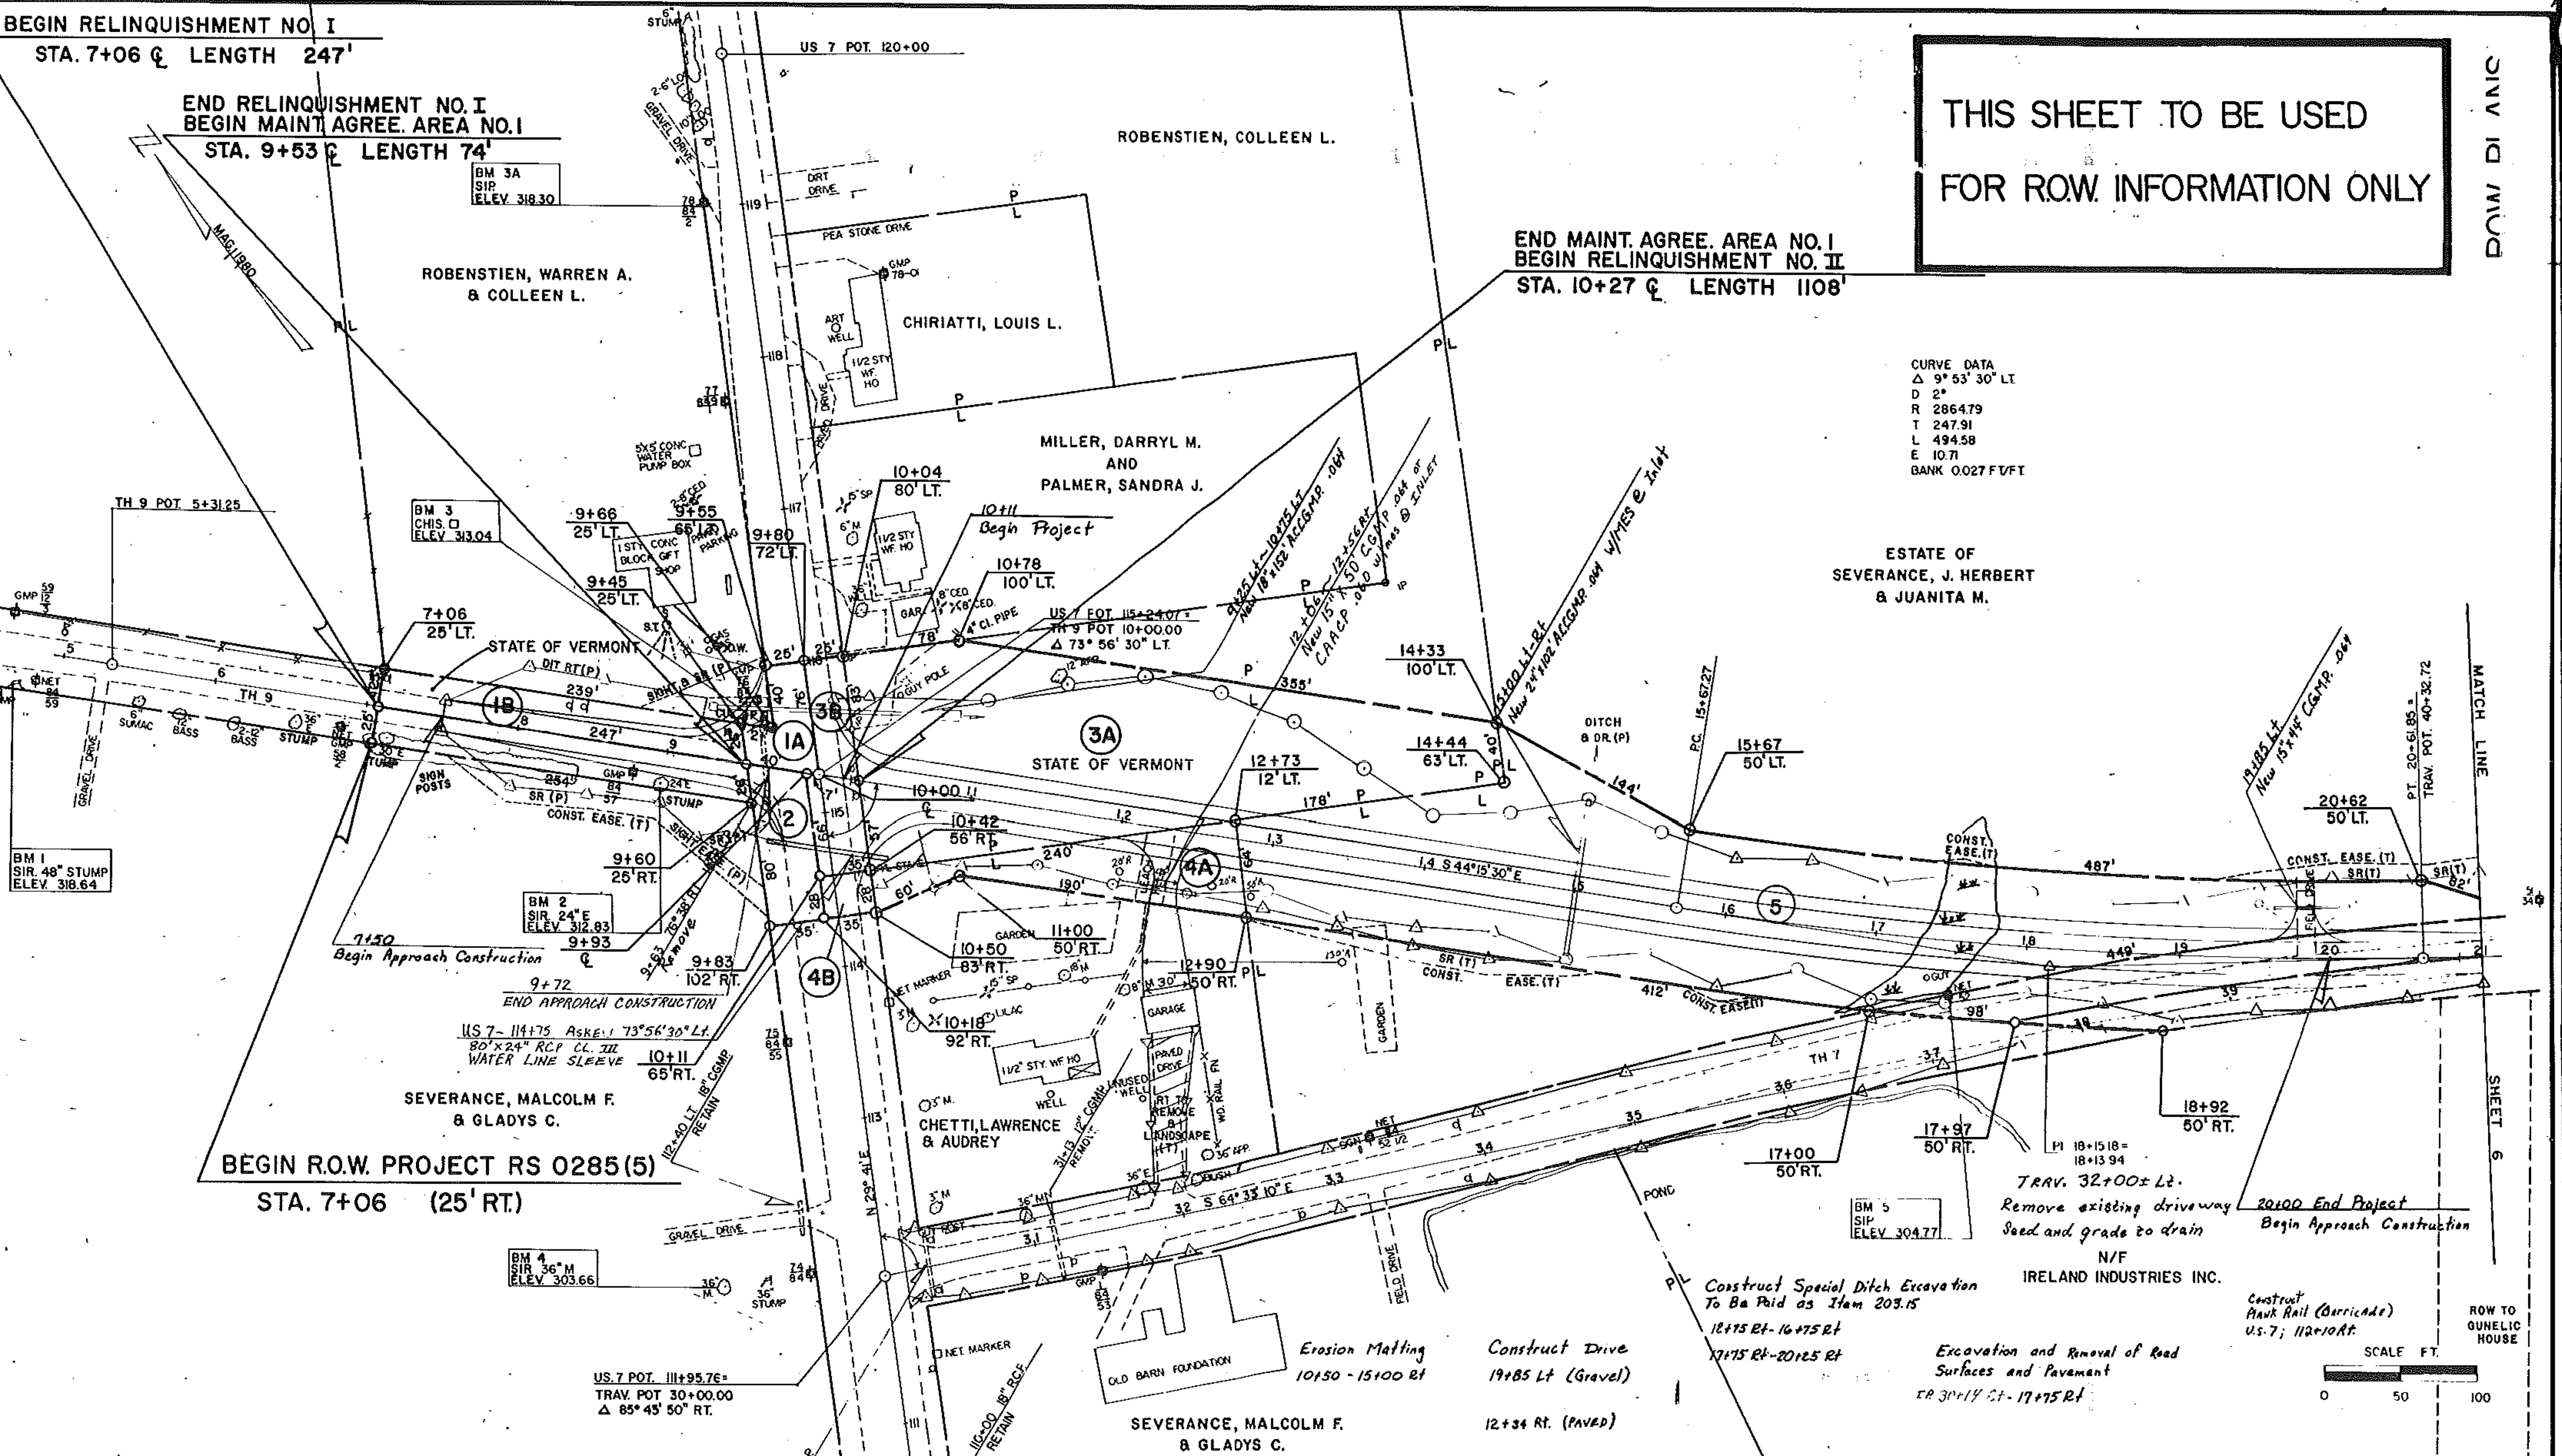


BM 1
SIR. 48" STUMP
ELEV. 318.64

BM 3
CHIS. □
ELEV. 313.04

BM 2
SIR. 24" E
ELEV. 312.83

BM 4
SIR. 36" M
ELEV. 303.66

BM 5
SIP
ELEV. 304.77

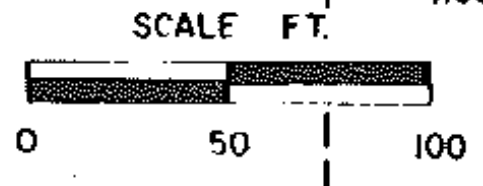

US 7 POT 111+95.76+ TRAV. POT 30+00.00	US 7 POT 115+24.07+ TH 9 POT 10+00.00	US 7 POT 120+00.00	TH 9 POT 5+31.25	TH 9 PC 15+67.27	TH 9 PI 18+15.18= 18+13.94	TH 9 PI 20+61.85+ TRAV. POT 40+32.72
---	--	--------------------	------------------	------------------	-------------------------------	---

SURVEYED BY FALL DATE 10/80
DRAWN BY DATE
TRACED BY DATE
COLCHESTER
PROJ. RS NO. 0285 (5)
SHEET 16 OF 93

ICAL NGVD 1929
ZONTAL N/A