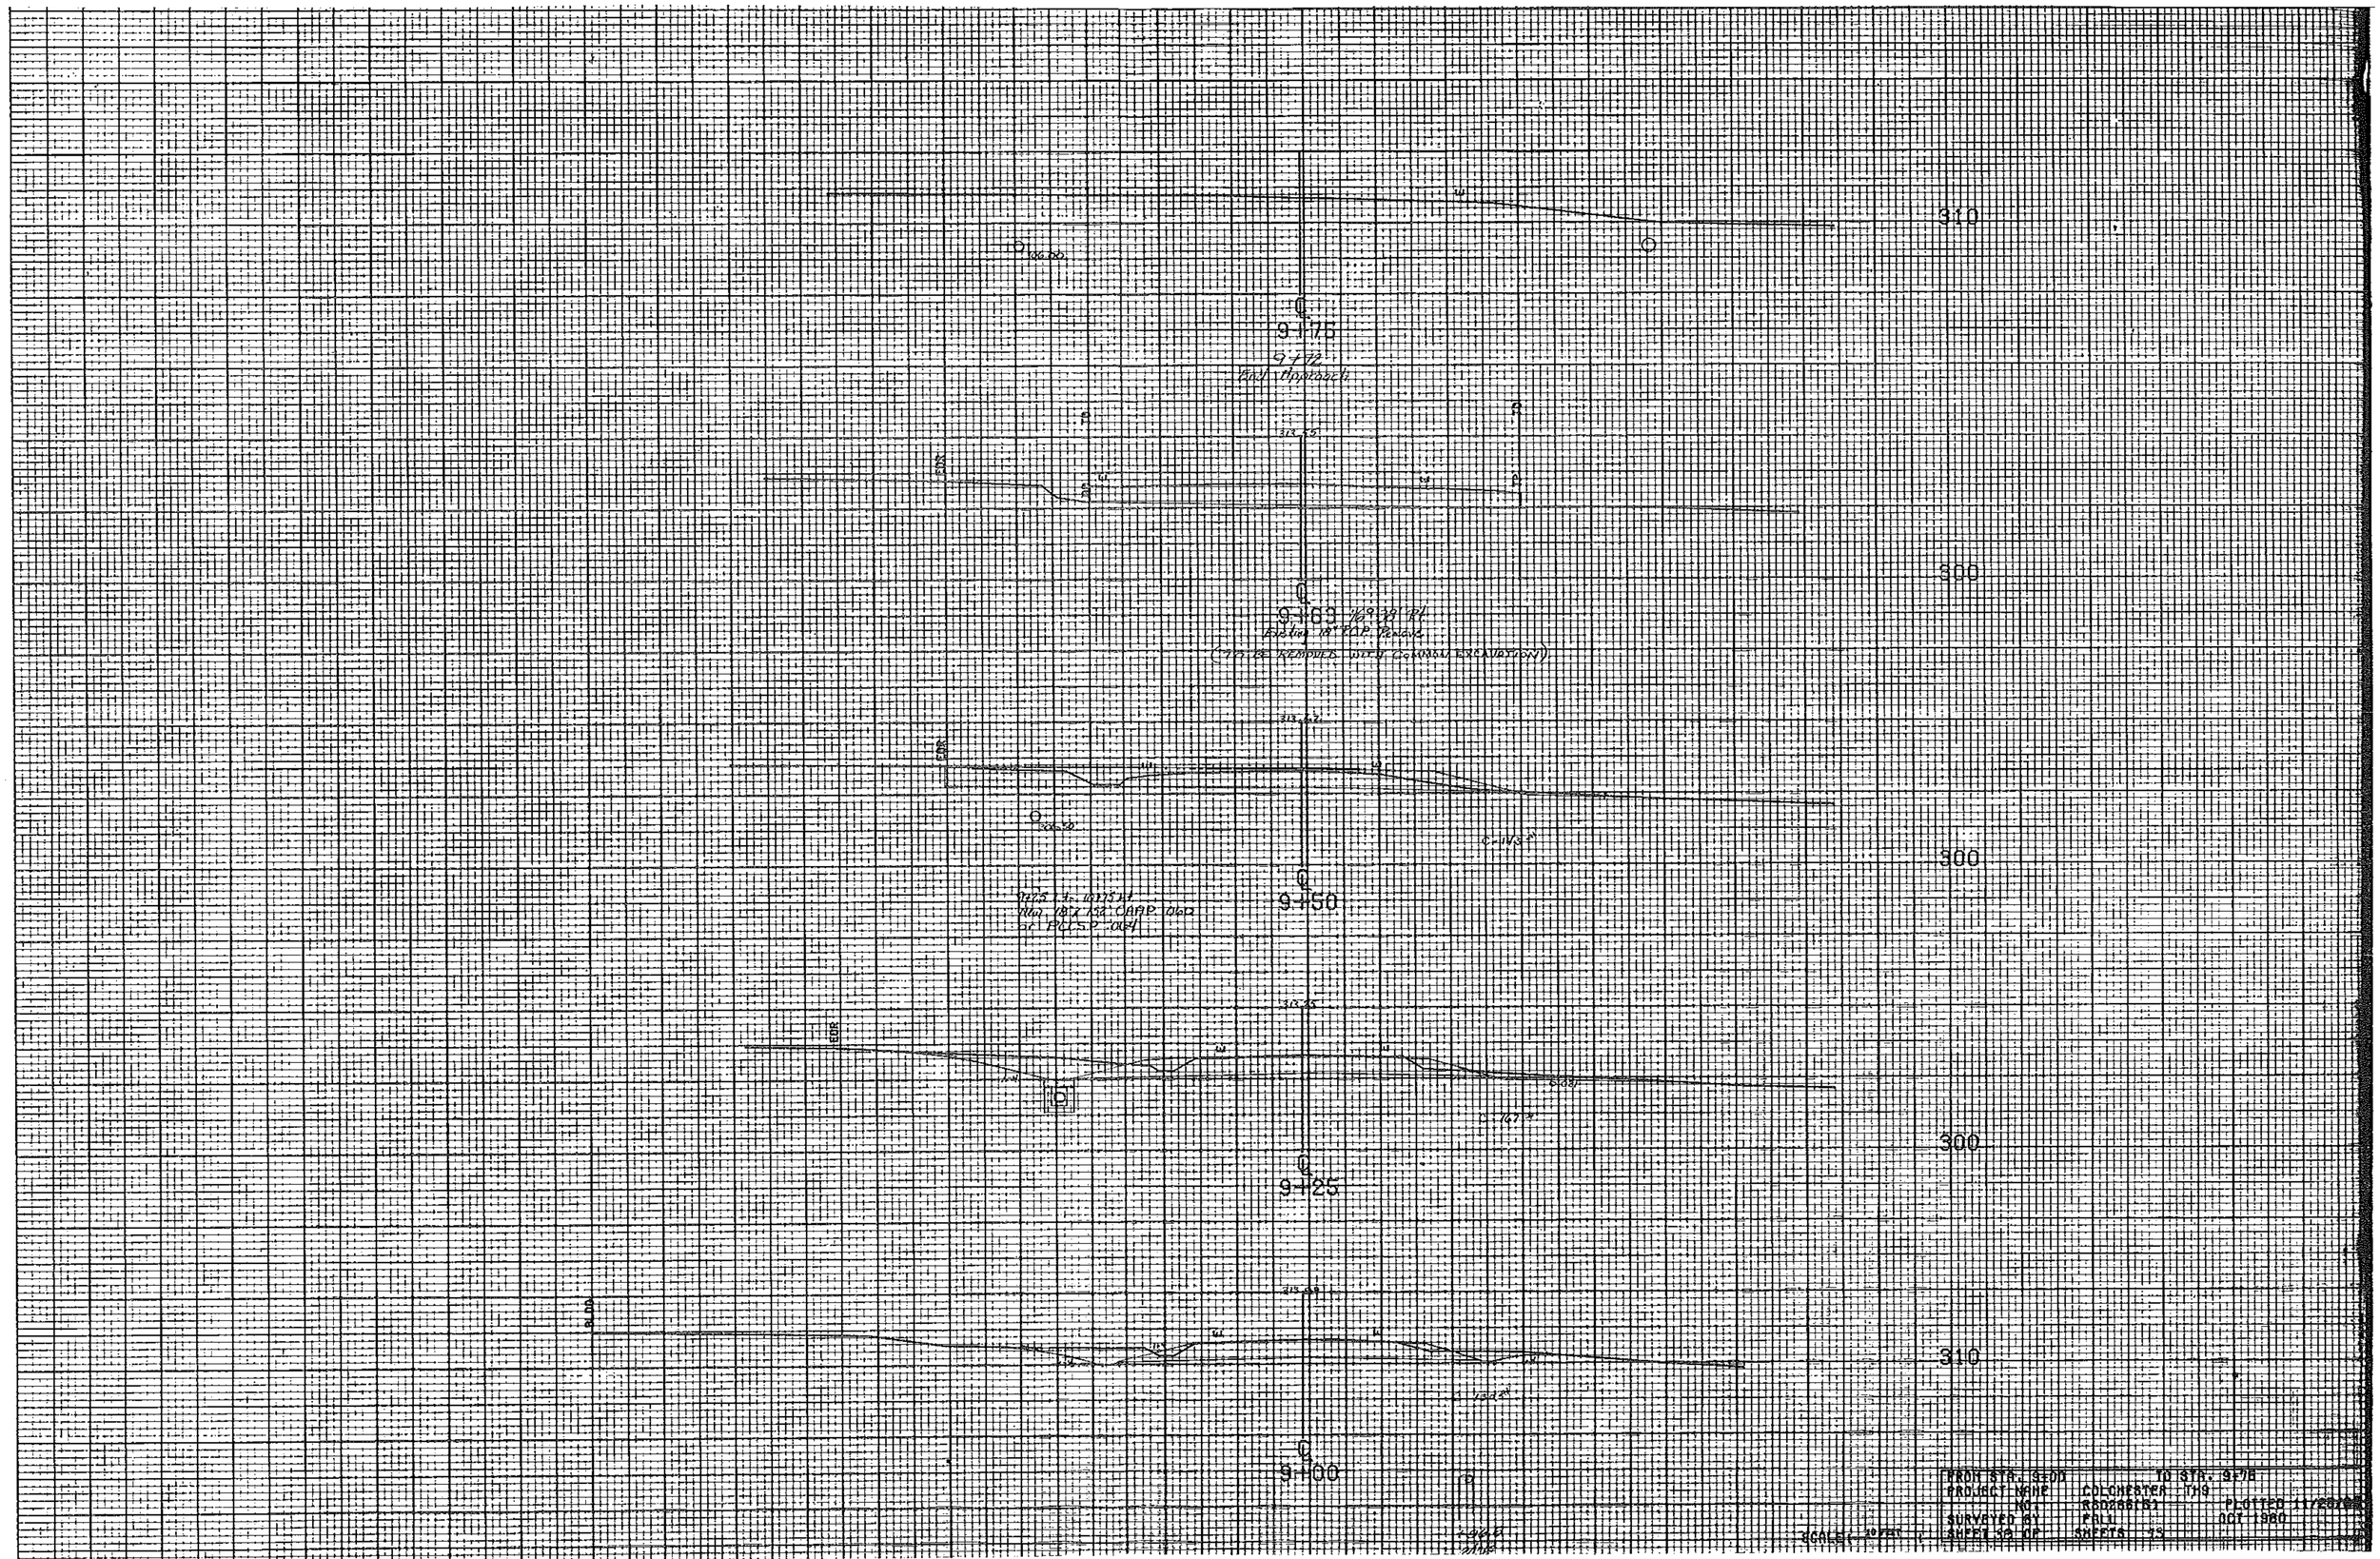
310
9+75
9+63
300
9+50
300
9+25
310
9+00
FROM STA. 9+00
TO STA. 9+78
PROJECT NAME
COLCHESTER TH9
NO.
R002661B1
PLOTTED
SURVEYED BY
FALL
OCT 1980
SHEET 30 OF
SHEETS 43
SCALE: 20 FEET