



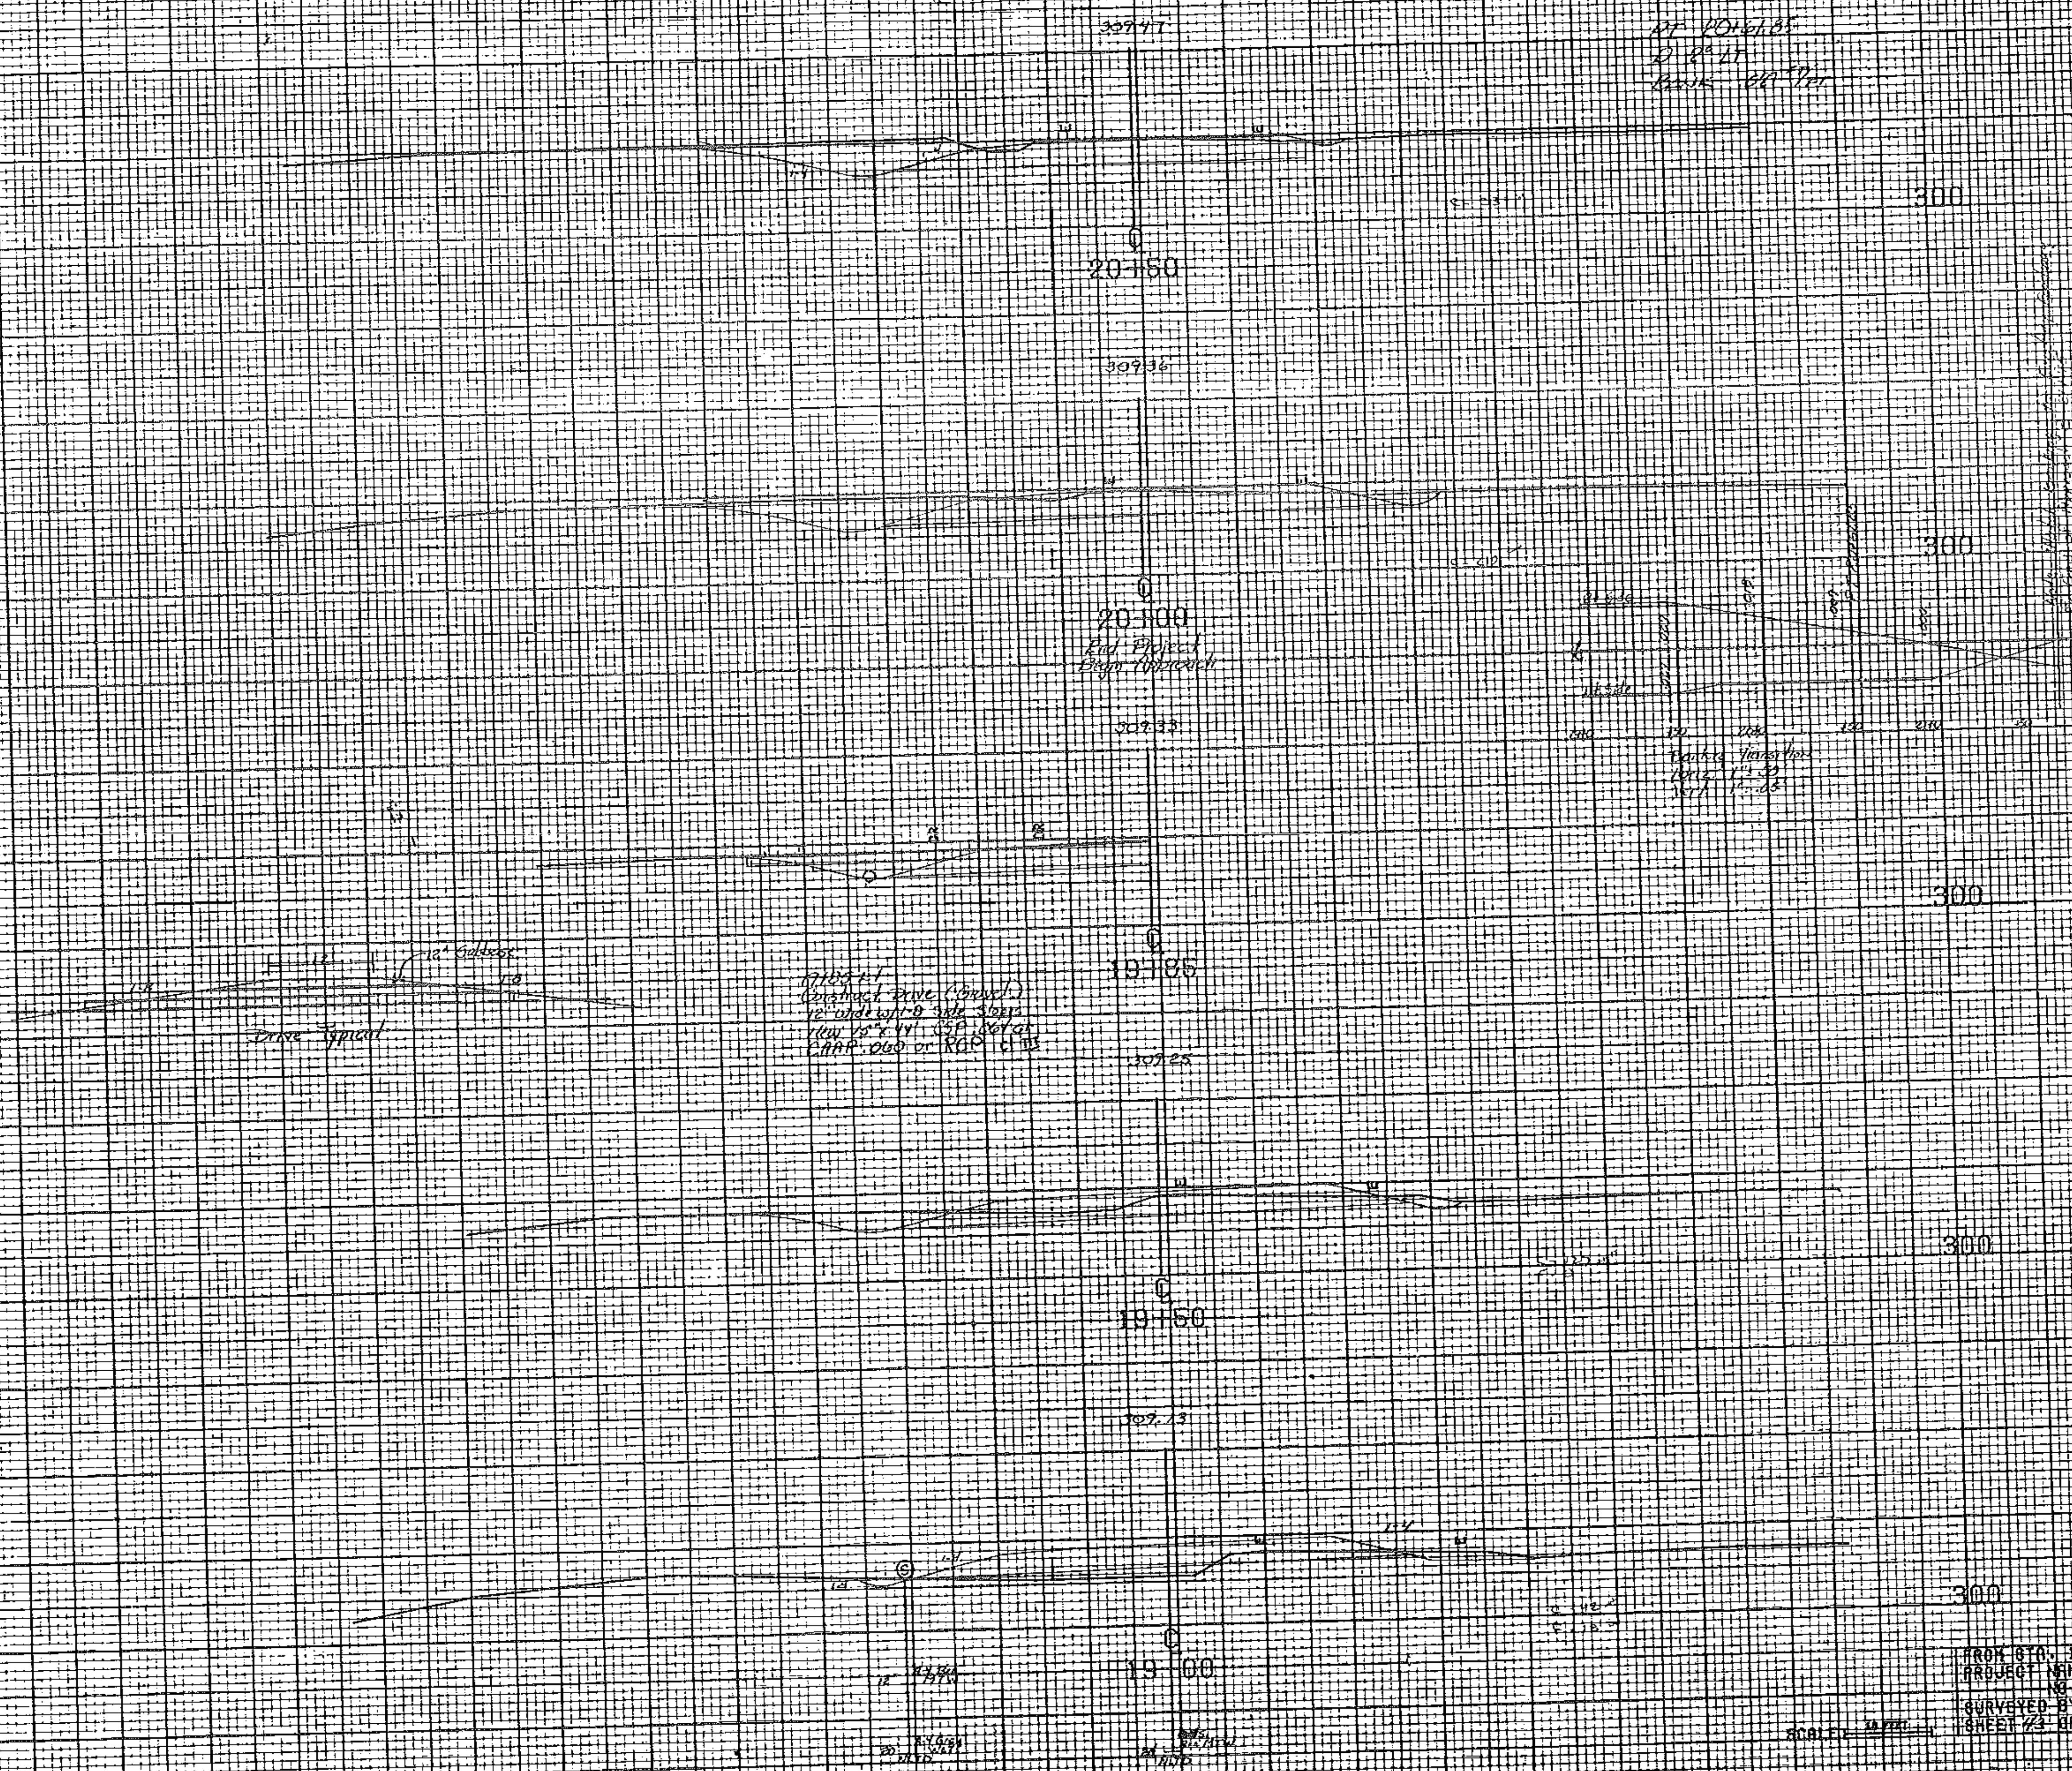



12' wide
3:1 slope
view typical

FROM STA. 19+00 TO STA. 20+50
PROJECT NAME COLONESTER TRS
NO. R620010
SURVEYED BY FRLU
PLOTTER 1/26/80
OCT 1980

SCALE 1" = 10'


19+00


