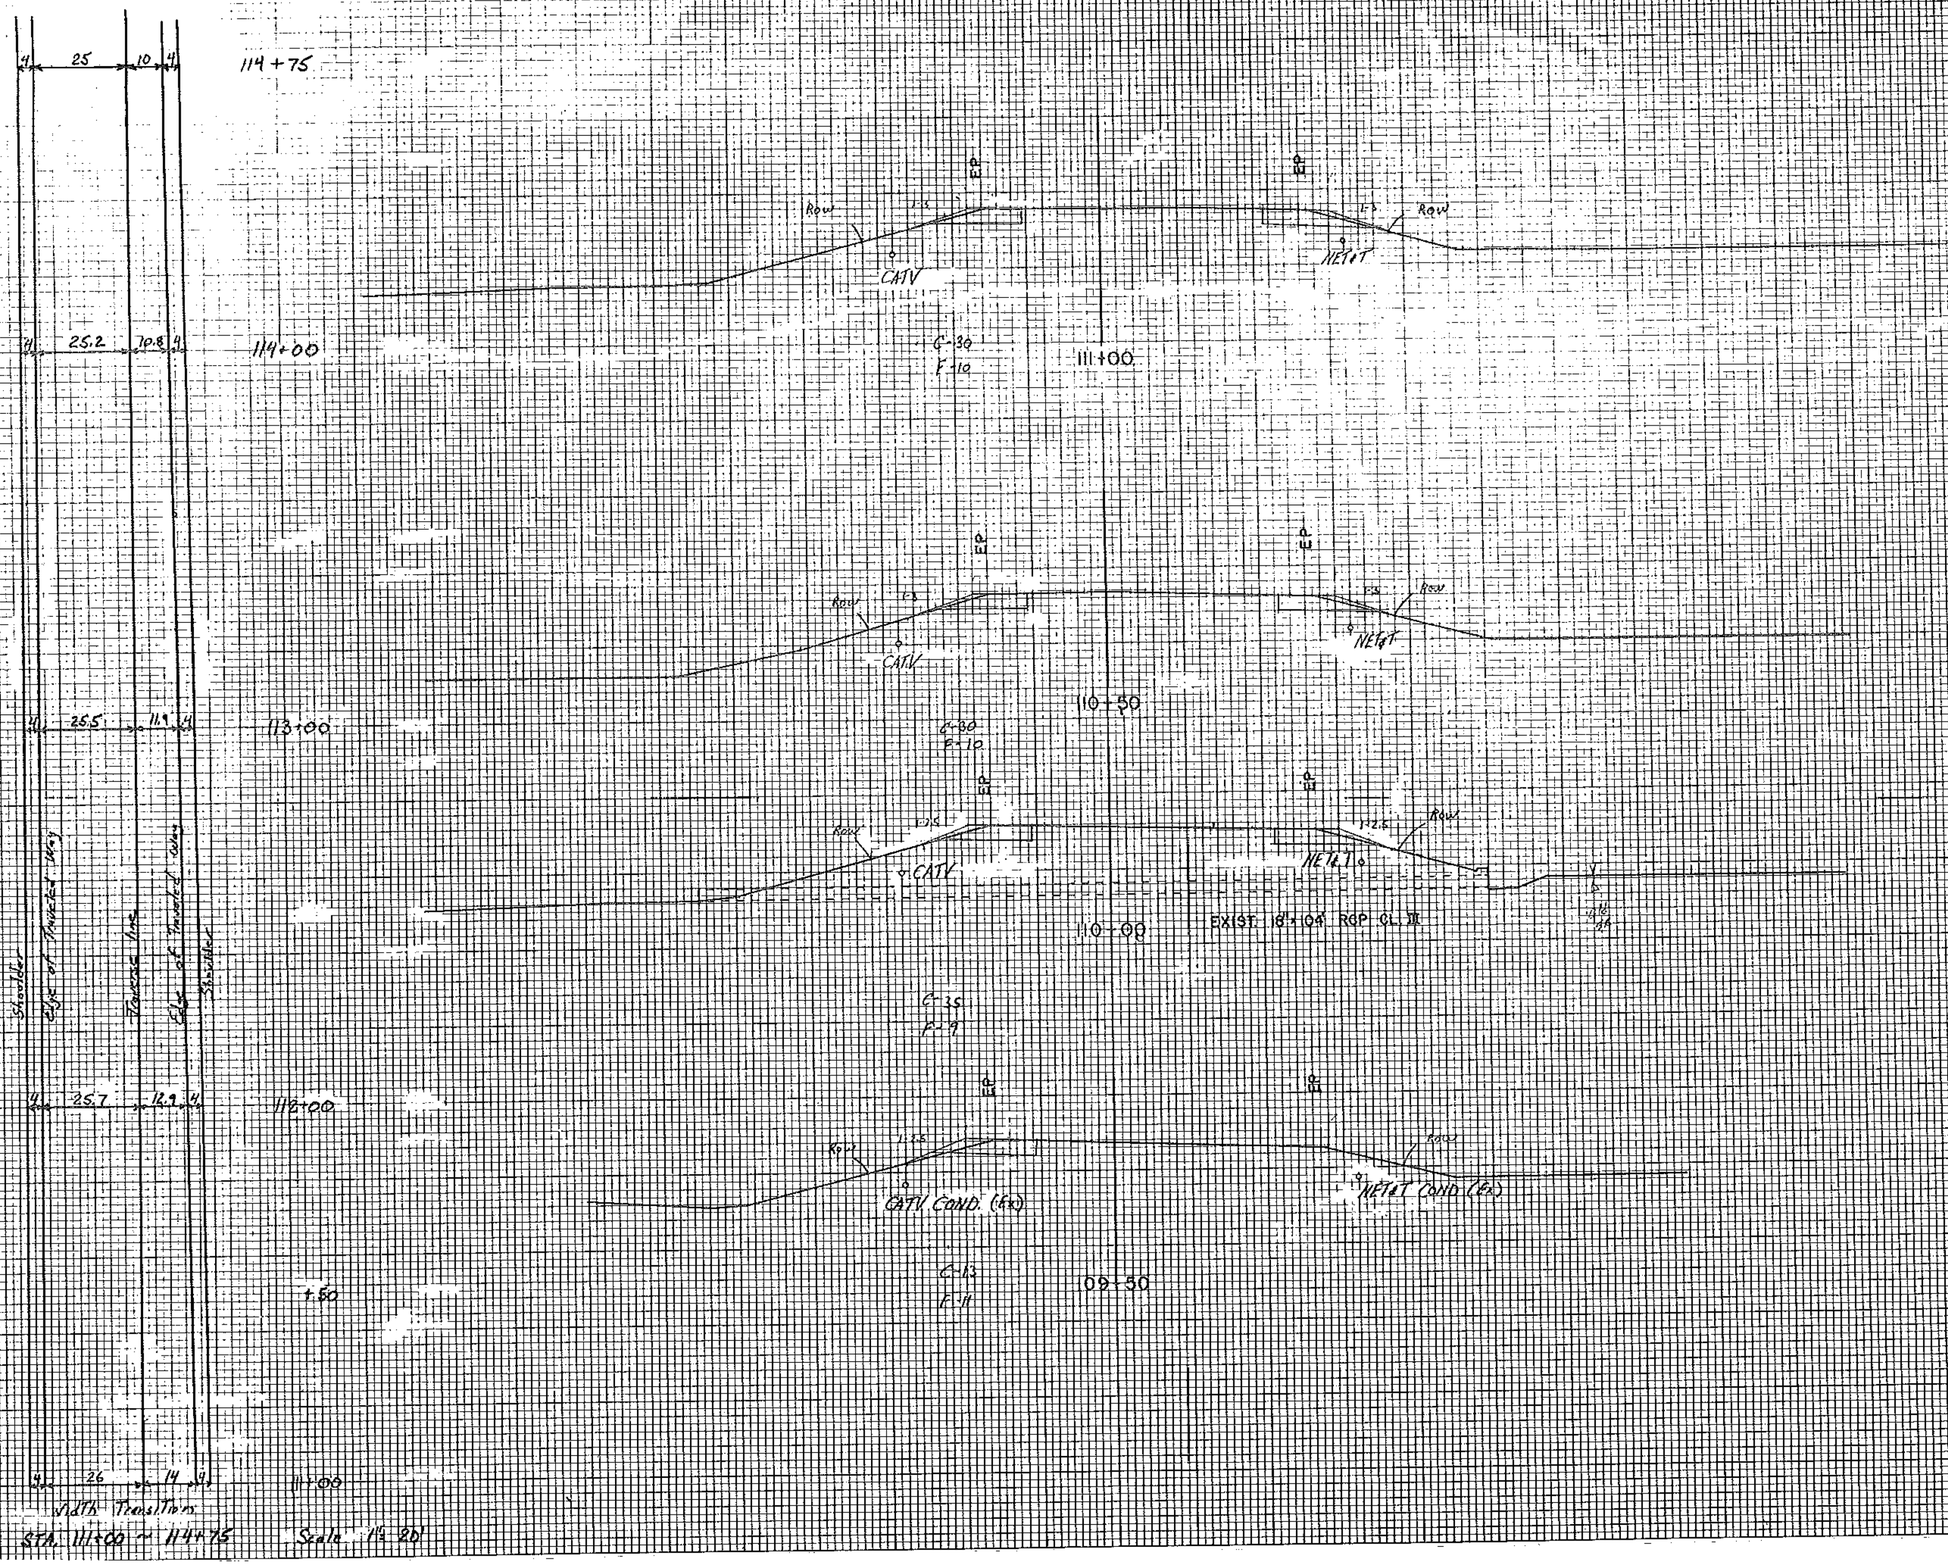

FROM STA. 109+50 TO STA. 114+00
PROJECT NAME COLCHESTER
NO. RS0285(5)
SURVEYED BY
SHEET 52 OF 93 SHEETS