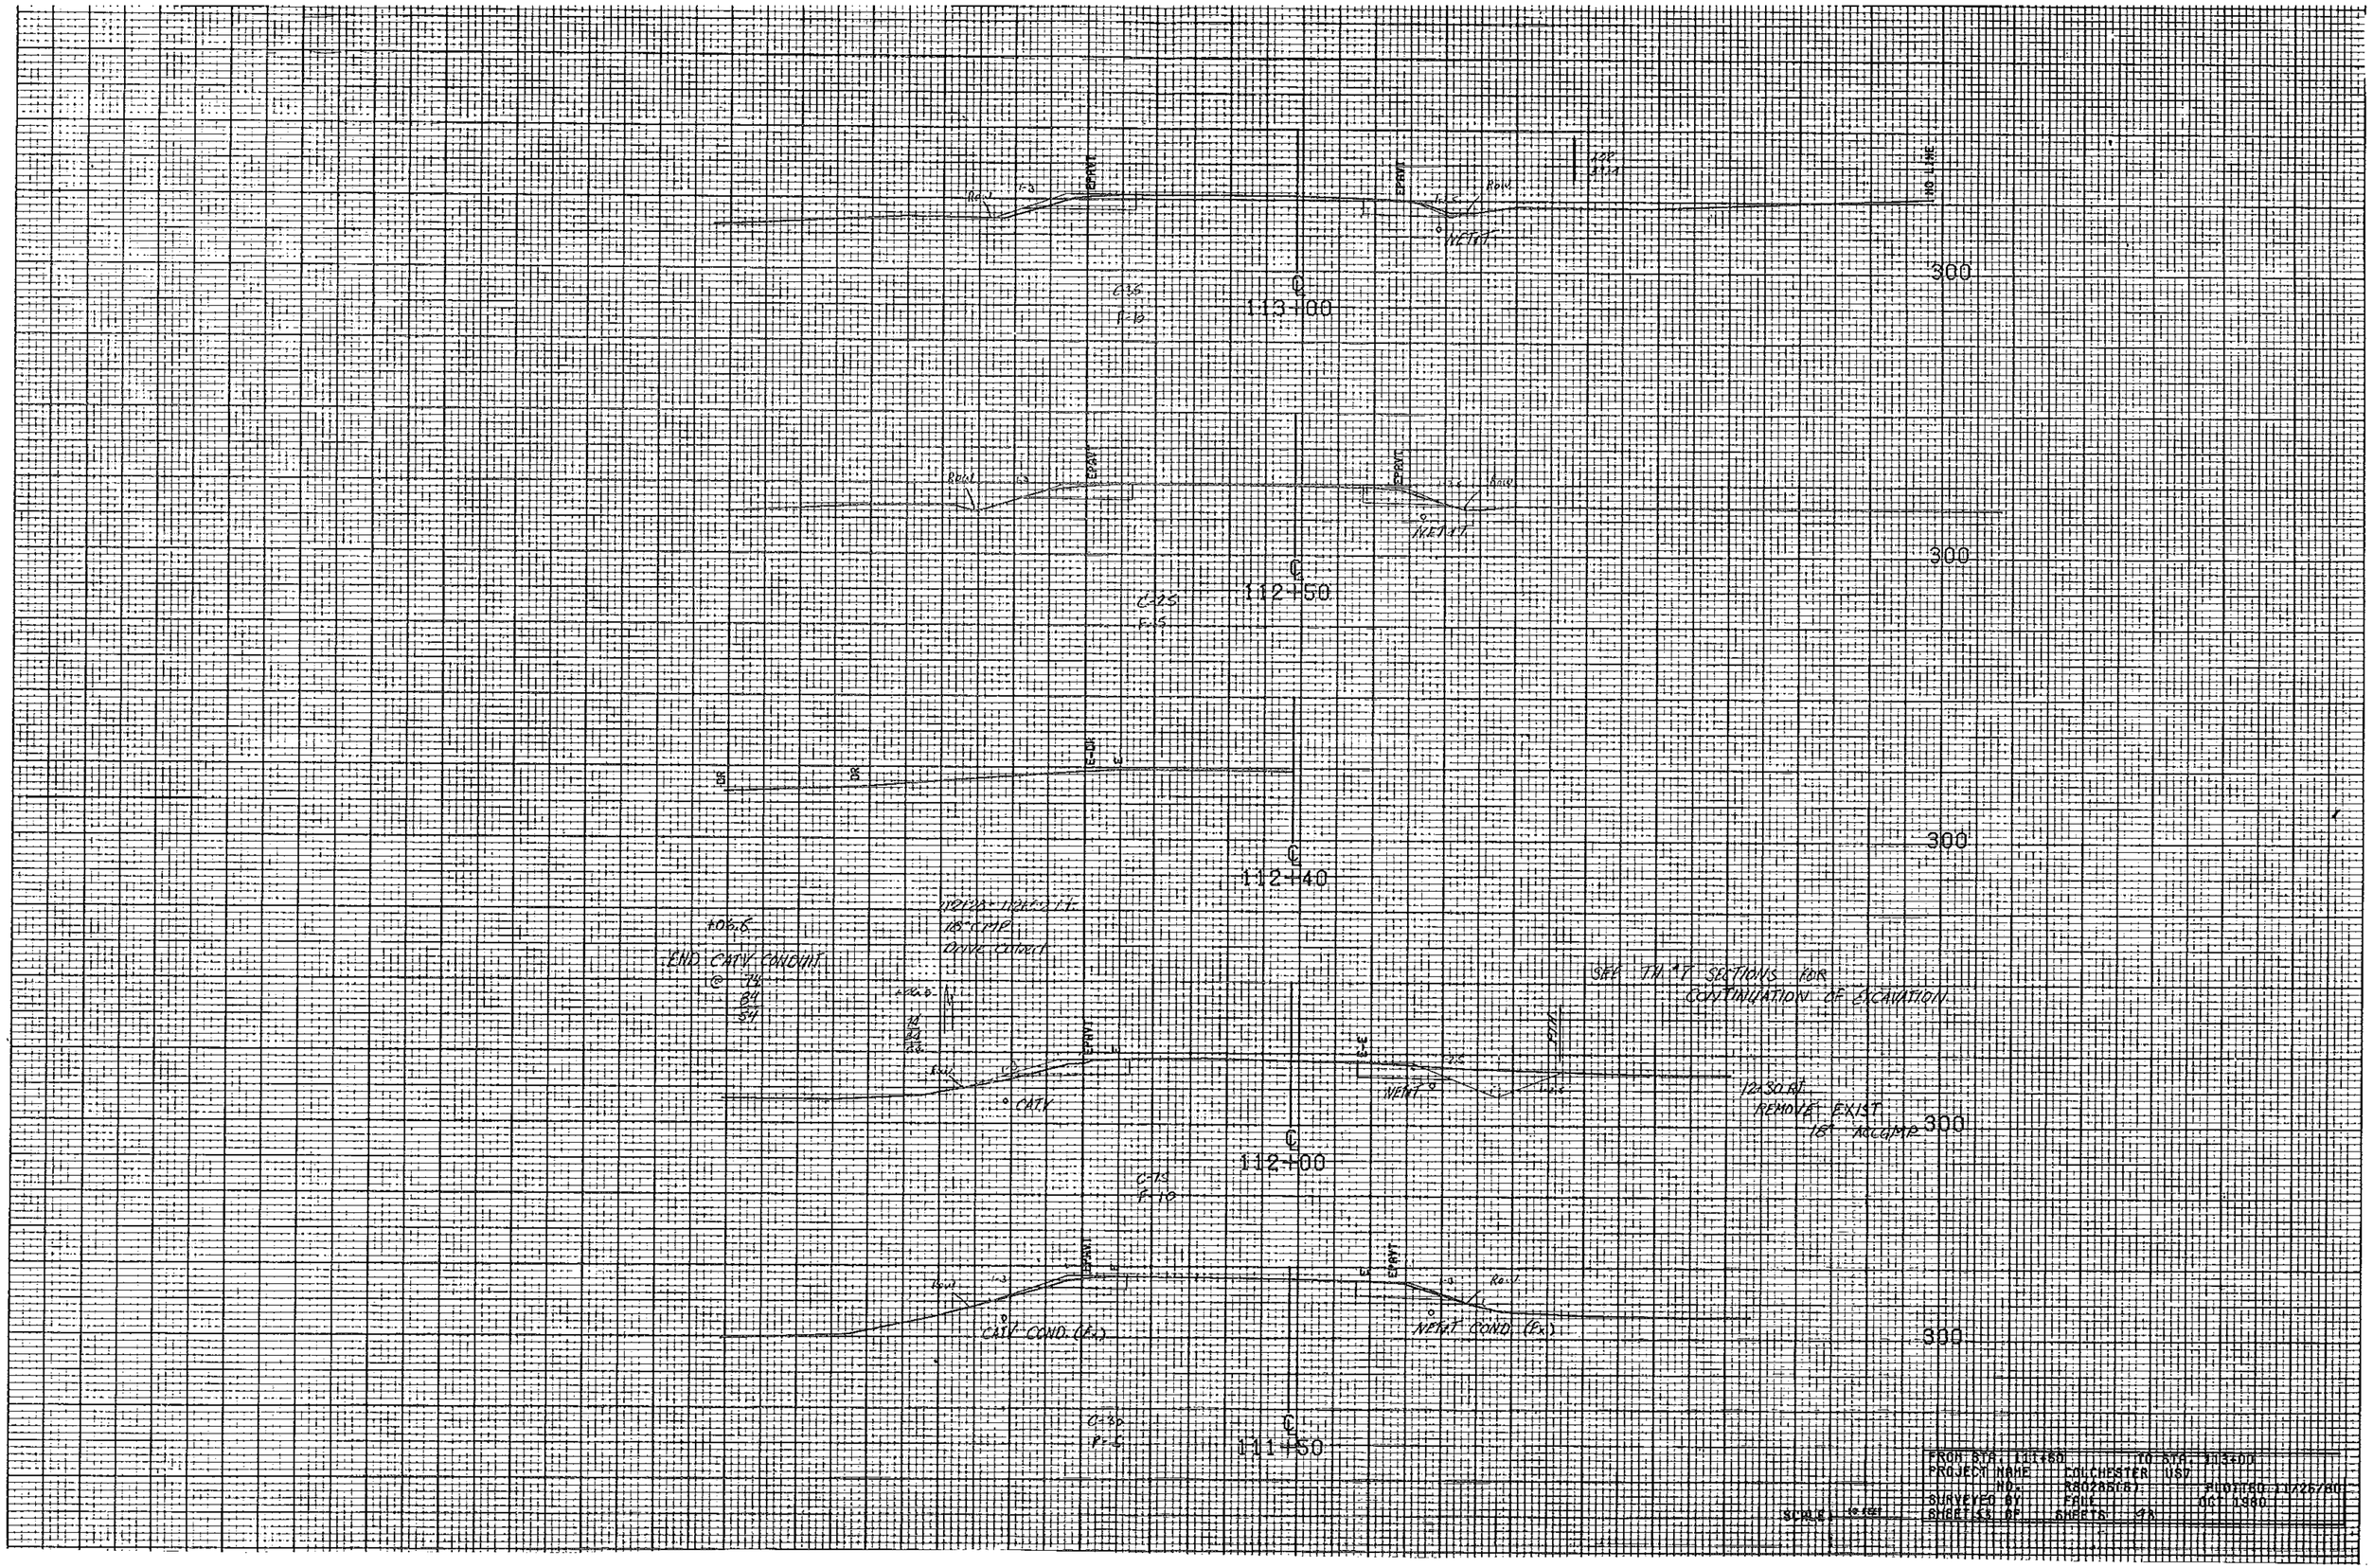
300
113+00
300
112+50
300
112+40
SEE T.H. 17 SECTIONS FOR CONTINUATION OF EXCAVATION
12+30 Rt
REMOVE EXIST 18" ACCMP
300
112+00
300
111+50
FROM STA. 111+60
TO STA. 113+00
PROJECT NAME COLCHESTER USD
NO. R8028B(B)
PLOTTED 11/26/80
SURVEYED BY FRIE
OCT 1980
SHEET 6 OF SHEETS 9A
SCALE: 10 FEET