INDEX OF SHEETS

1	TITLE-QUANTITY	
2	E-10 MINOR MAINTENANCE OPERATION APPROACH SIGNS	8/10/77(R)
3	E-10A MOVING MAINTENANCE OPERATION APPROACH SIGNS	11/18/77(R)
4	G-1-d GUARD RAIL, HEAVY DUTY STEEL BEAM W/WOOD POSTS, TYPE II	9/12/77(R)
5	G-16 STEEL BEAM GUARDRAIL ATTACHMENTS TO EXISTING BRIDGE	2/15/78(R)

RECORD PLANS-MATERIAL SUPPLIERS

CONTRACTOR-VEMONT AGENCY OF TRANSPORTATION, DISTRICT 6 RESIDENT ENGINEER-CARL R. QUESNEL

CONSTRUCTION BEGAN-24 APRIL 1979 COMPLETED-4 MAY 1979 ACCEPTED-20 JULY 1979

GUARD RAIL, ANCHORS FOR GUARD RAIL, TERMINAL CONNECTORS-LAFAYETTE-SHELDON INC., ESSEX JCT., VT.

RECORD PLANS-PAUL E. SINGLETON

NOTE: ANY FURTHER INFORMATION CONCERNING FINAL QUANTITIES, AMOUNTS OR OTHER DETAILS RELATIVE TO THIS PROJECT MAY BE FOUND IN EITHER THE FIELD BOOKS OR THE ESTIMATE FILE.

STATE OF VERMONT
AGENCY OF TRANSPORTATION

PROPOSED IMPROVEMENT
TOWN OF BERLIN
COUNTY OF WASHINGTON
TOWN HIGHWAY NO. 2, CLASS 2

INSTALLATION OF APPROXIMATELY 925'± OF NEW STEEL BEAM GUARD RAIL

IN BERLIN, COMMENCING AT A POINT ON THE NORTHERLY SIDE OF TH 2, AND AT THE WESTERLY END OF BR 29 (THE 3-MILE BRIDGE) AND PROCEEDING EASTERLY FOR 0.163 MILE.

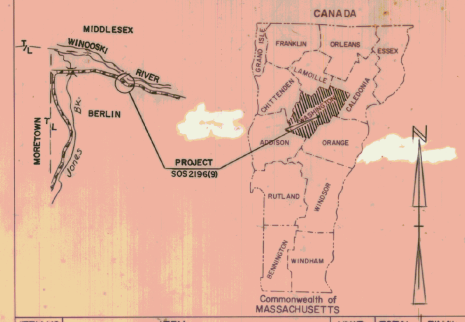

ITEM NO.	ITEM	UNIT	TOTAL	FINAL
621.38	GUARDRAIL, HEAVY DUTY ST. BEAM W/WOOD POSTS, TYPE II	LF	900	933
621.72	ANCHOR FOR ST. BEAM GUARDRAIL W/WOOD POSTS	EA.	2	2
621.74	TERMINAL CONNECTION ANCHOR FOR STEEL BEAM GUARDRAIL	EA.	2	2

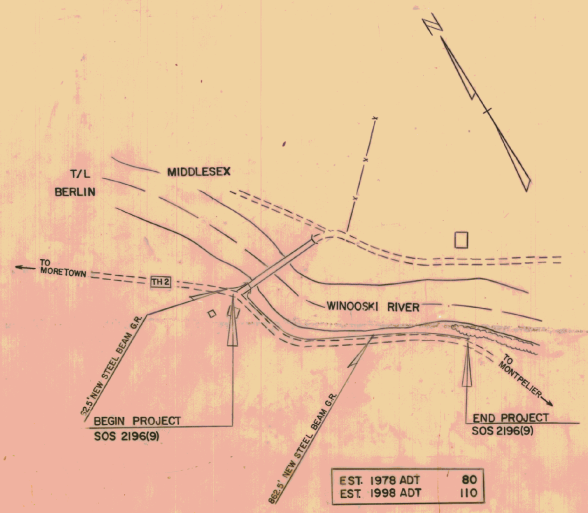

EST. 1978 ADT	80
EST. 1998 ADT	110

CONVENTIONAL SIGNS

COUNTY LINE
TOWN LINE
LIMITS OF ACCESS
POINT OF ACCESS
FENCE LINE
STONE WALL
TRAVELED WAY
GUARD RAIL
RAILROAD
SURVEY LINE
CULVERT
POWER POLE
TELEPHONE POLE
TREES
F.A. CONST. IDENTIFICATION SIGNS
PROPERTY LINE
R.O.W. TAKING LINE
SLOPE RIGHT
TOP OF
TOE OF

SUBMITTED BY ORDER OF THE STATE TRANSPORTATION BOARD

APPROVED _____ DATE _____
DIRECTOR OF ENGINEERING AND CONSTRUCTION

APPROVED _____ DATE _____
RIGHT OF WAY DIRECTOR

DEPARTMENT OF TRANSPORTATION
FEDERAL HIGHWAY ADMINISTRATION

STATE OF VERMONT
DEPARTMENT OF HIGHWAYS

TOWN OF BERLIN RTE. NO. T.H. 2
BRIDGE NO.
LOG STA.
SURV. STA.

DESIGNED BY _____ DATE _____
DRAWN BY R. BRUNELLE DATE 4/78
CHECKED BY _____ DATE _____
DESIGN SUPERVISOR DATE _____
SOS NO. 2196(9)