




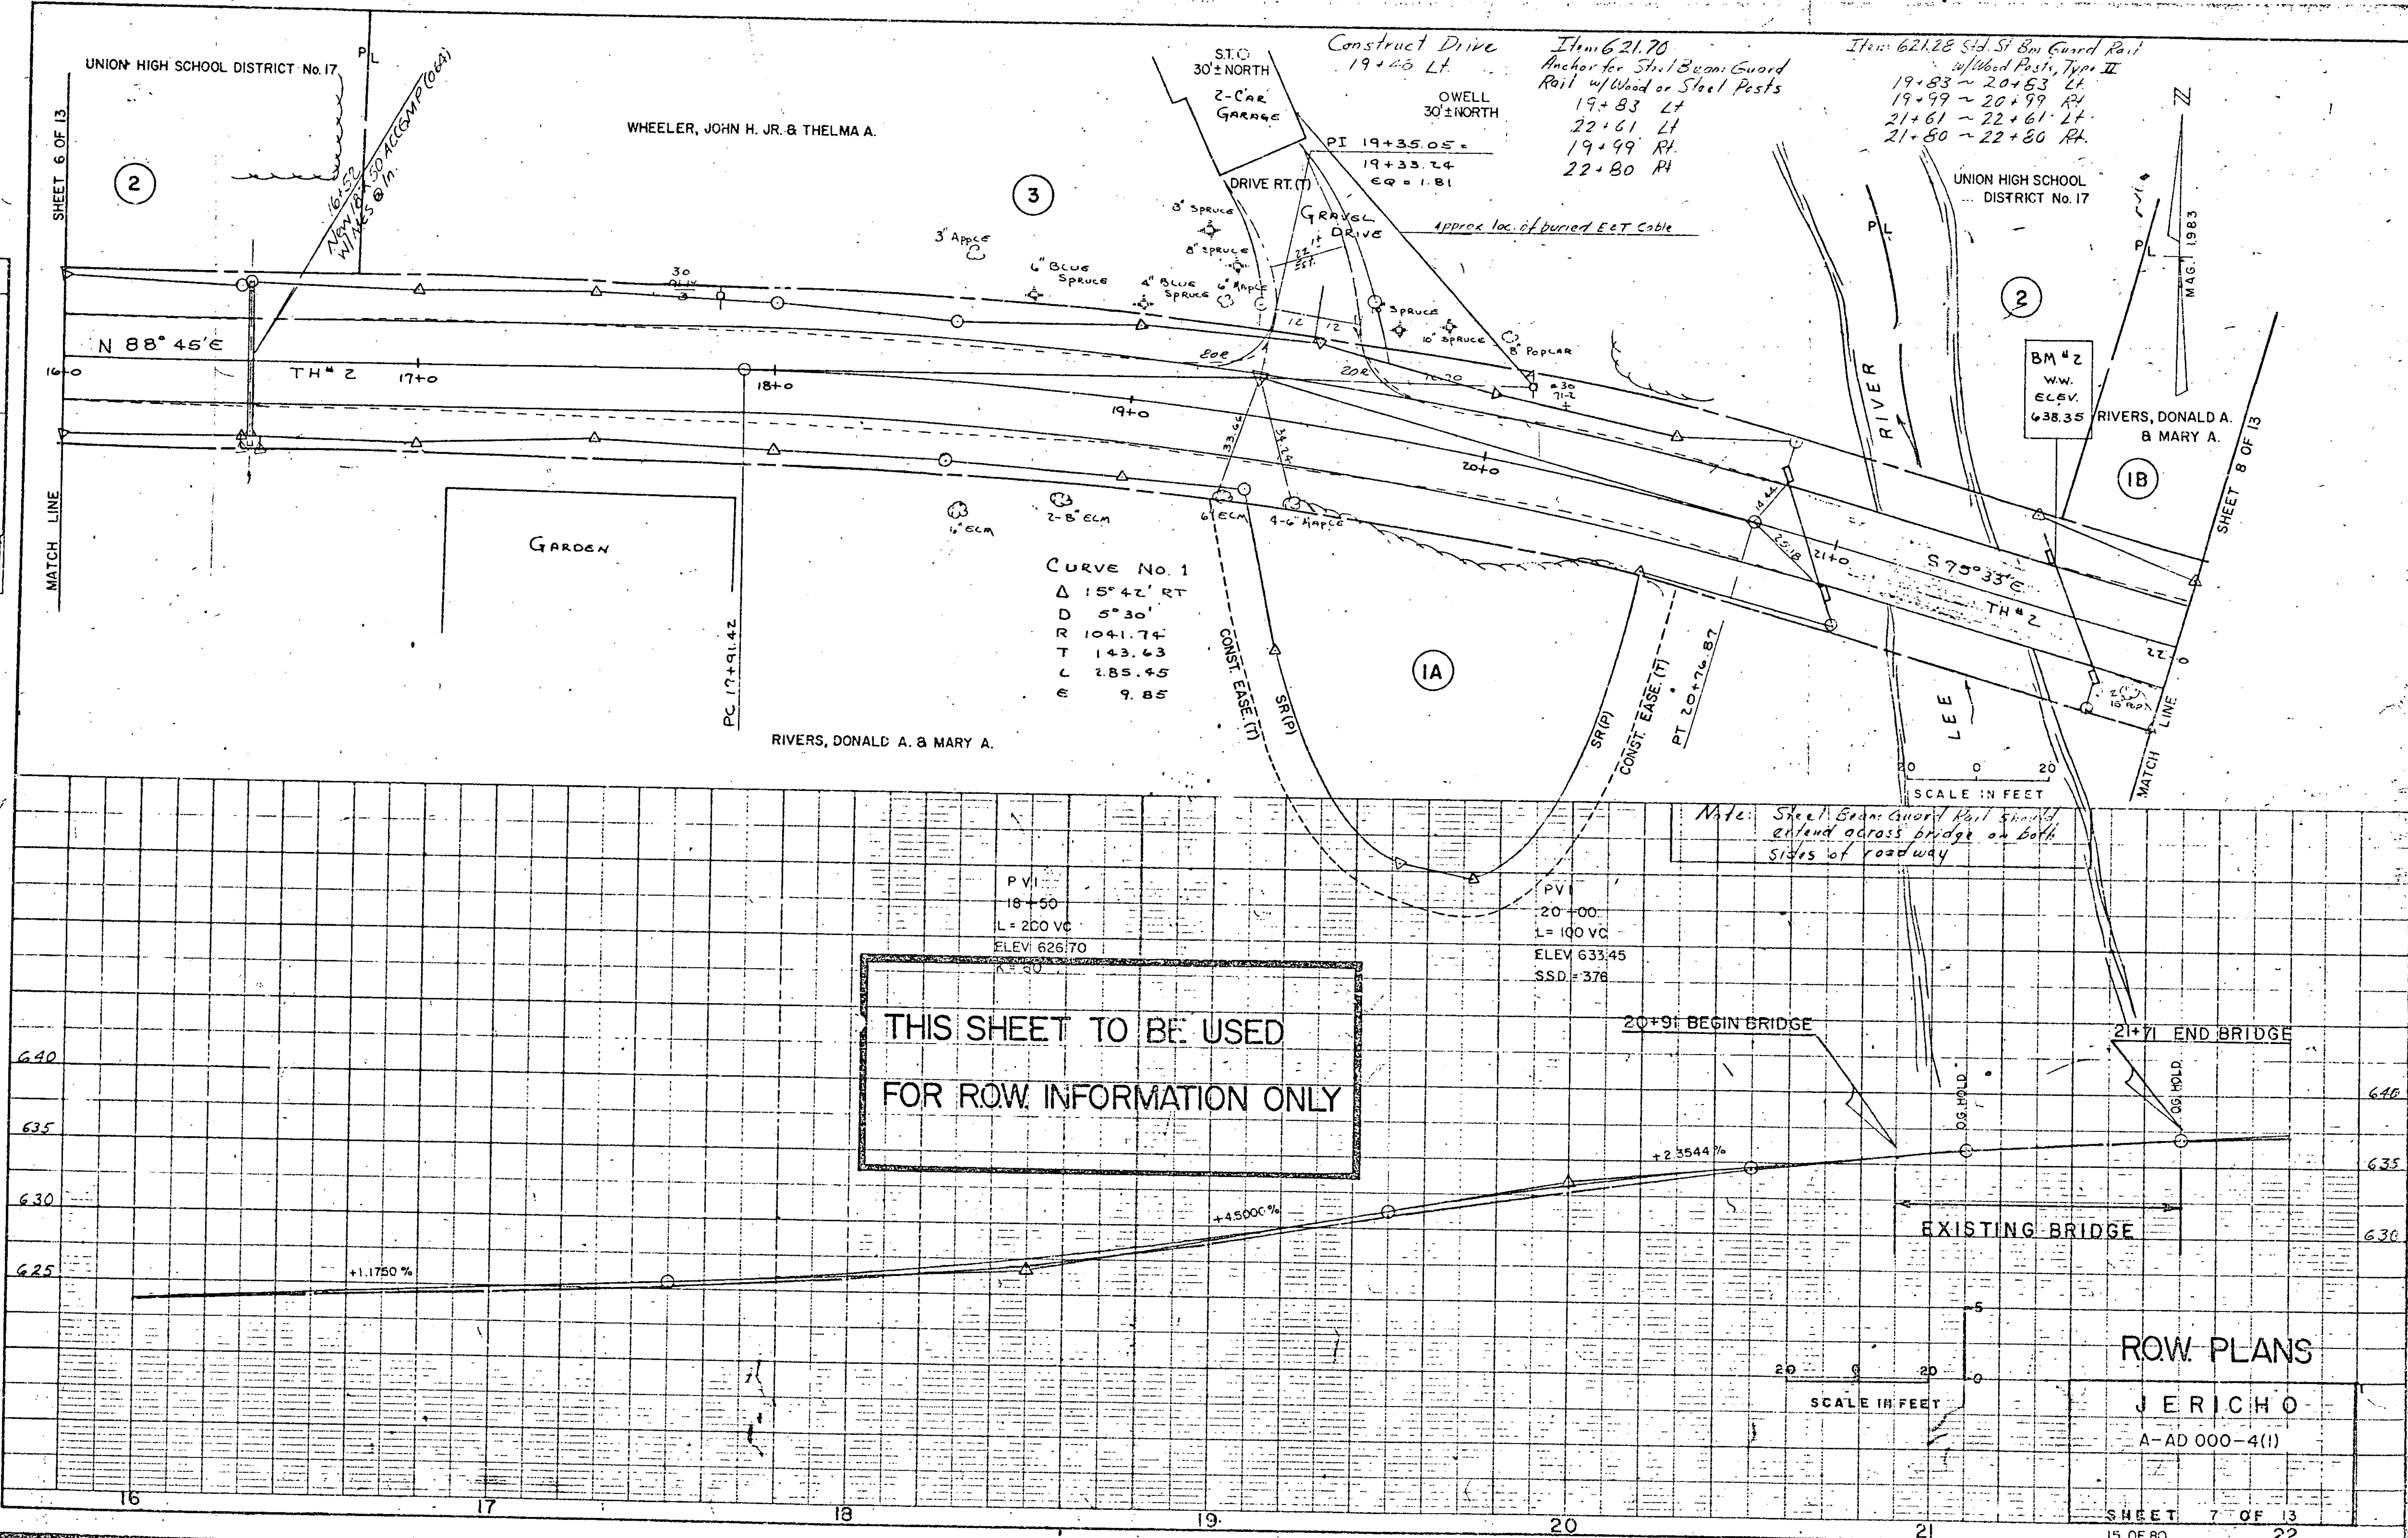

THIS SHEET TO BE USED
FOR ROW INFORMATION ONLY

Note: Steel Beam Guard Rail should extend across bridge on both sides of roadway

CURVE NO. 1
 Δ 15° 42' RT
 D 5° 30'
 R 1041.74
 T 143.63
 L 285.45
 E 9.85

PVI
 18+50
 L=200 VC
 ELEV: 626.70

PVI
 20+00
 L=100 VC
 ELEV: 633.45
 SSD=376

20+91 BEGIN BRIDGE

21+71 END BRIDGE

EXISTING BRIDGE

ROW PLANS

JERICHO
 A-AD 000-4(1)

SHEET 7 OF 13
 15 OF 80