


PLAN  
 NOTE BOOK  
 No. 1-23

PROFILE  
 NOTE BOOK  
 No. 1-23

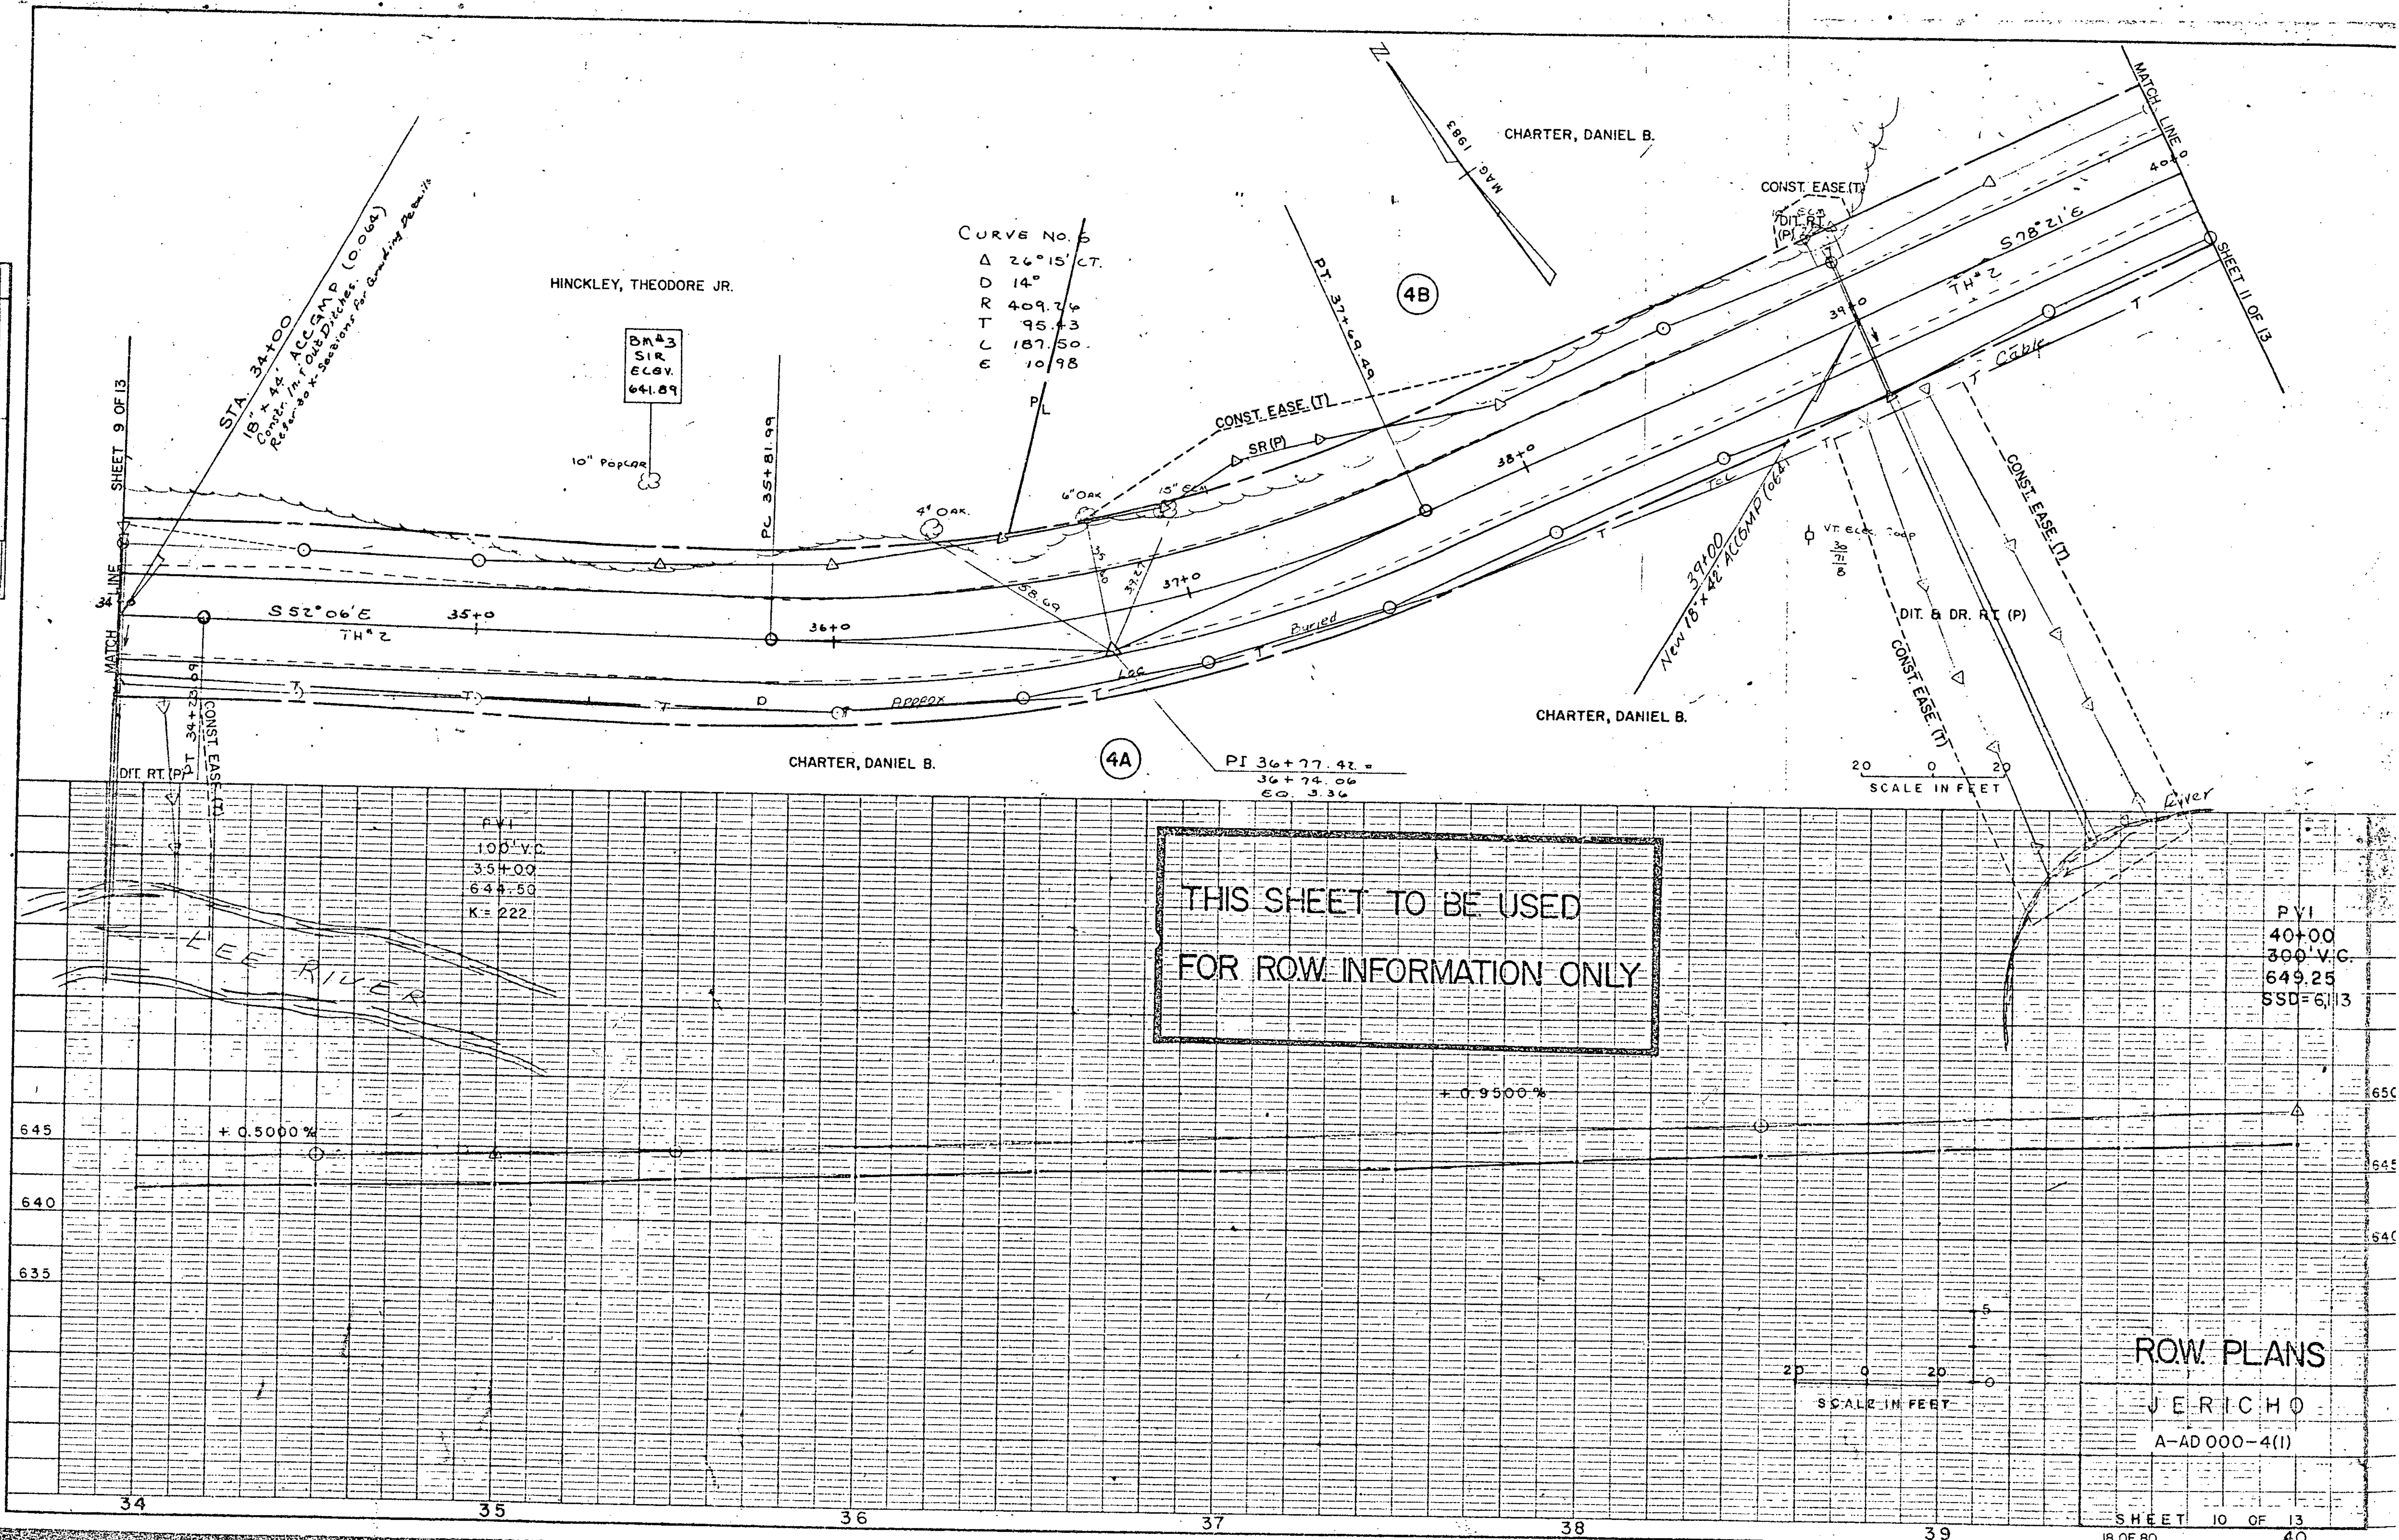

CURVE NO. 5  
 $\Delta$  26° 15' CT.  
 D 14°  
 R 409.74  
 T 95.73  
 L 187.50  
 E 10.98

HINKLEY, THEODORE JR.

BM 43  
 SIR  
 ELEV.  
 641.89

CHARTER, DANIEL B.

CHARTER, DANIEL B.

THIS SHEET TO BE USED  
 FOR ROW INFORMATION ONLY

PVI  
 100' V.C.  
 35+00  
 644.50  
 K = 222

PI 36+77.42 =  
 36+74.06  
 60.336

PVI  
 40+00  
 300' V.C.  
 649.25  
 SSD=6113

ROW PLANS  
 JERICHO  
 A-AD 000-4(1)