END R.O.W. PROJECT
A-AD 000-4(1) STA. 52+50 ℄

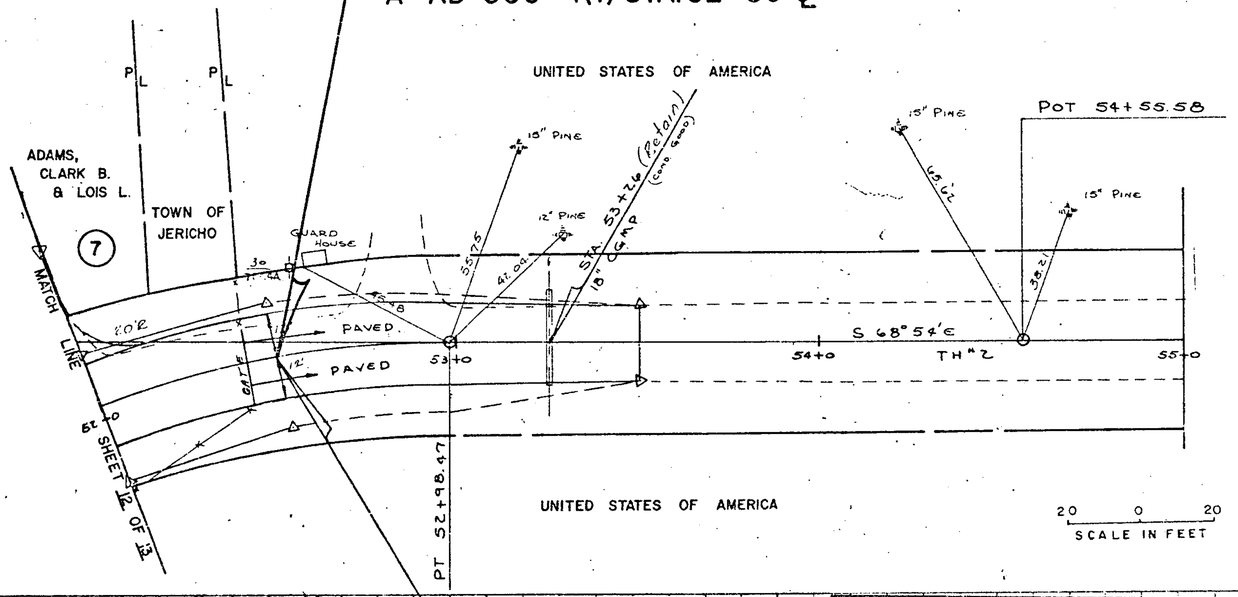

52+50
END CONSTRUCTION
CONSTRUCT SATISFACTORY
APPROACH

Check Existing Grades

THIS SHEET TO BE USED
FOR ROW INFORMATION ONLY

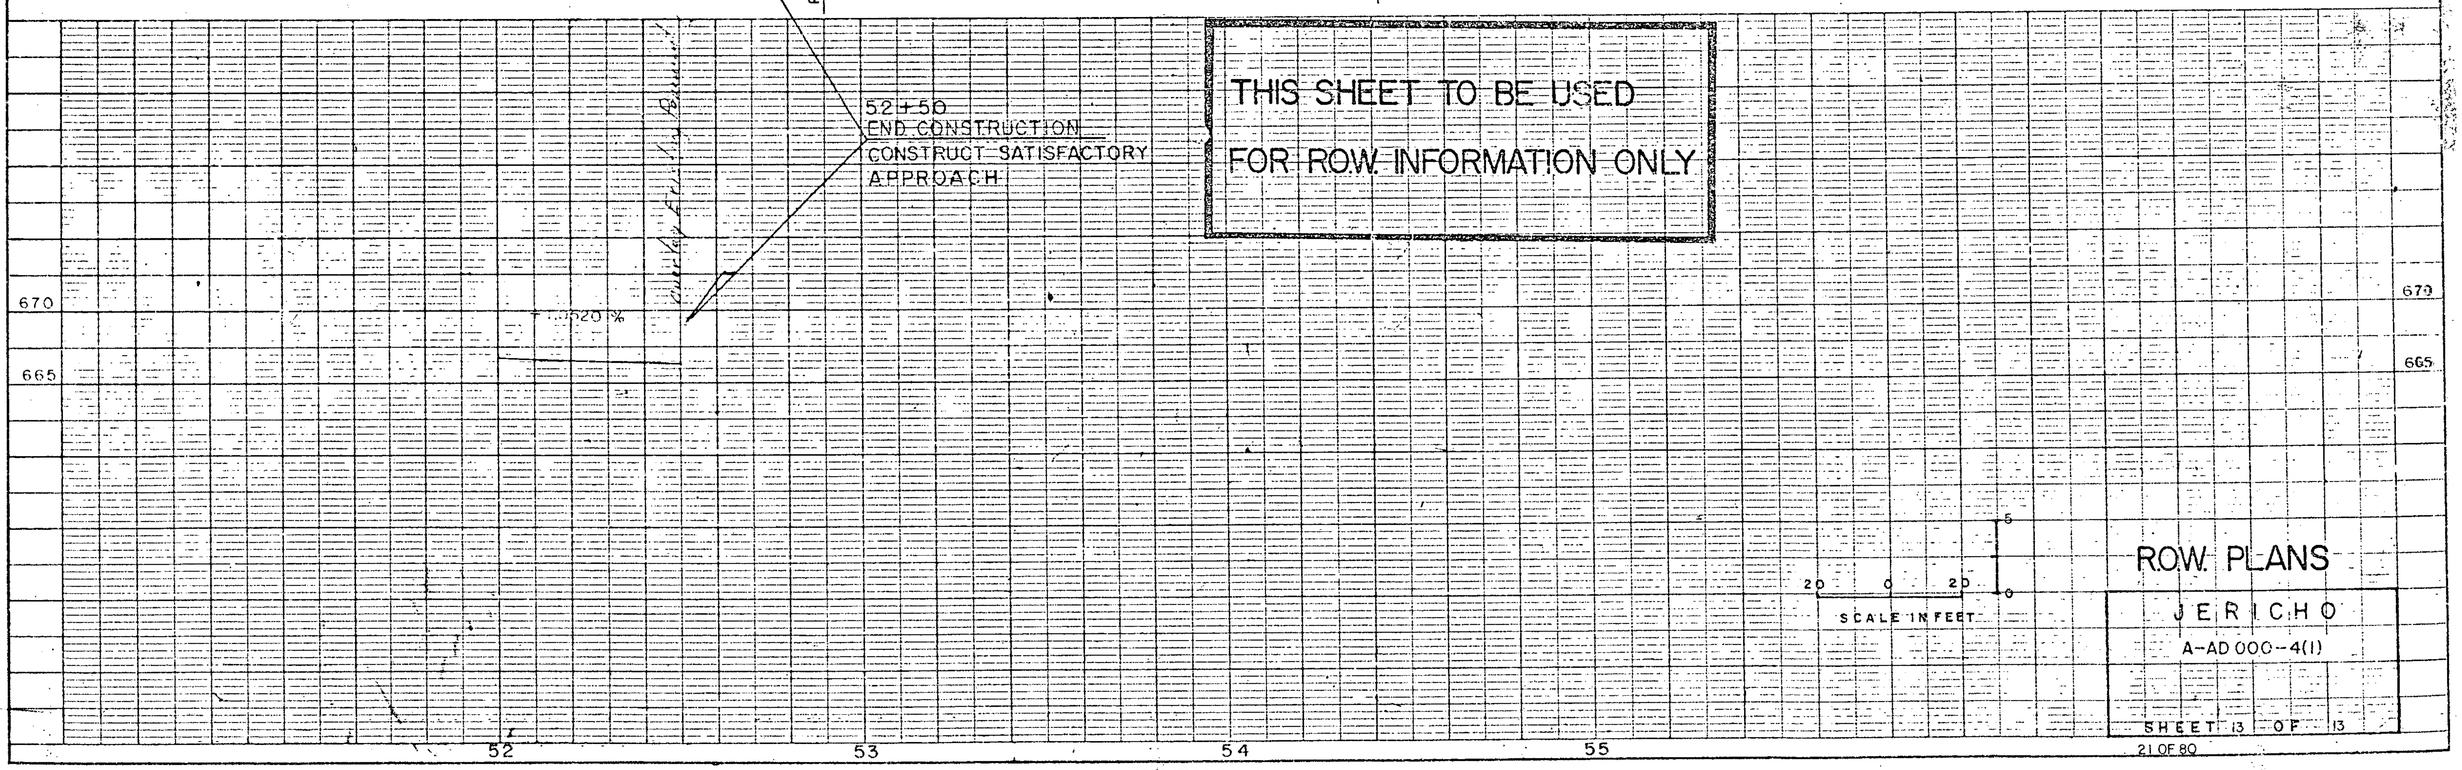

ROW PLANS
JERICHO
A-AD 000-4(1)
SHEET 13 OF 13

PLAN
NOTE BOOK
No.
SURVEYED
PLOTTED
ALIGNMENT CHECKED
R.L. OF MAT CHECKED
BY
DATE
S.A.V.A.L. C.N.S.
G.R.J.N.D.S.D.A.D.
1-29-83
2-2-83

PROFILE
NOTE BOOK
No.
SURVEYED
PLOTTED
GRADES CHECKED
B.M.'s NOTED
STRUCTURE DATA CHECKED
BY
CARPENTER
CARPENTER
DATE
1-31-83

K+E PLATE 1, PLAN-PROFILE
KEUFFEL & ESSER CO.