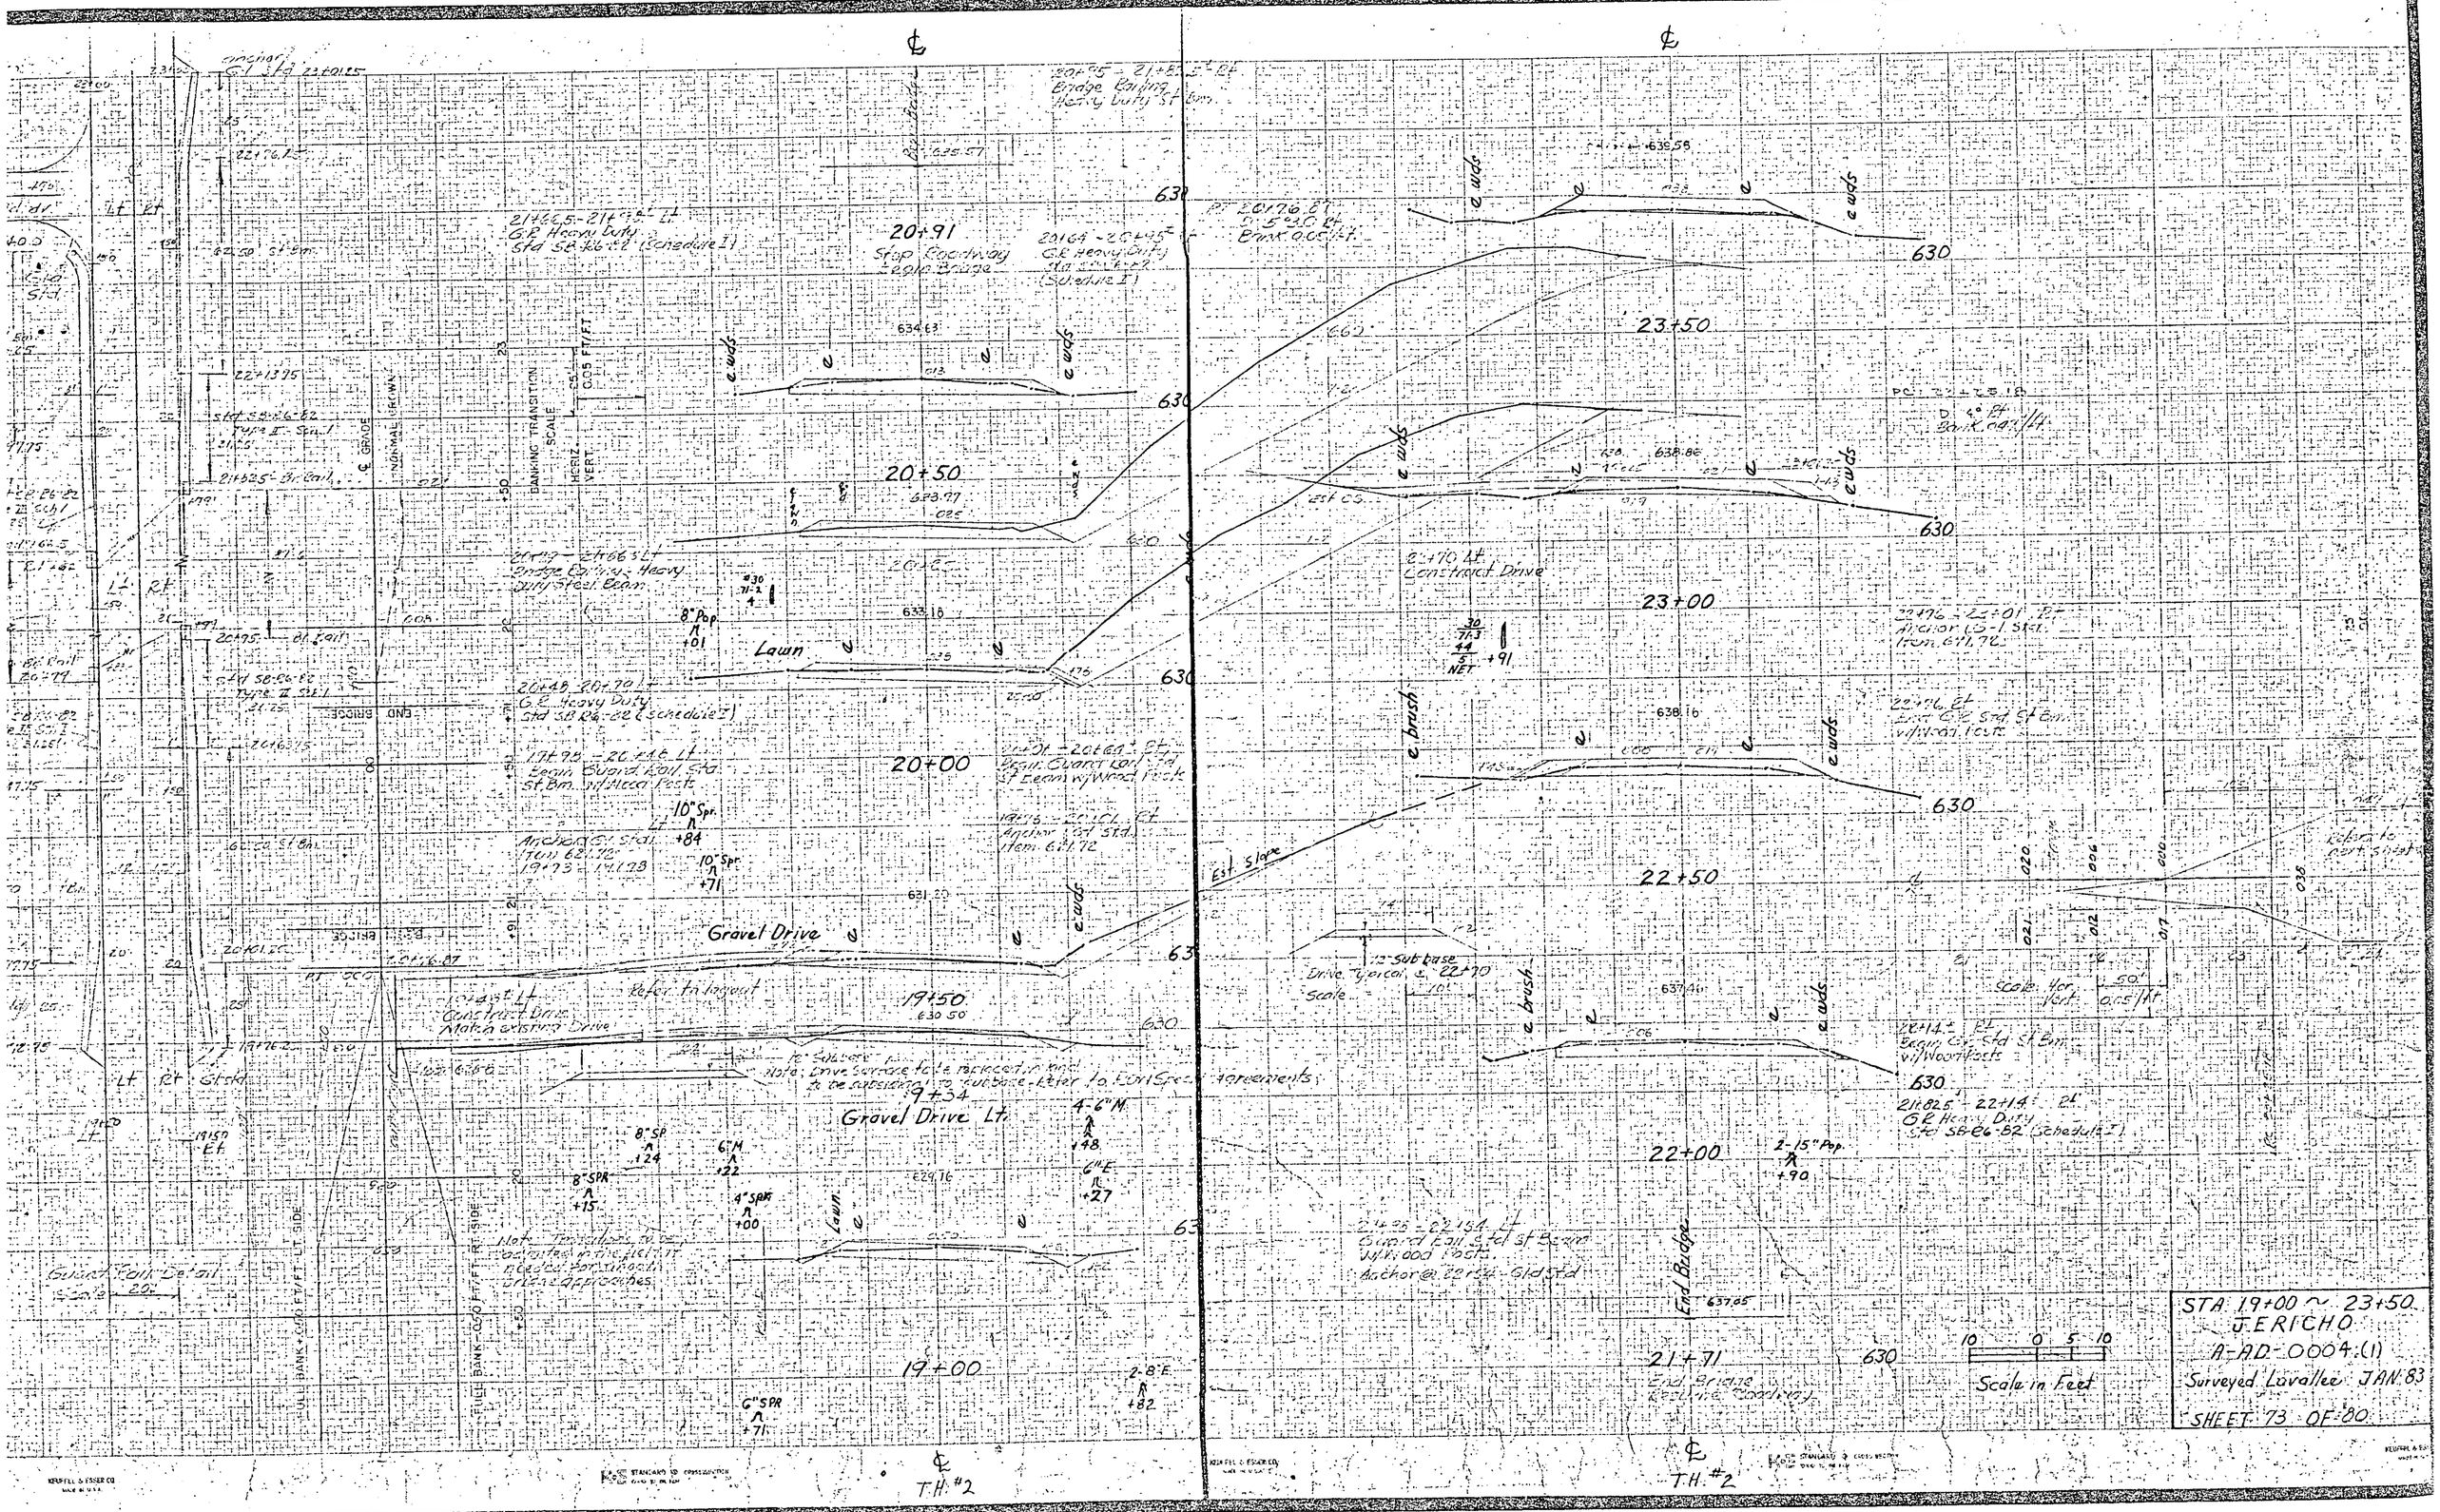
STA 19+00 ~ 23+50
JERICHO
A-AD-0004(1)
Surveyed Lavallee JAN 83
SHEET 73 OF 80
Scale in feet
Scale: Hor. 1"=50'
Vert. 0.05'/ft.
20+91
Stop Roadway
20+50
20+00
19+50
19+34
Gravel Drive Lt.
Gravel Drive
Lawn
19+00
20+76 Rt
Bank 0.05'/ft.
23+50
23+00
22+50
22+00
21+71
End Bridge
Constructed Drive
Est. Slope
Drive Typical
Scale
Refer to layout
Match existing Drive
Note: Drive surface to be packed in kind & the subbase and subbase-refer to Lot Sheet for agreements
Guard Rail Detail
Scale
Note: Turnouts to be located in the field if needed for smooth grades approaches
Return to next sheet
T.H. #2