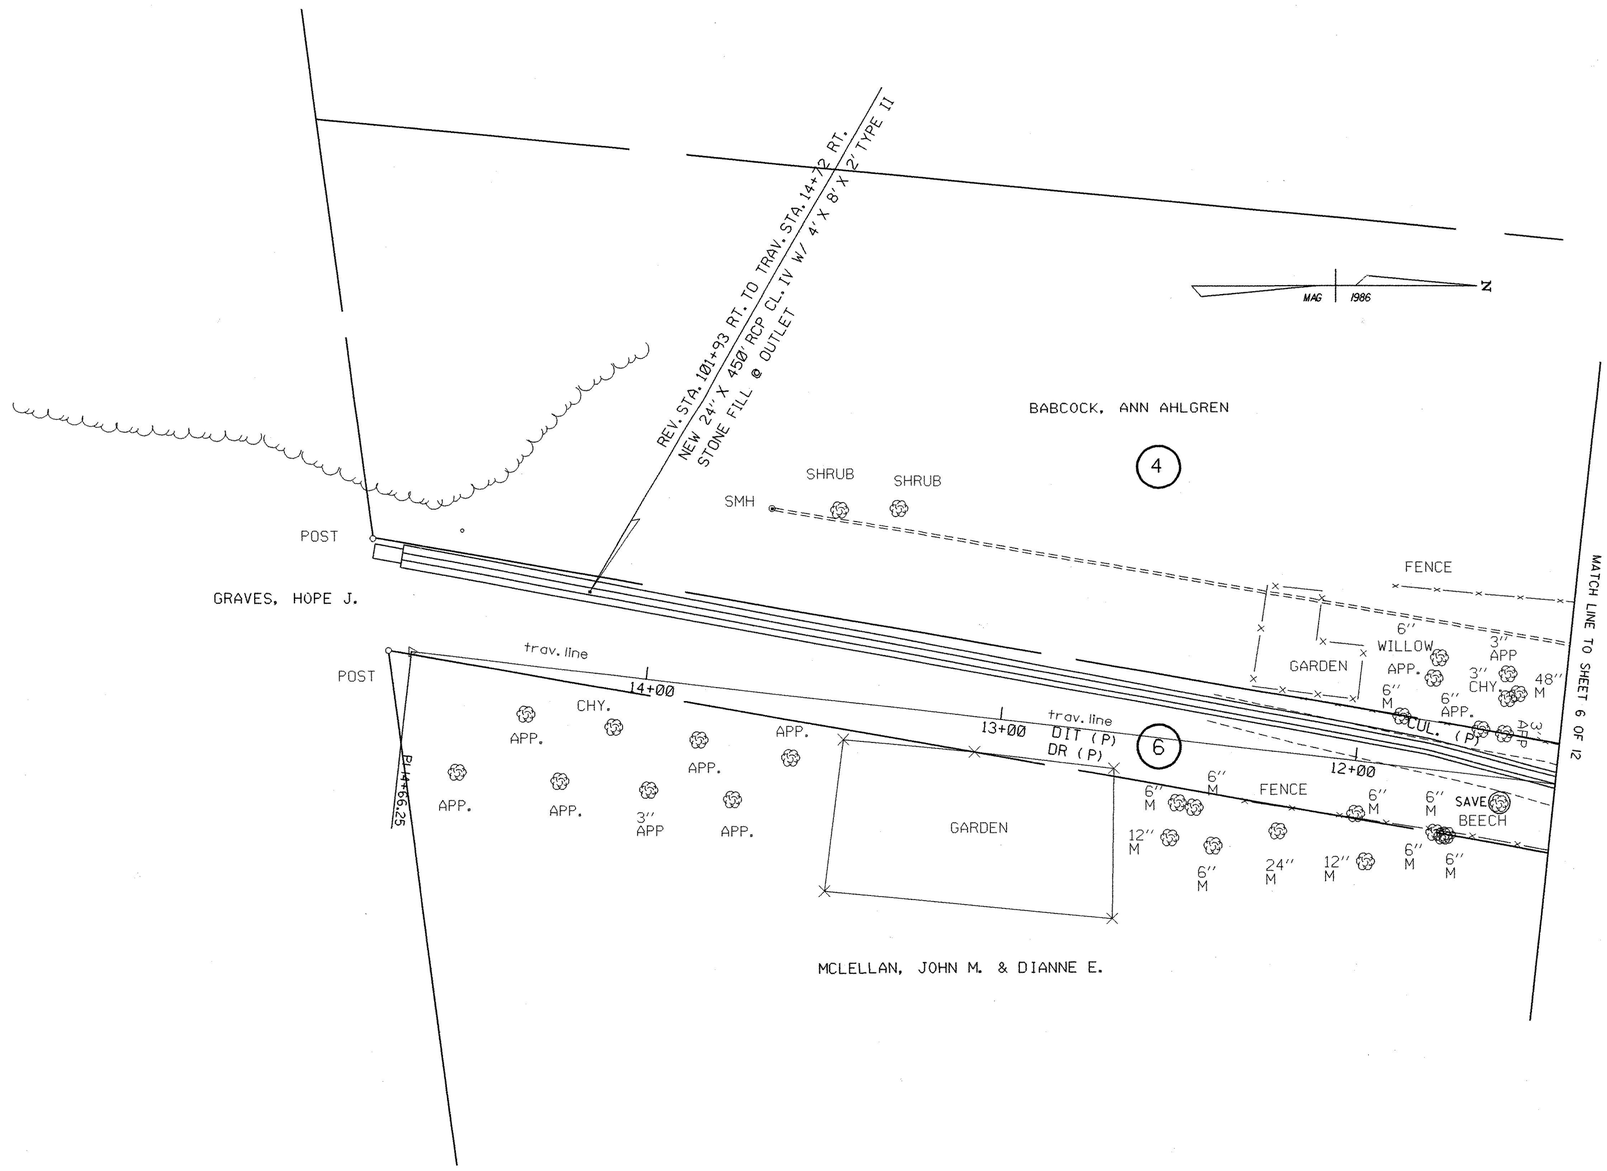

NOTE: TEMPORARY EROSION CONTROL METHODS AS PER STANDARD SHEETS T-1 & T-2 ARE TO BE USED ON THIS PROJECT AS APPROVED AND DIRECTED BY THE ENGINEER.

0 20 40
SCALE IN FEET

FOR R.O.W. USE ONLY

SURVEYED BY	R. MOREAU	DATE	8/11/93
DRAWN BY	A. JONES	DATE	8/93
SQUAD LEADER	S. MENARD		
DESIGN FILE NO.	/prop/84d714/rd714zzz.dgn		
IPARM FILE	rd71414r.i	DATE PLOTTED	28-APR-1999

OLD BENNINGTON
M 1400(4) S

R. O. W. SHEET 8 OF 12 SHEETS
SHEET 14 OF 63 SHEETS

DATUM	
VERTICAL	NGVD 1929
HORIZONTAL	N/A