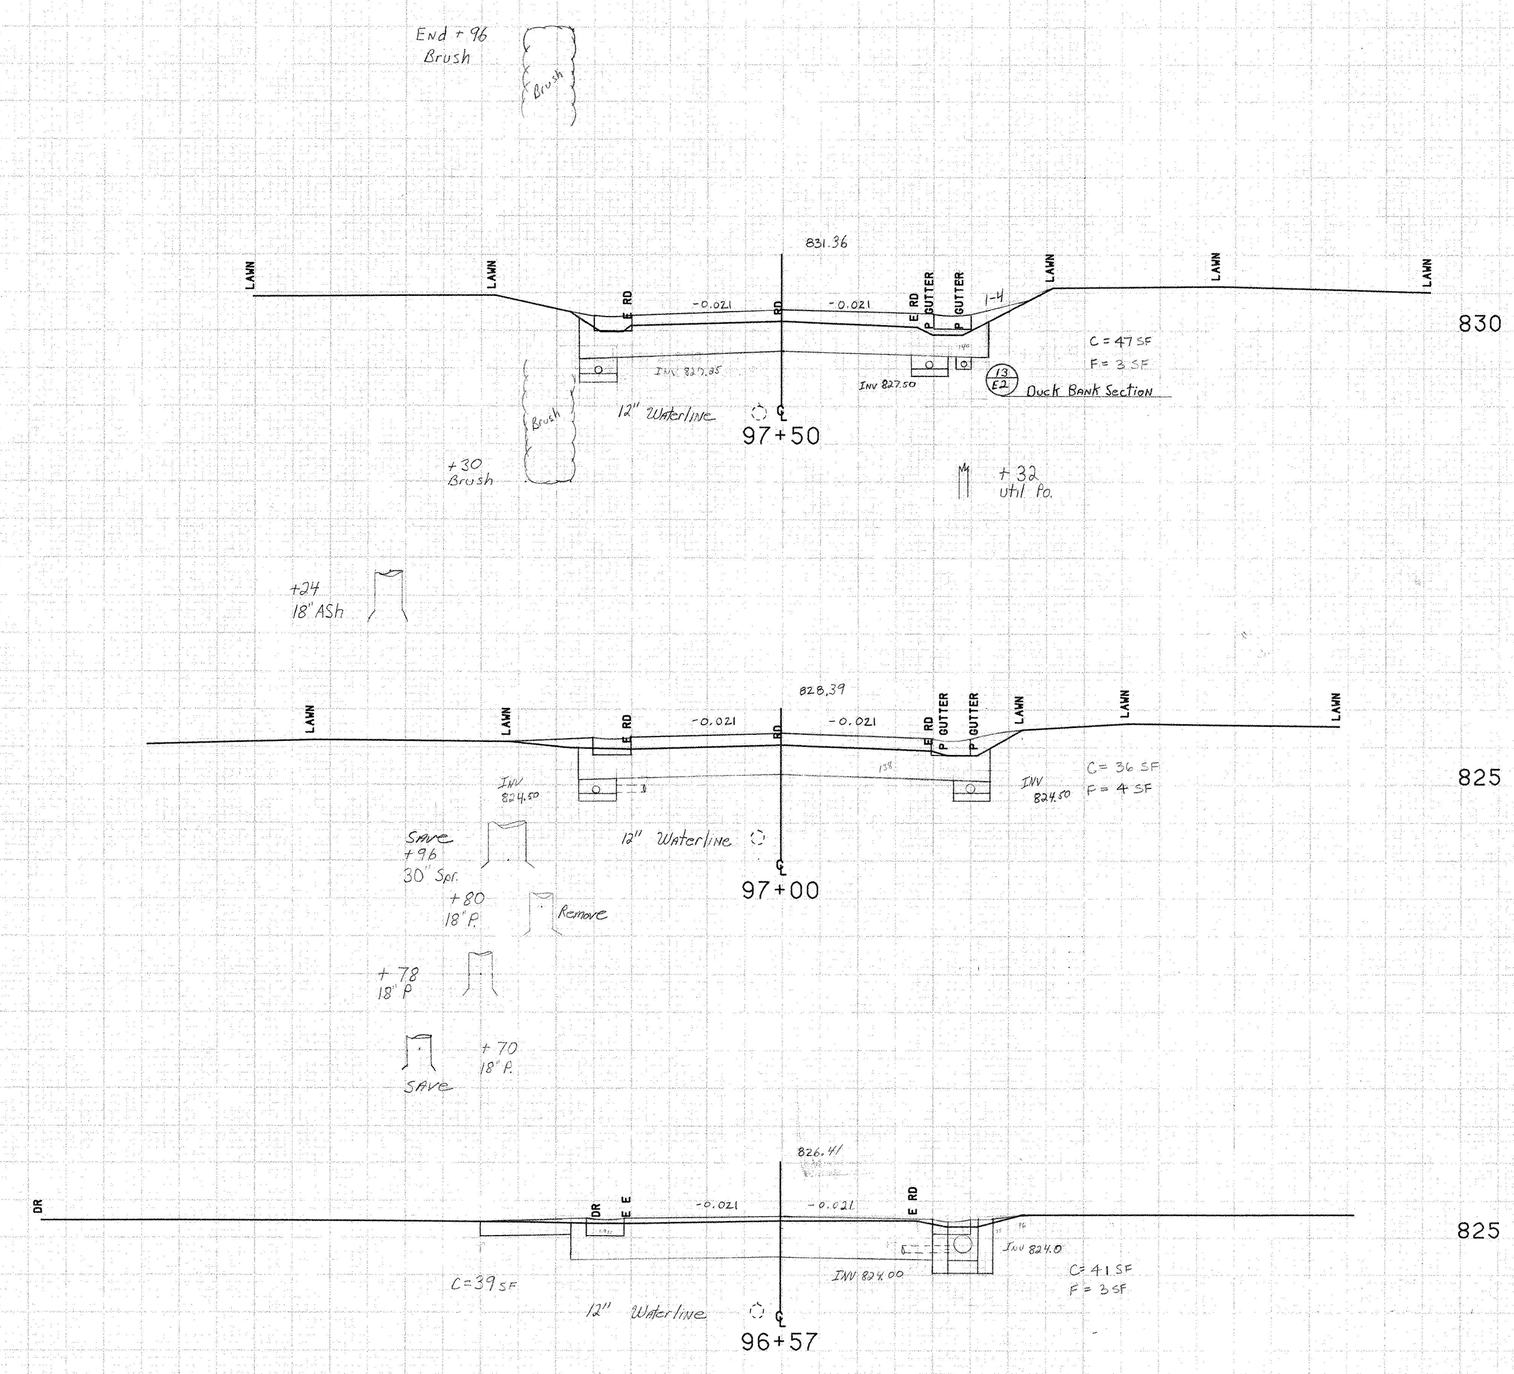

Note: Underdrain offset may be Adjusted As Needed to Avoid Conflict With Utilities As Approved by the Engineer.

Note: Bricks may be omitted from DI As Needed for Clearance over Culvert.

SCALE 5 FEET

FROM STA. 96+57	TO STA. 97+50	
PROJECT NAME	OLD BENNINGTON MAIN	
NO.	M1400(4)S	PLOTTED 06/15/93
SURVEYED BY	MOREAU	01/90 0294
SHEET 41 OF 63 SHEETS		