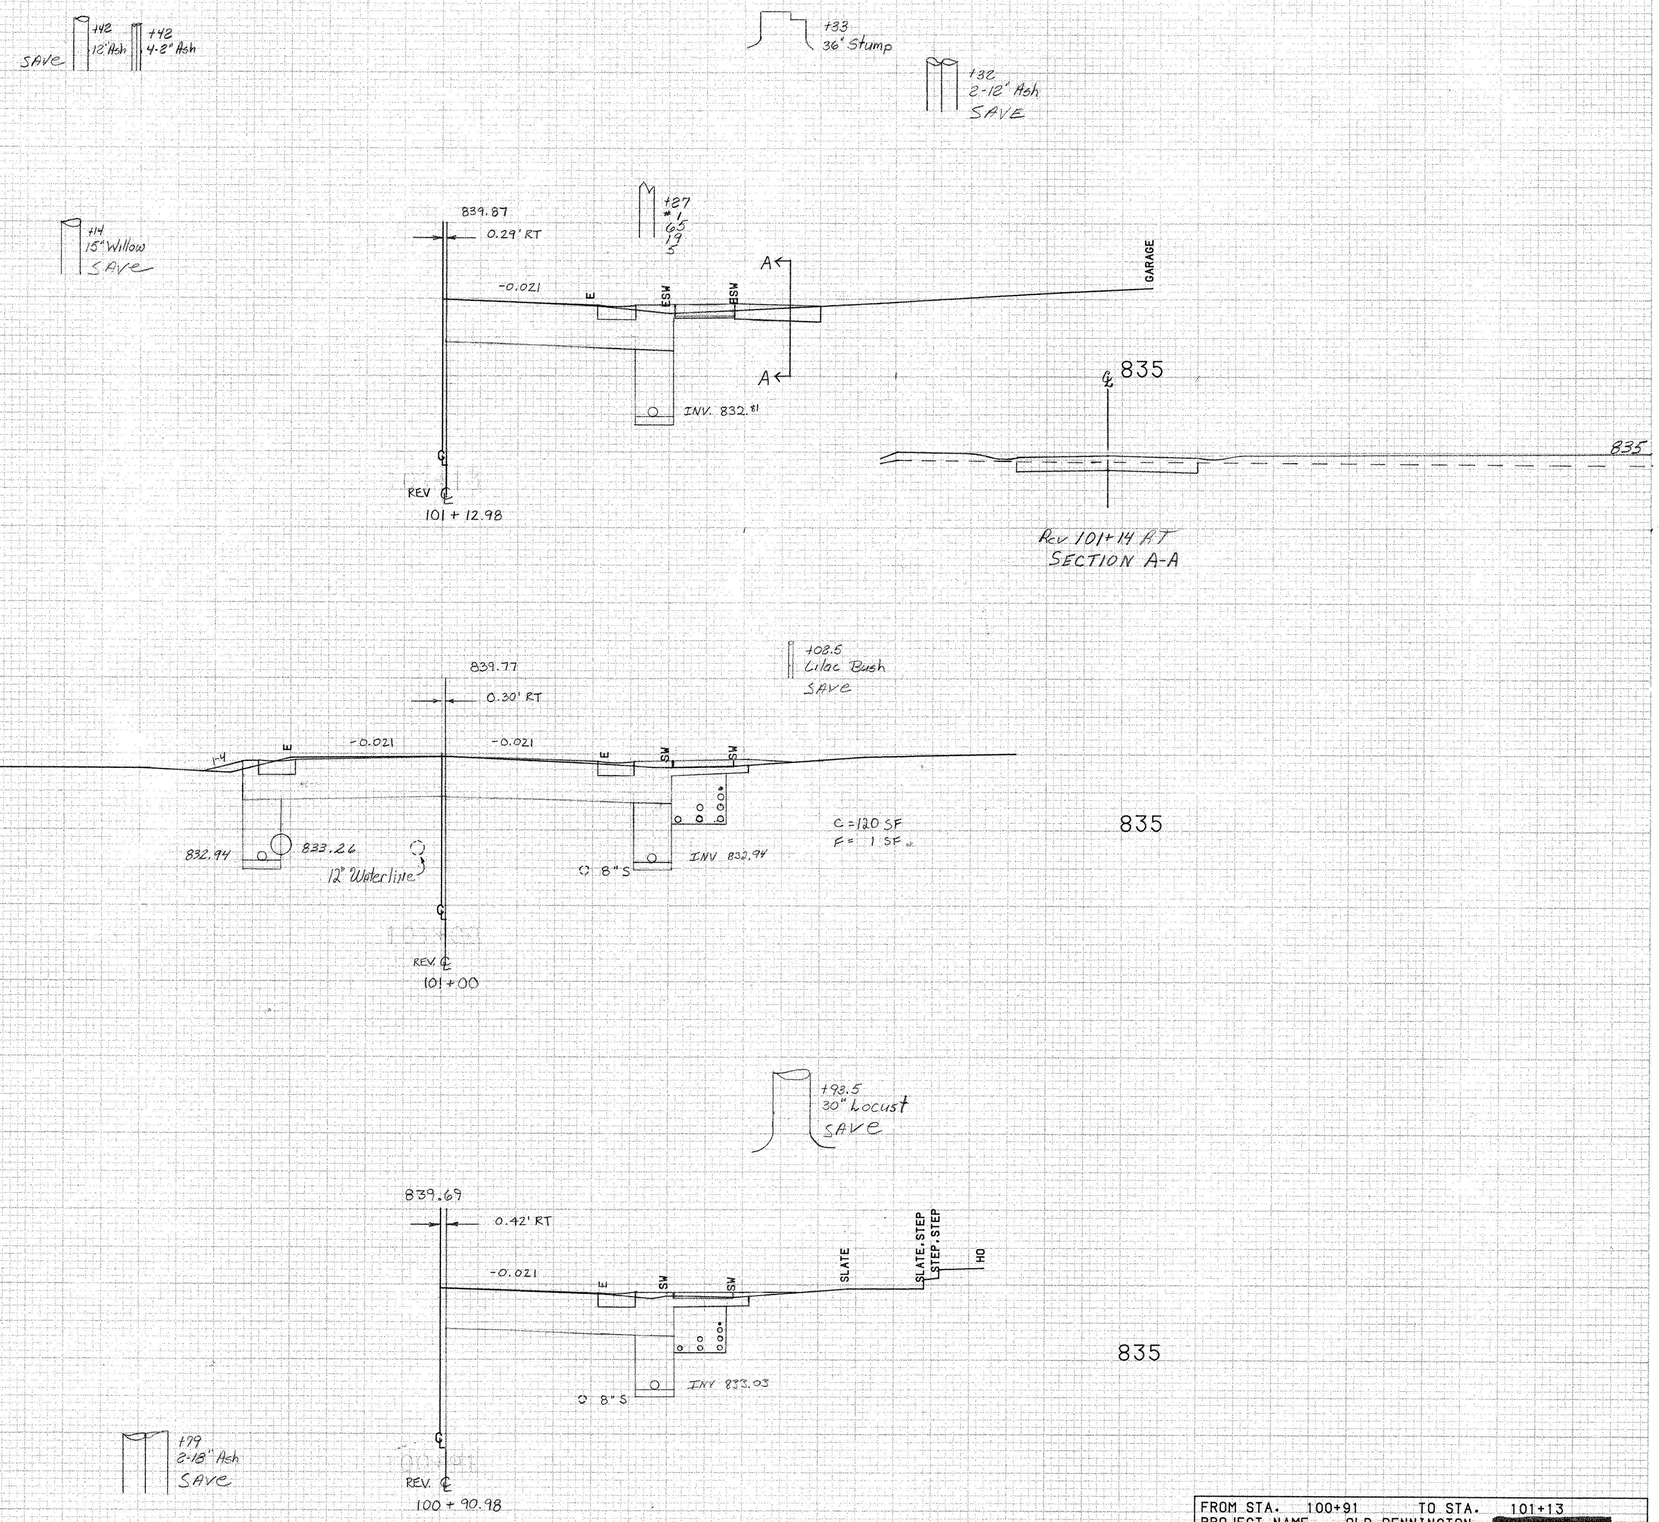

FROM STA. 100+91		TO STA. 101+13	
PROJECT NAME	OLD BENNINGTON	[redacted]	
NO.	M1400(4)S		PLOTTED 02/24/86
SURVEYED BY	MOREAU		JAN. 1986
SHEET 46 OF 63 SHEETS			