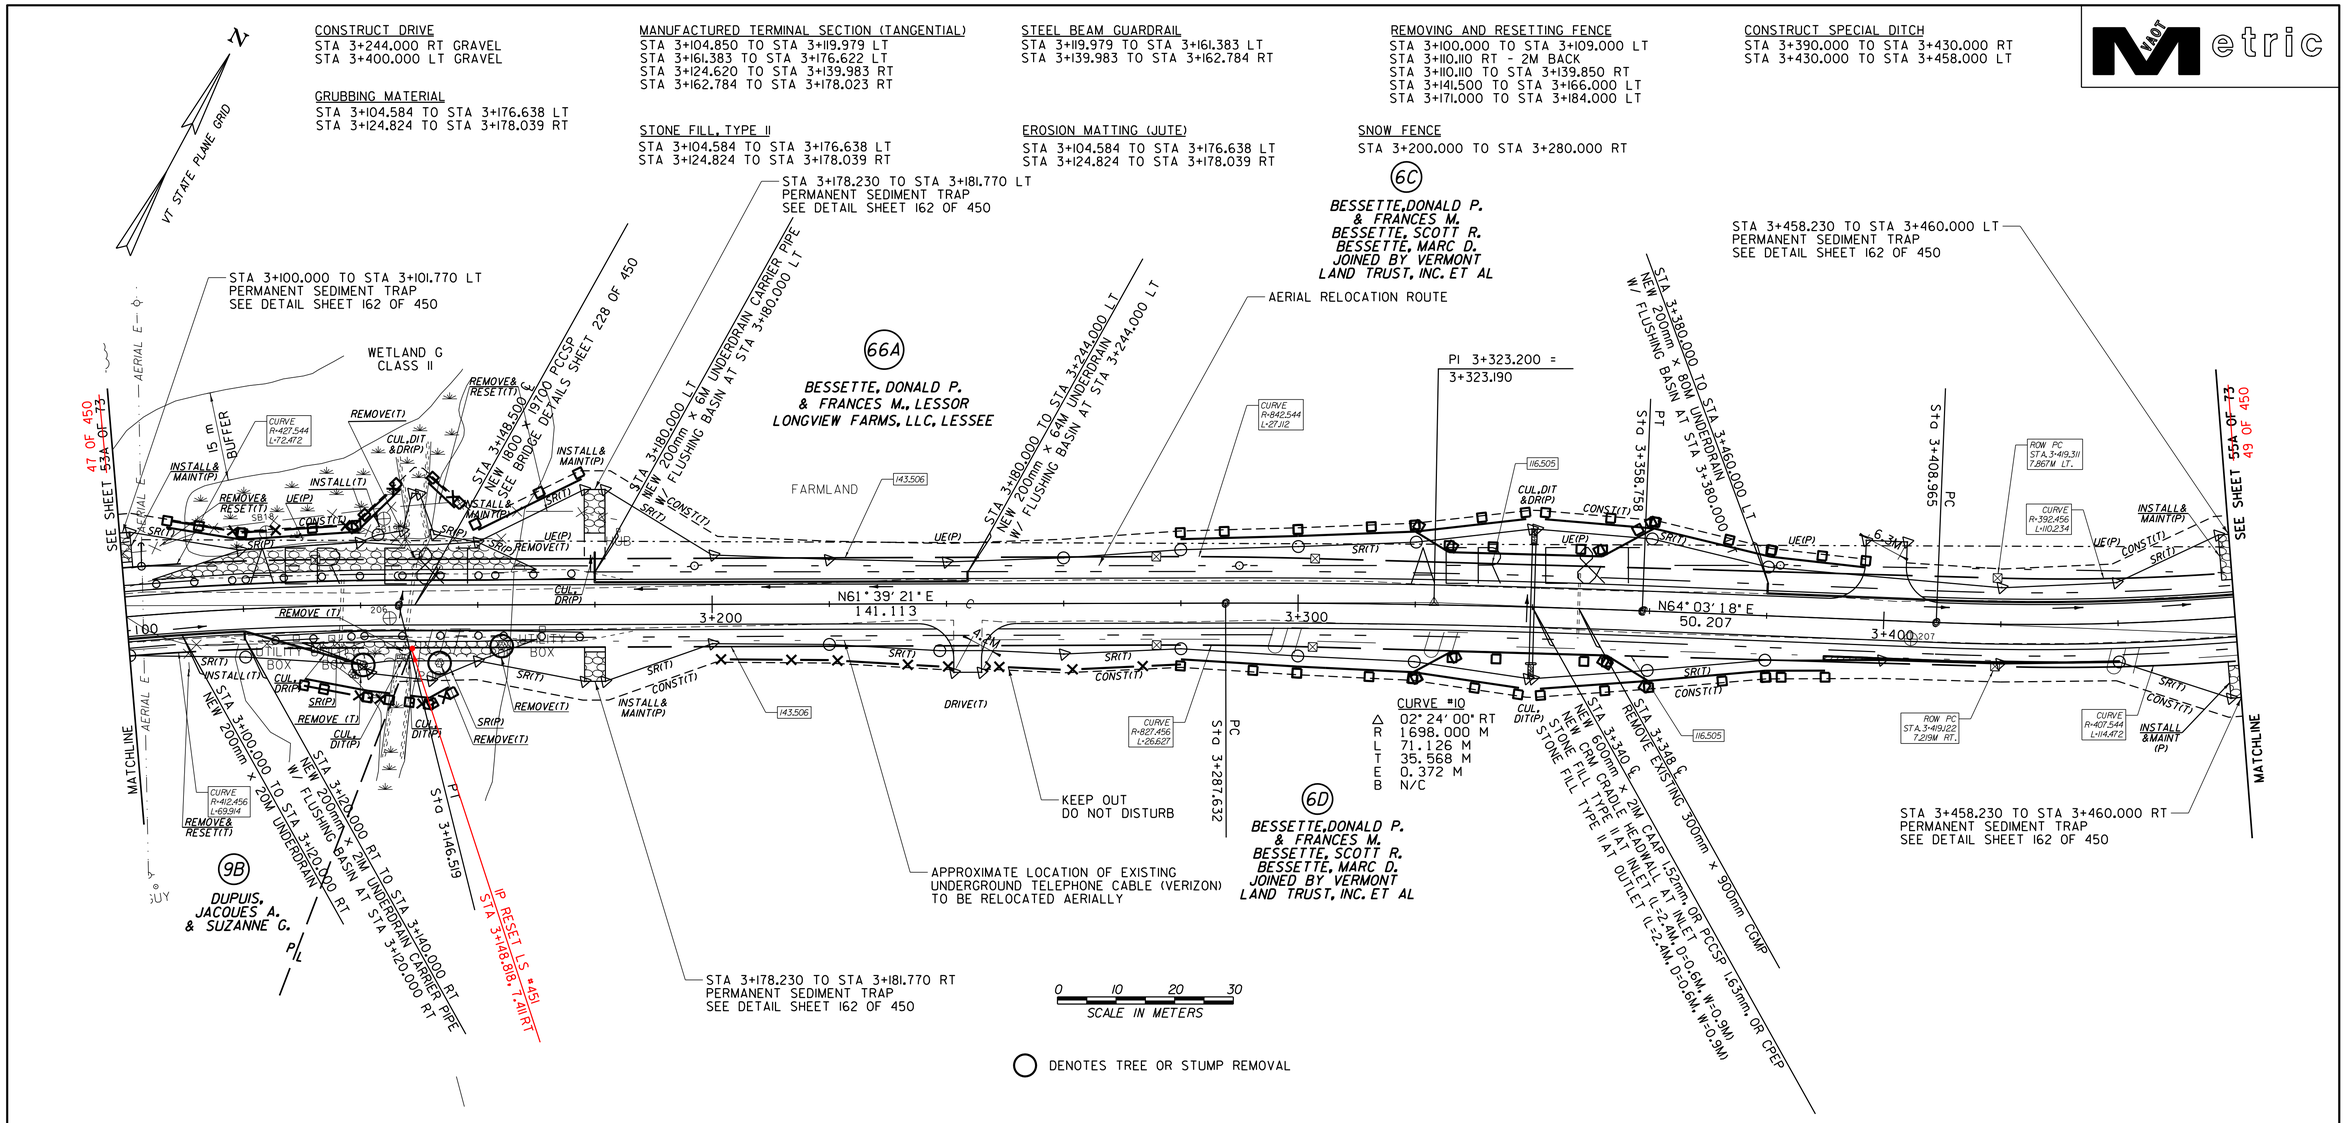

NOTES;

1. ALL SIDE ROAD RADII SHALL BE 11M UNLESS OTHERWISE NOTED. REFER TO STD B-12M
2. ALL DRIVE RADII SHALL BE 6M UNLESS OTHERWISE NOTED. REFER TO STD B-7IM

LINES SHOWN ON THIS PLAN AS EXISTING PROPERTY LINES P/L ARE BELIEVED TO BE ACCURATE BUT SHOULD NOT BE RELIED UPON FOR PURPOSES UNRELATED TO THE STATE OF VERMONT'S ACQUISITION OF LAND AND RIGHTS FOR THIS PROJECT.

FOR R.O.W. USE ONLY

SEE LAYOUT SHEETS FOR CONSTRUCTION CHANGES

(R.O.W. AS BUILT)

PROJECT NAME: HIGHGATE-FRANKLIN ~~(AS BUILT)~~
PROJECT NUMBER: STP RS 0301(I) SA

FILE NAME: NAME$DGN
PROJECT LEADER: DELLASANTA
DESIGNED BY: SQUAD B
ROW LAYOUT SHEET ~~7A OF 26~~ 54 OF 73

PLOT DATE: 12-FEB-2014 11:47
DRAWN BY: ~~N. GARBACIK~~ ROW
CHECKED BY: H. PETROVS
SHEET 48 ~~54A~~ OF ~~73~~ 450