SLEEVES FOR UTILITIES (115 mm DIAMETER)(MOD)
STA 3+835.000 RT TO STA 20+038.748 LT

CONSTRUCT DRIVE
STA 3+772.000 LT GRAVEL
STA 3+845.000 RT GRAVEL
STA 4+086.000 RT GRAVEL

CONSTRUCT SPECIAL DITCH
STA 3+810.000 TO STA 3+830.000 RT
STA 3+930.000 TO STA 4+030.000 RT

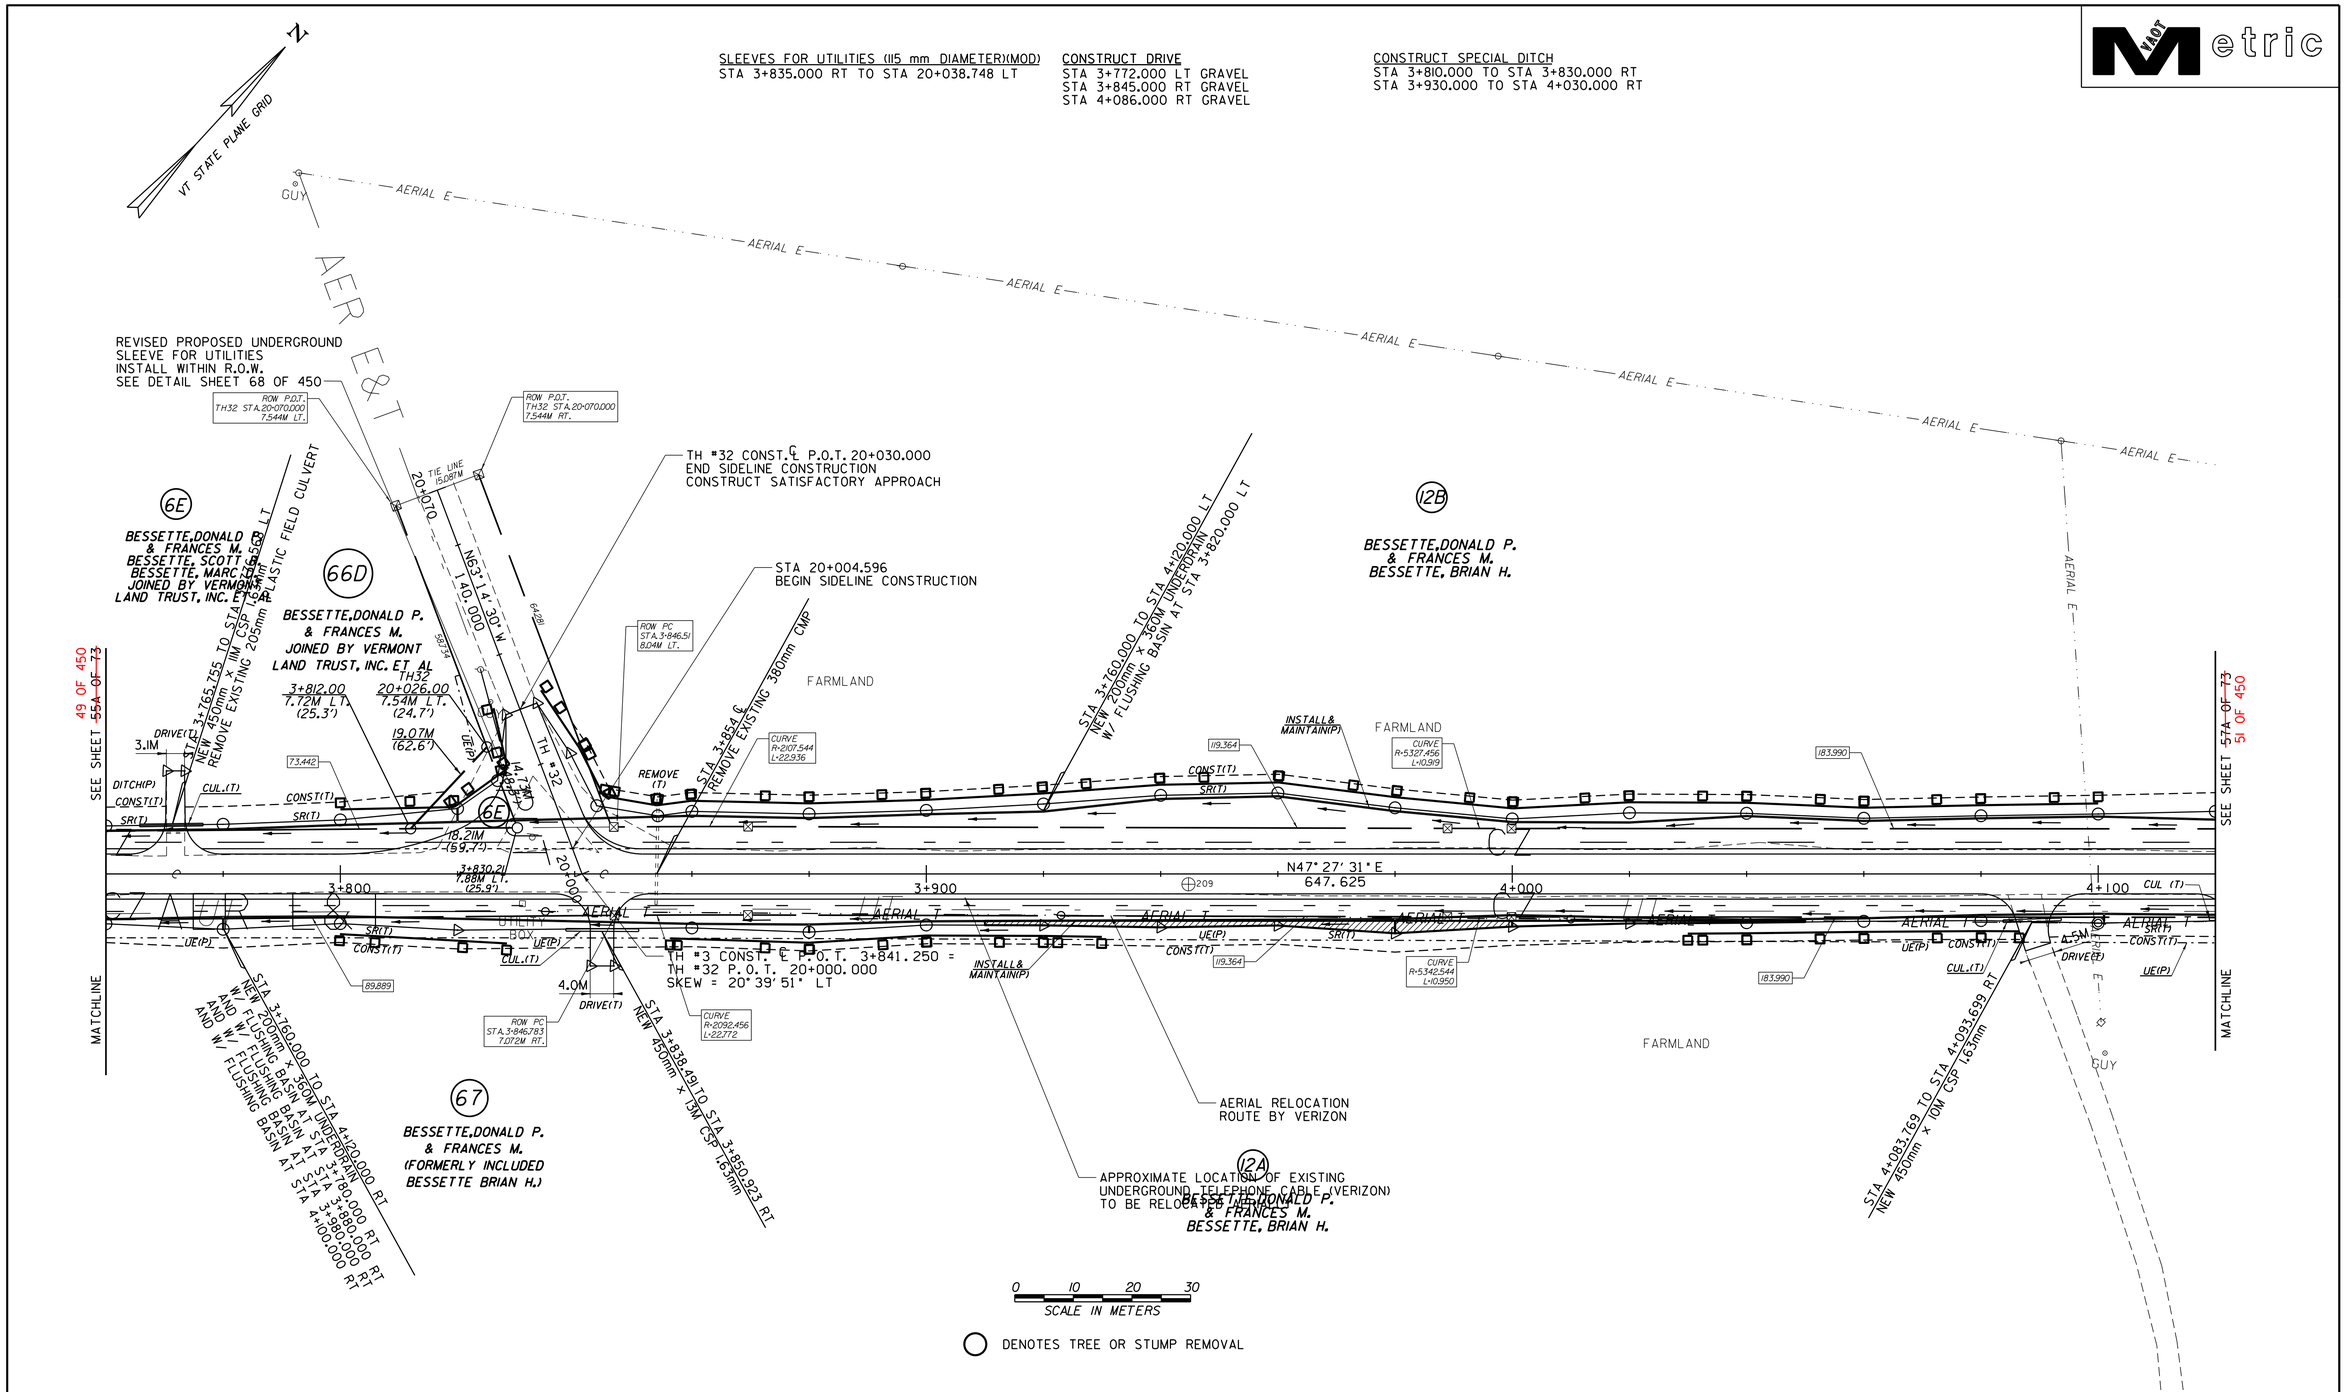

DENOTES TREE OR STUMP REMOVAL

NOTES:
1. ALL SIDE ROAD RADII SHALL BE 11M UNLESS OTHERWISE NOTED. REFER TO STD B-12M
2. ALL DRIVE RADII SHALL BE 6M UNLESS OTHERWISE NOTED. REFER TO STD B-71M

EXISTING R.O.W. CALCULATED POINT
N68°35'48"E 17.193 EXISTING R.O.W. DATA (TYPICAL)

SEE LAYOUT SHEETS FOR CONSTRUCTION CHANGES

LINES SHOWN ON THIS PLAN AS EXISTING PROPERTY LINES P/L ARE BELIEVED TO BE ACCURATE BUT SHOULD NOT BE RELIED UPON FOR PURPOSES UNRELATED TO THE STATE OF VERMONT'S ACQUISITION OF LAND AND RIGHTS FOR THIS PROJECT.

FOR R.O.W. USE ONLY

(R.O.W. AS BUILT)

PROJECT NAME: HIGHGATE-FRANKLIN ~~(AS BUILT)~~
PROJECT NUMBER: STP RS 0301(1) SA

FILE NAME: NAME$DGN
PROJECT LEADER: DELLASANTA
DESIGNED BY: SQUAD B
ROW LAYOUT SHEET ~~9A OF 26~~ 56 OF 73

PLOT DATE: 12-FEB-2014 11:47
DRAWN BY: ~~N. GARBACIK~~ ROW
CHECKED BY: H. PETROVS
SHEET 50 ~~56A~~ OF ~~73~~ 450