CONSTRUCT DRIVE
STA 6+024.000 LT GRAVEL
STA 6+032.000 RT GRAVEL

REMOVING AND RESETTING FENCE
~~STA 5+976.000 LT 5M BACK~~
~~STA 5+976.000 TO STA 6+017.000 LT~~
~~STA 6+017.000 LT 3M BACK~~

CONSTRUCT SPECIAL DITCH
STA 5+780.000 TO STA 5+840.000 LT
STA 5+780.000 TO STA 5+810.000 RT
STA 5+950.000 TO STA 6+030.000 RT
STA 6+010.000 TO STA 6+020.000 LT

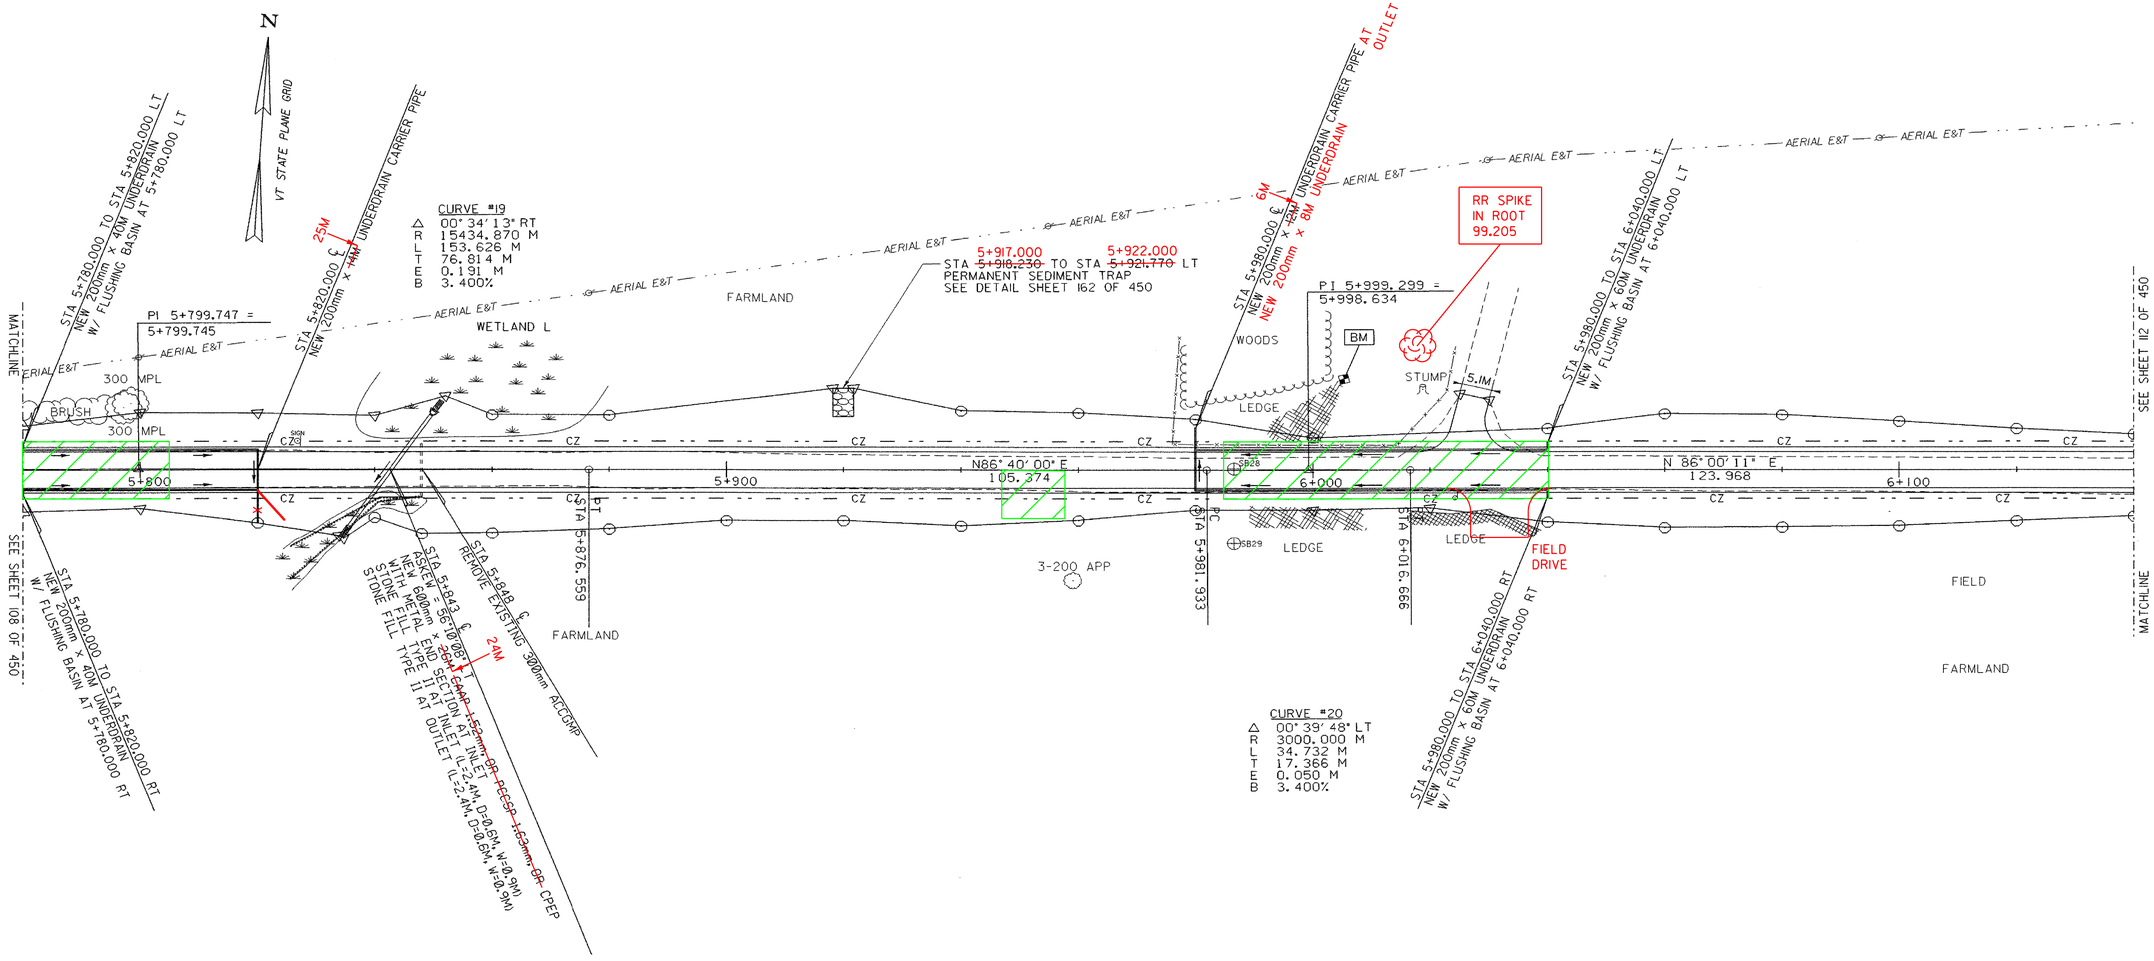

0 10 20 30
SCALE IN METERS

○ DENOTES TREE OR STUMP REMOVAL

NOTES:
1. ALL SIDE ROAD RADII SHALL BE 11M UNLESS OTHERWISE NOTED. REFER TO STD B-12M
2. ALL DRIVE RADII SHALL BE 6M UNLESS OTHERWISE NOTED. REFER TO STD B-71M

BLASTED AREA

PROJECT NAME: HIGHGATE - FRANKLIN
PROJECT NUMBER: STP RS 0301(1) SA

FILE NAME: ...85c060/design/dc060bdr.dgn PLOT DATE: 09-MAY-2005
PROJECT LEADER: DELLASANTA DRAWN BY: SQUAD B
DESIGNED BY: SQUAD B CHECKED BY: SQUAD B
IPARM FILE NAME: dc06011S.1 SHEET 110 OF 450