Metric

DECIDUOUS TREES
~~STA 9+240 LT (1 UAP)~~
~~STA 25+015 LT (1 FP)~~
~~STA 9+273 LT (1 UAP)~~
~~STA 9+281 LT (1 UAP)~~
~~STA 9+280 LT (2 ARN)~~
STA 9+220 LT (1 OR)
STA 9+220 RT (1 OV)
STA 9+226 RT (1 OV)
STA 9+232 RT (1 OV)
STA 9+240 RT (1 FP)

GROUND COVER AND VINES
~~STA 9+124 TO 9+161 RT (320 LP)~~
~~STA 9+182 TO 24+045 RT (260 HF)~~
~~STA 9+193 TO 9+231 LT (200 HF)~~
STA 9+138 TO STA 9+202 RT (320 LP)
STA 9+138 TO STA 9+180 RT (137 HF)

SNOW FENCE
~~STA 24+031 TO STA 24+054 LT~~
~~STA 25+014 TO STA 25+041 LT~~
~~STA 9+293 TO AH STA 14+658 LT~~
STA 24+034 TO STA 24+048 LT
STA 25+014 TO STA 25+032 LT
STA 9+295 TO AH STA 14+658 LT

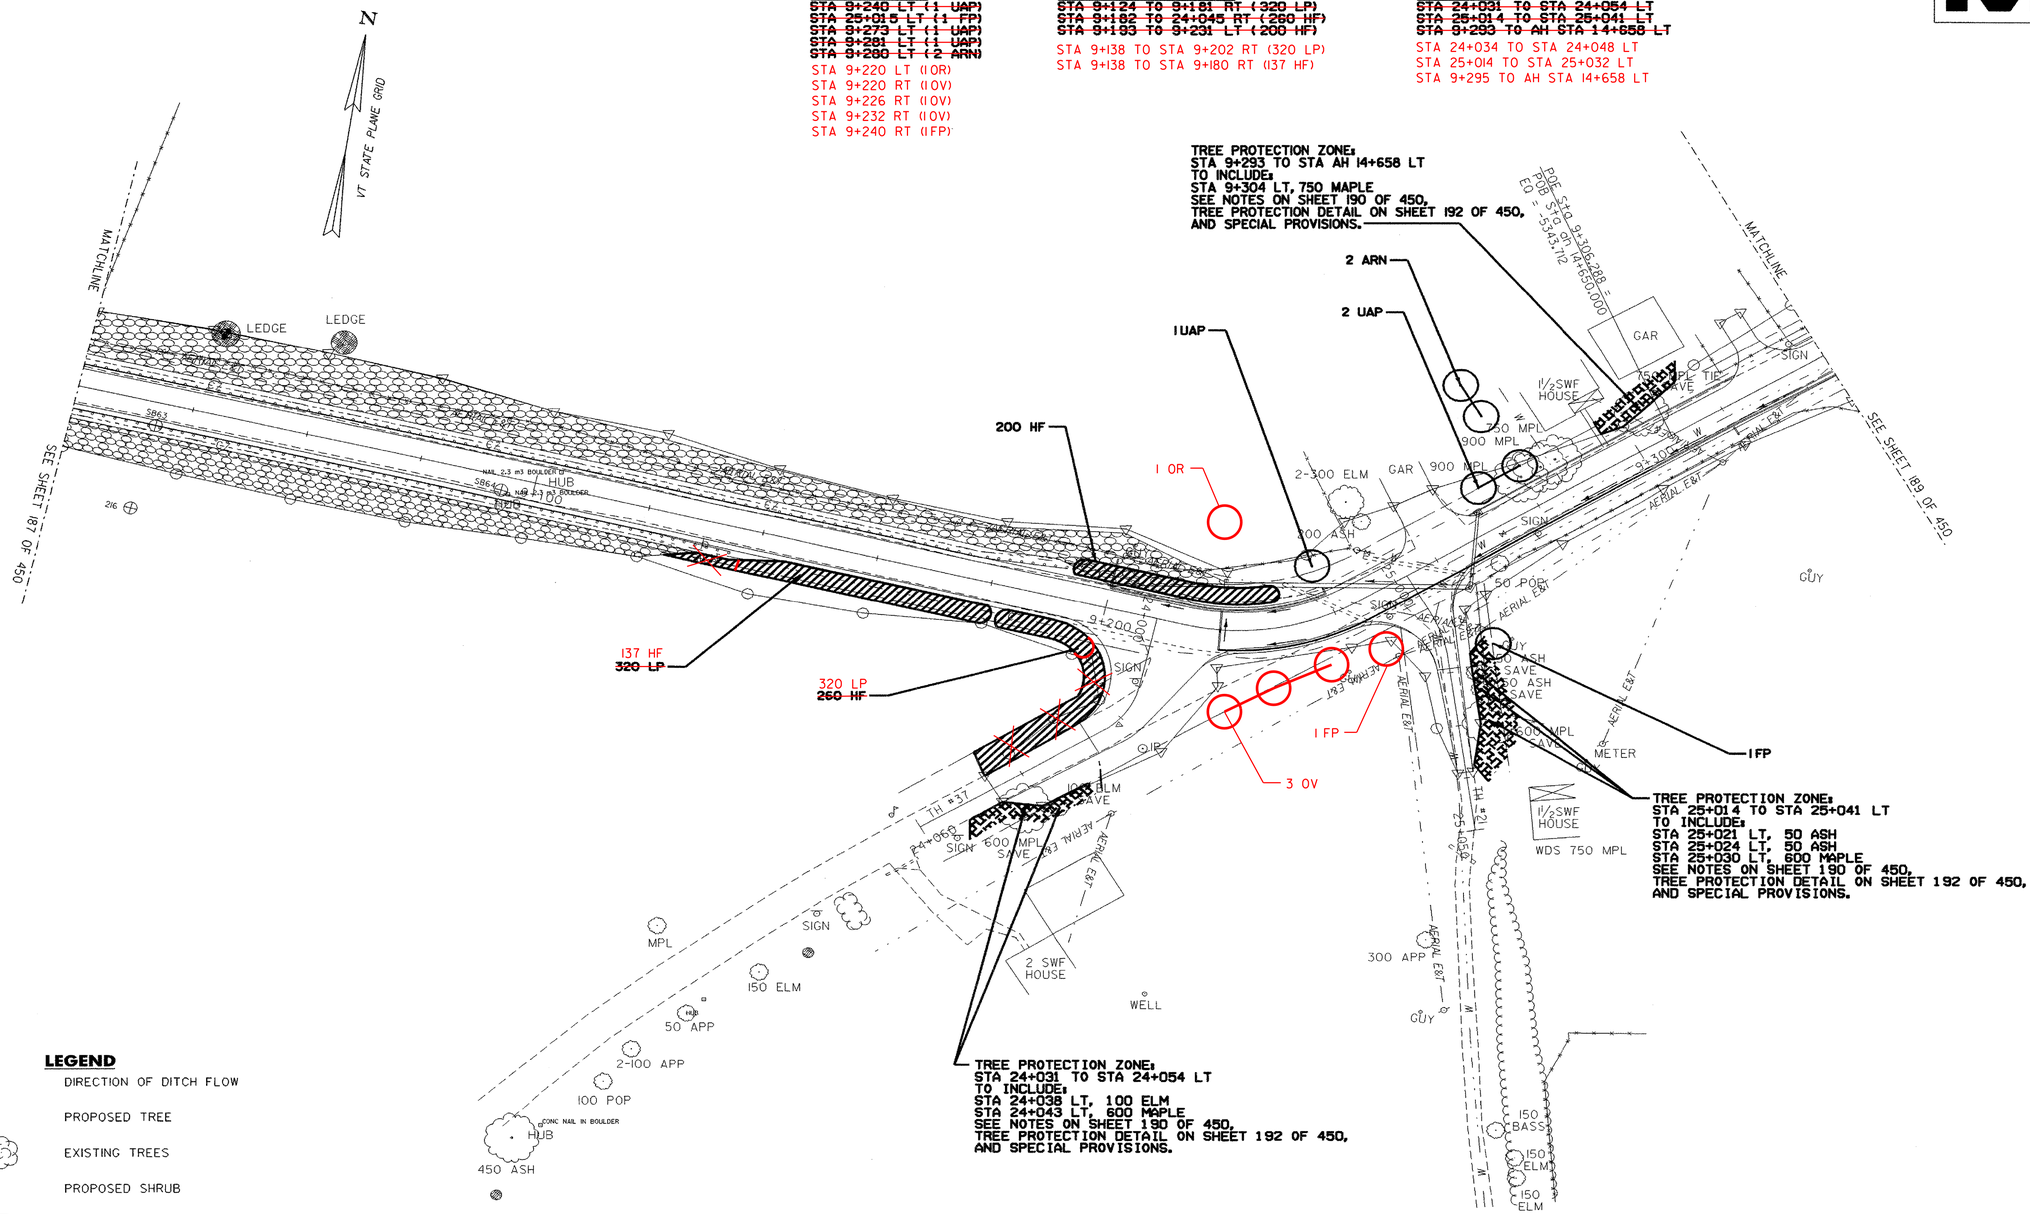

LEGEND

- DIRECTION OF DITCH FLOW
- PROPOSED TREE
- EXISTING TREES
- PROPOSED SHRUB
- PROPOSED GROUND COVER
- NEW LOCATION FOR TRANSPLANTED MATERIAL
- EXISTING PLANT MATERIAL TO BE TRANSPLANTED
- TREE PROTECTION ZONE WITH FENCING
- LIMIT OF CUT
- LIMIT OF FILL

LANDSCAPE PLAN

0 10 20 30
1:500

PROJECT NAME:	HIGHGATE - FRANKLIN
PROJECT NUMBER:	STP RS 0301(1) SA
FILE NAME: 85c060/design/dc060landbdr.dgn	PLOT DATE: 09-MAY-2005
PROJECT LEADER: DELLASANTA	DRAWN BY: SQUAD B
DESIGNED BY: SQUAD B	CHECKED BY: SQUAD B
IPARM FILE NAME: dc060land25.i	SHEET 188 OF 450