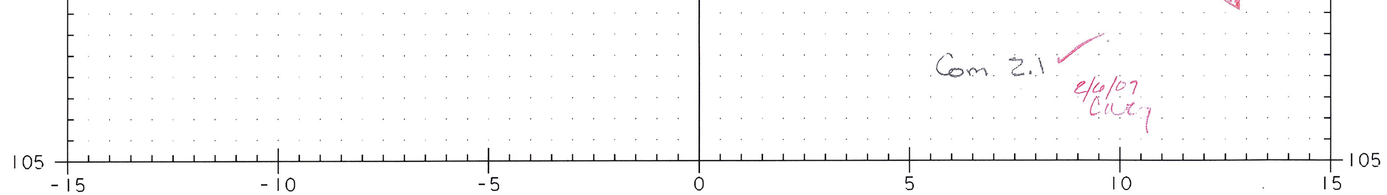
105
-15
-10
-5
0
5
10
15
105
Com 2.1
2/6/07
CWG

7+100

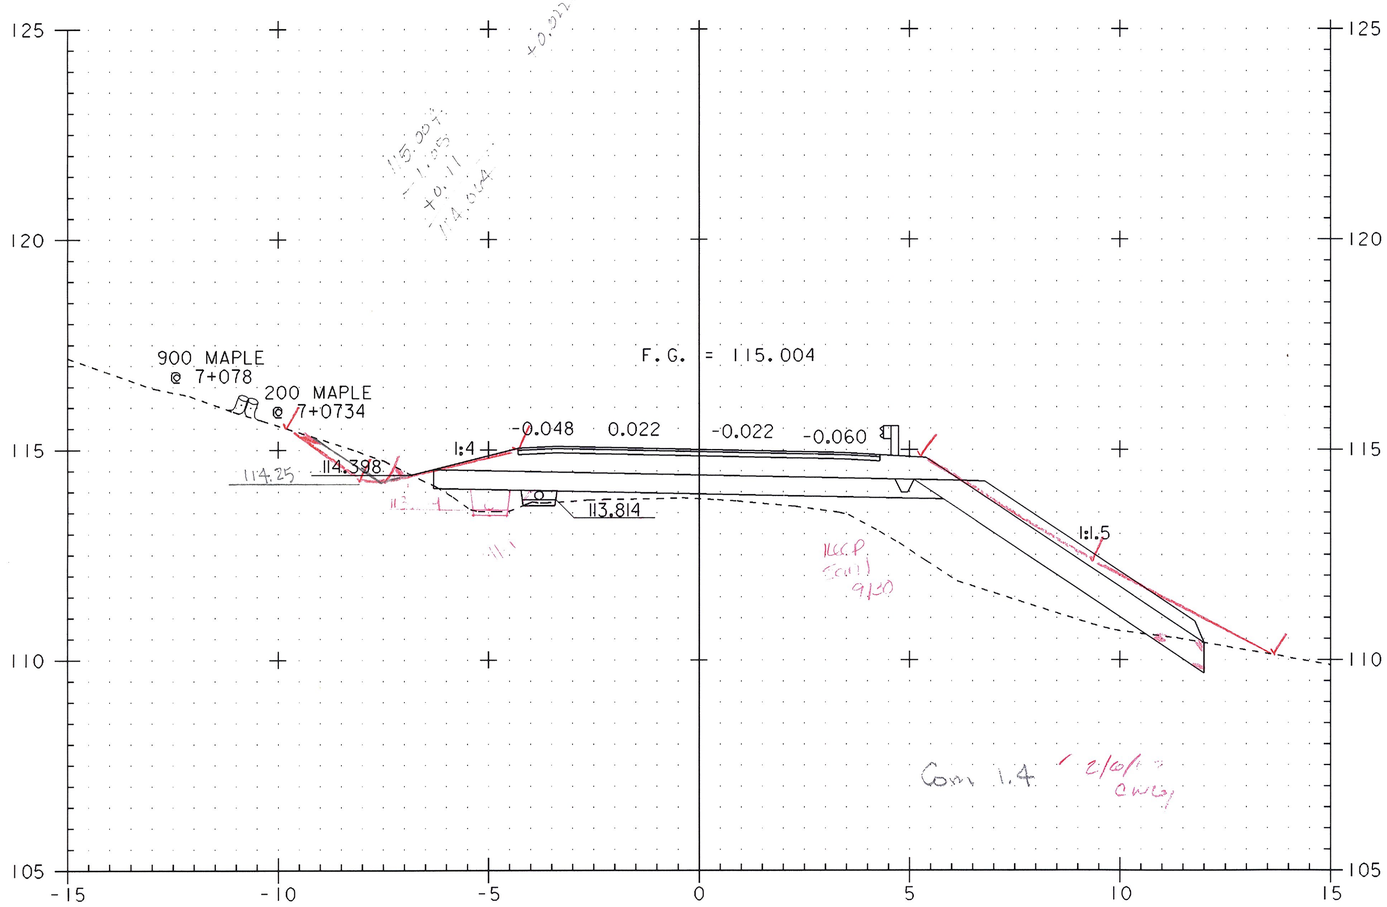
125
120
115
110
105
-15
-10
-5
0
5
10
15
900 MAPLE
@ 7+078
200 MAPLE
@ 7+0734
F. G. = 115.004
1:4
-0.048
0.022
-0.022
-0.060
114.398
114.25
113.814
1:1.5
Com 1.4
2/6/07
CWG

7+080

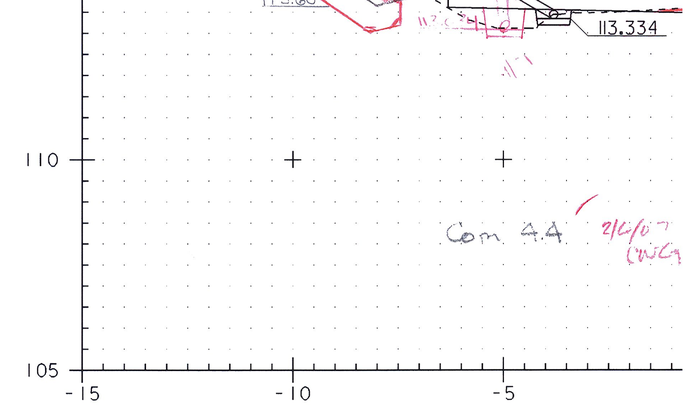
110
105
-15
-10
-5
113.334
Com 4.4
2/6/07
CWG

7

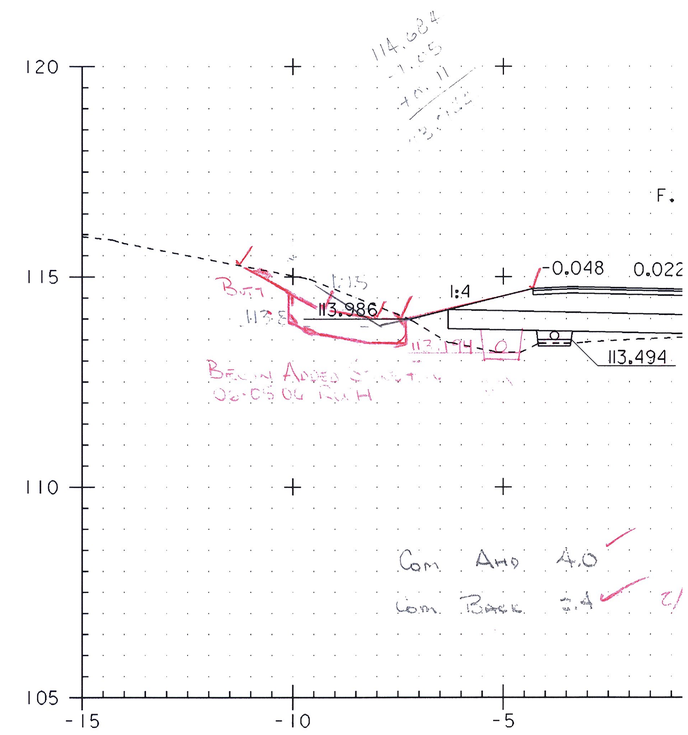
120
115
110
105
-15
-10
-5
1:4
-0.048
0.022
113.986
113.494
Com Ahd 4.0
Com Back 3.4

7

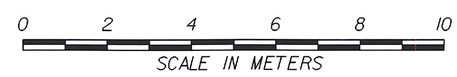
0
2
4
6
8
10
SCALE IN METERS