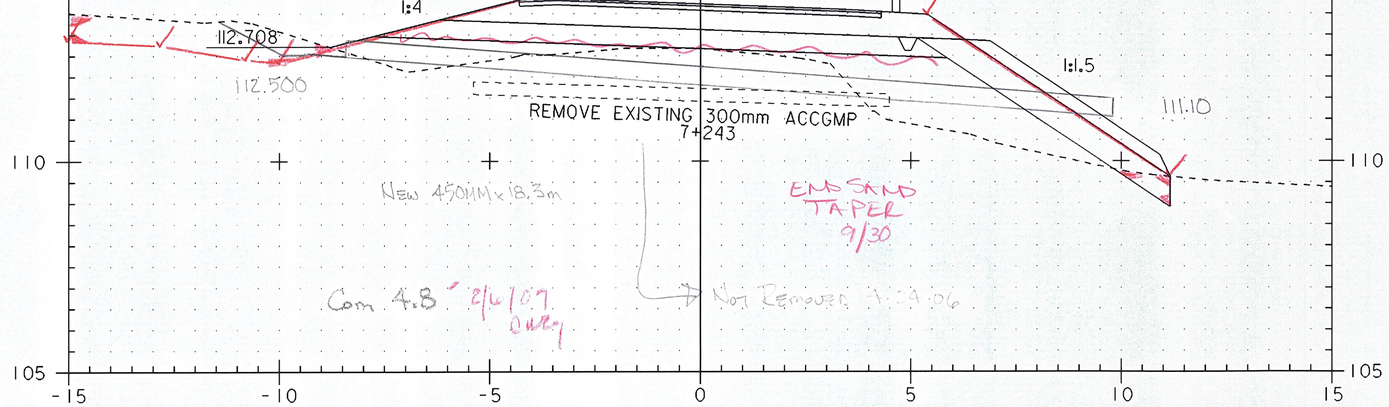

7+240

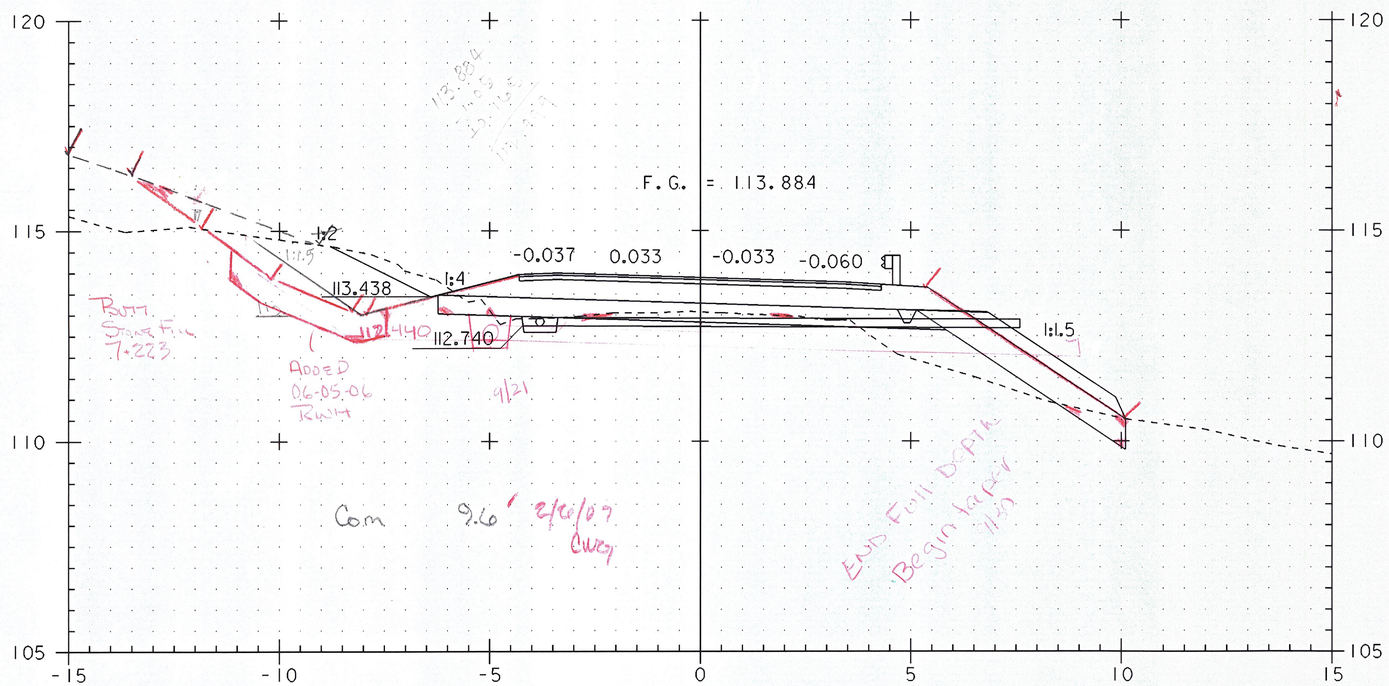

7+220

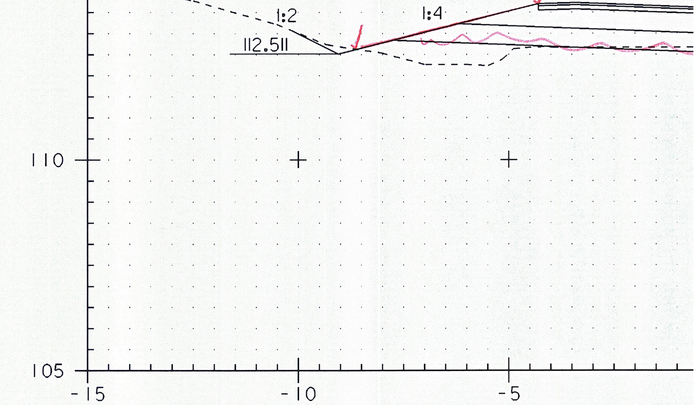

7-

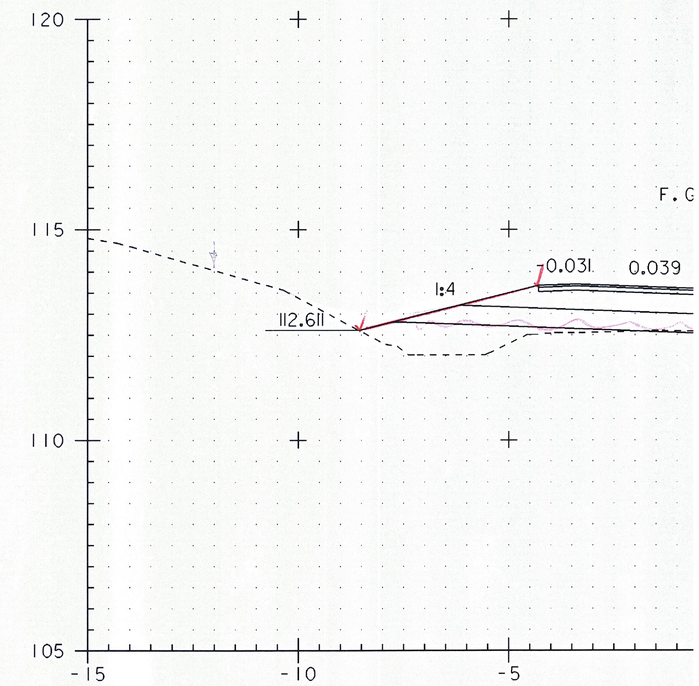

7-

STA 7+216.160 END TAPER BEGIN FULL DEPTH SAND (450MM)
STA 7+214.300 BEGIN TAPER

0 2 4 6 8 10
SCALE IN METERS