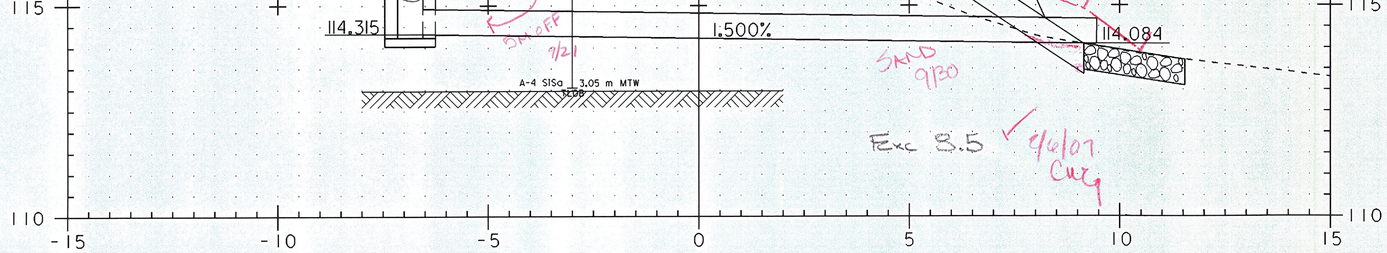

7+800

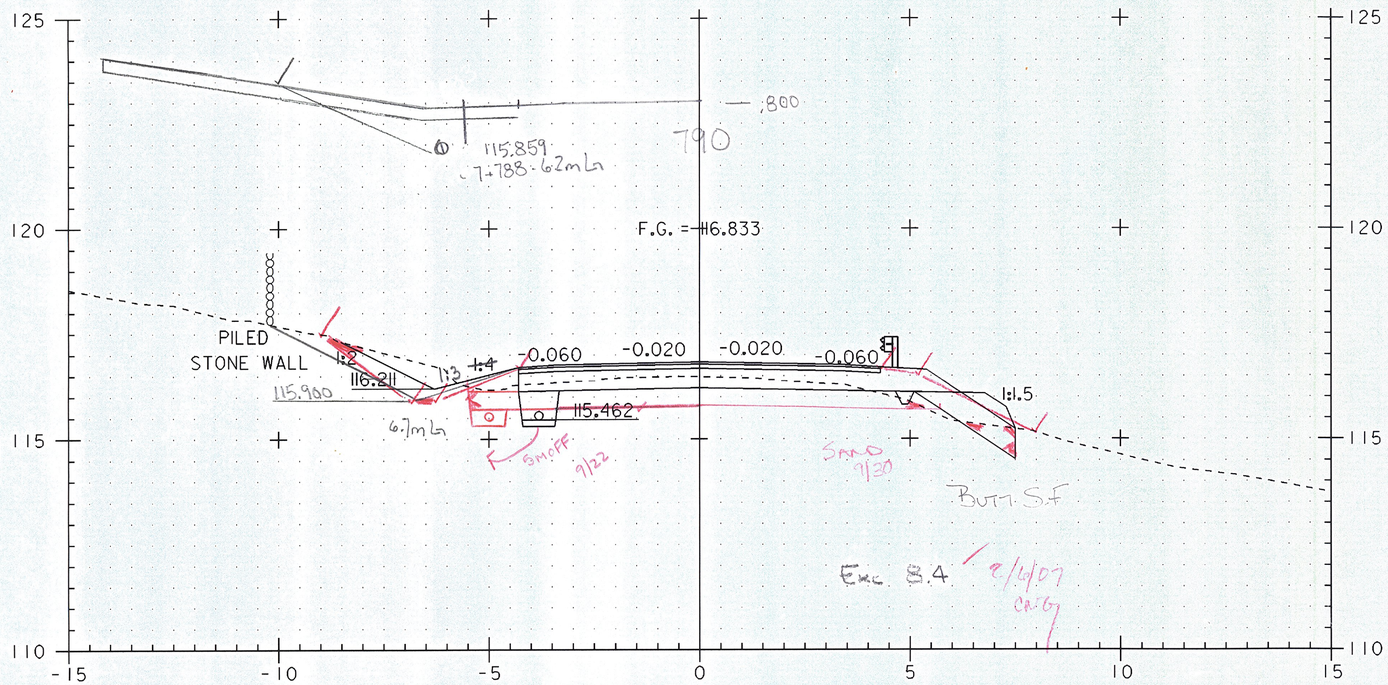

7+780

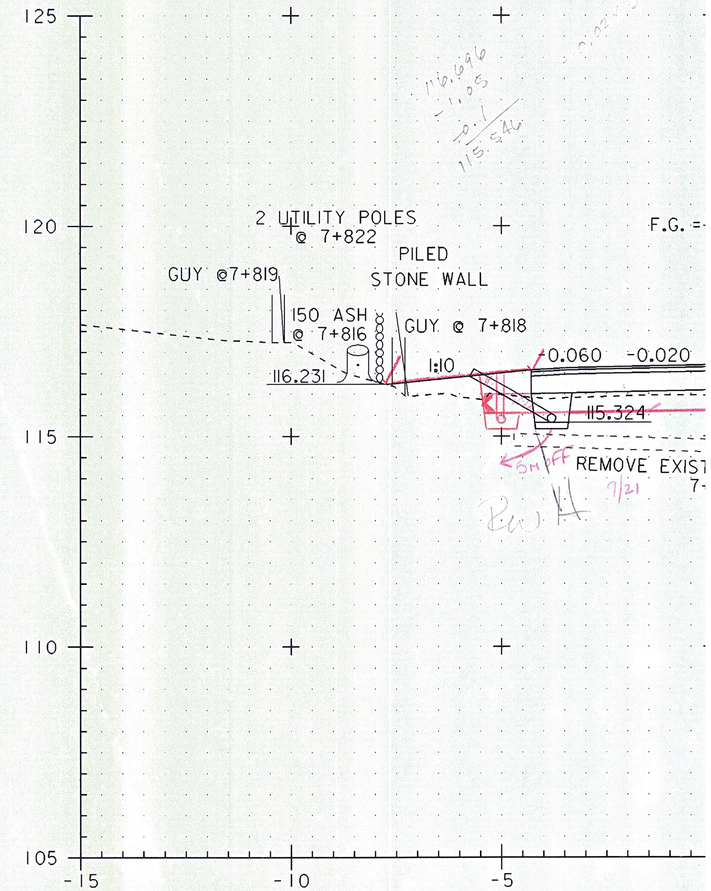

7+

0 2 4 6 8 10
SCALE IN METERS