Metric

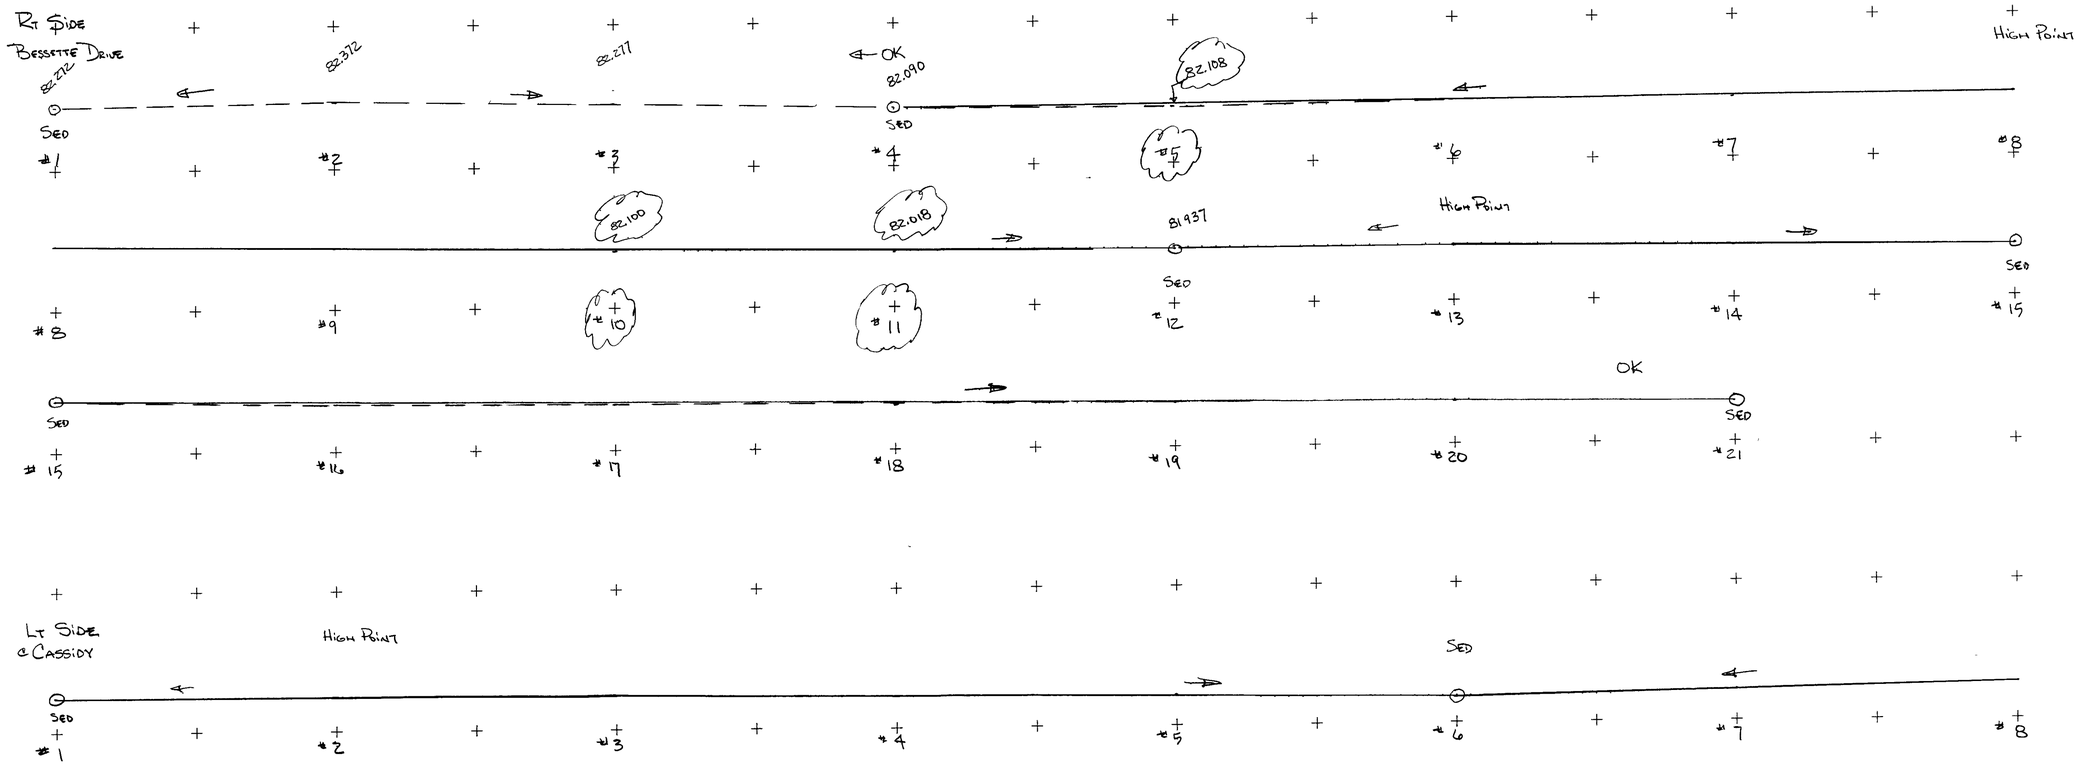

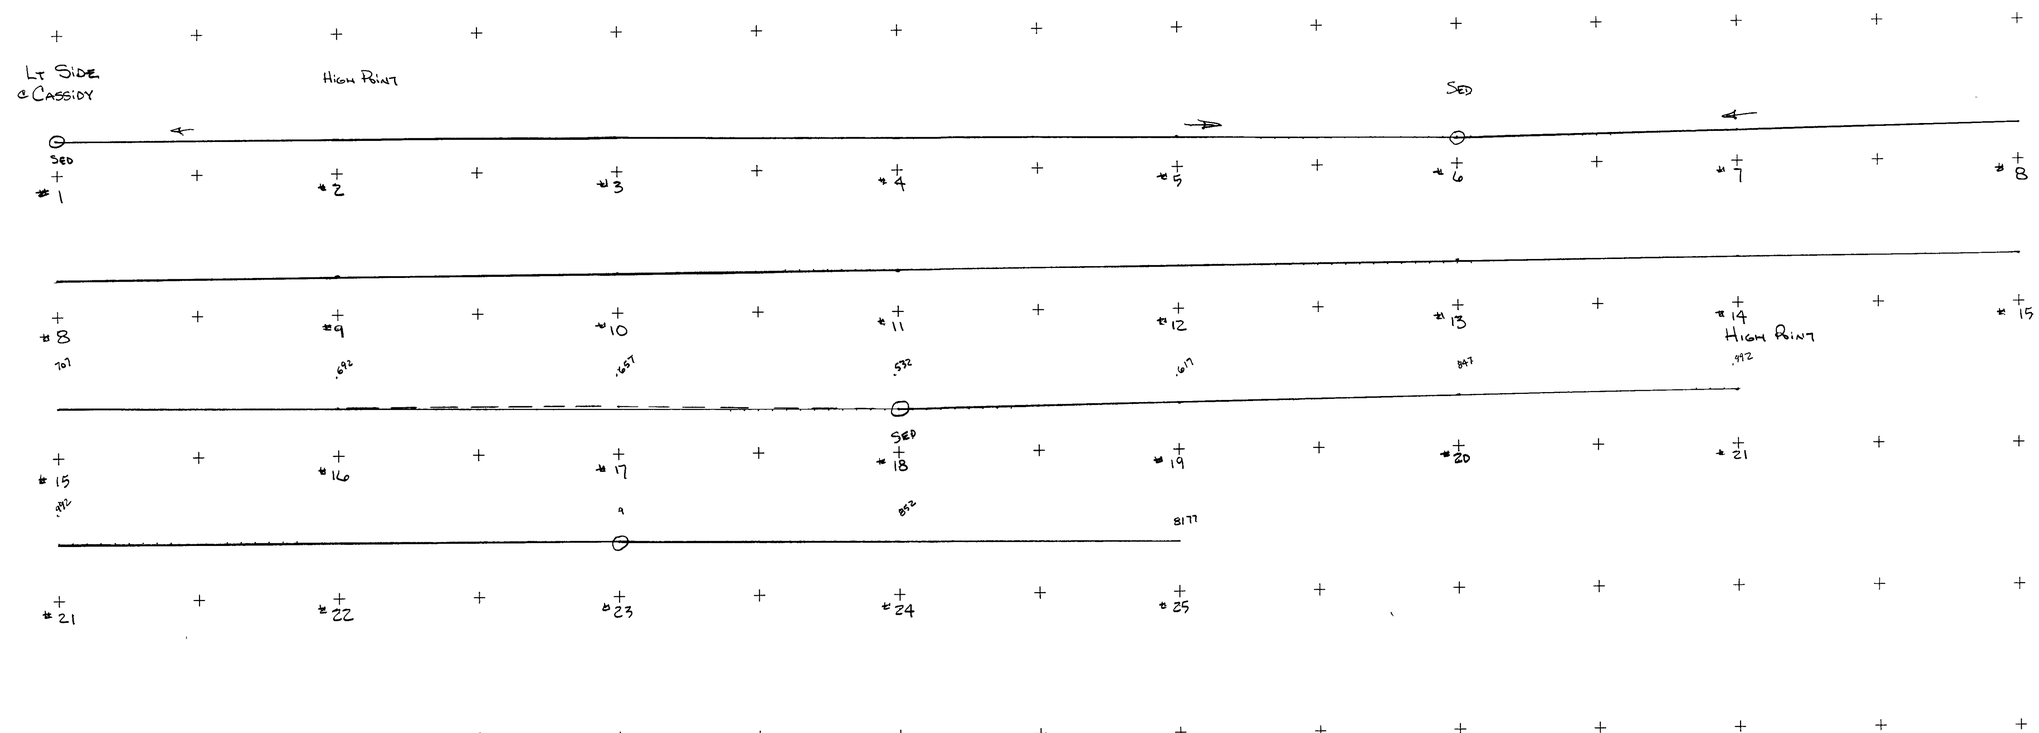

PROJECT: Highgate - Franklin	PROJECT NO.: STP-RS 0301(1)SA
DESIGN FILE NAME: IPARM FILE NAME:	PLOT DATE: 01-MAY-1996
Profile Ditchline Cassidy Rd to Bessette Drive	SHEET: OF

492 - Ditchline