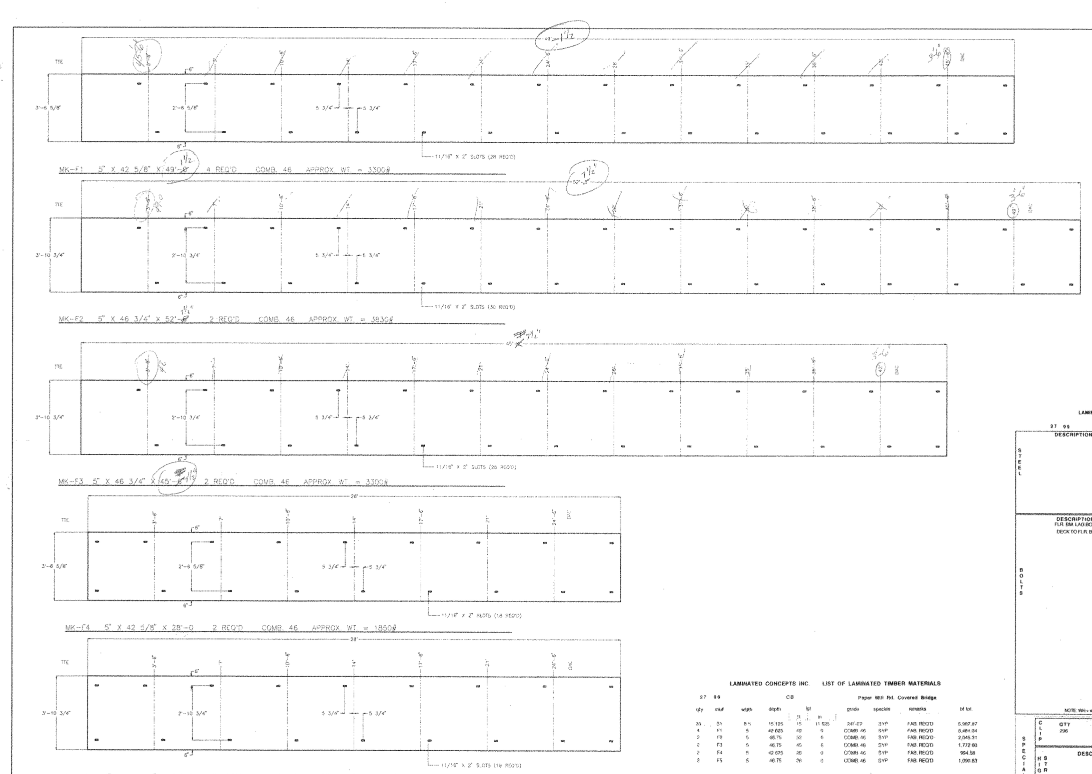

RECEIVED
CK'D BY______ OK'D BY RRW
FEB 01 2000
RESUBMIT______ APPROVED As Noted
BY DATE 2-1-00

LAMINATED CONCEPTS INC. LIST OF HARDWARE MATERIALS

27 99 CB Paper Mill Rd. Covered Bridge

	DESCRIPTION	QTY	THK	WIDTH	LGT	TYPE
STEEL						

	DESCRIPTION	QTY	DIA.	LGT	WH	WN	N	TYPE
BOLTS	FLR. BM. LAG BOLTS	70	1"	12"		T		HEX HEAD LAGS
	DECK TO FLR. BM.	296	5/8"	8"		F	1	DOME HEAD BOLTS
		310	5/8"					FLAT WASHERS
		72	1"					TIMBER WASHERS
		310	5/8"					HEX NUTS

NOTE: WH = washer type at bolt head, WN = washer type at nut, N = nuts WASHER TYPES (T = timber F = flat)

SPECIAL		QTY	TYPE
	CLIP	296	ALUM. DECK BRACKETS

	QTY	THK	WIDTH	LENGTH
NEO				

	DESCRIPTION	QTY	DIA.	LENGTH	TYPE
HIGH STR					

LAMINATED CONCEPTS INC. LIST OF LAMINATED TIMBER MATERIALS

27 99 CB Paper Mill Rd. Covered Bridge

qty	mk#	width	depth	lgt ft	lgt in	grade	species	remarks	bf tot.
35	S1	8.5	15.125	15	11.625	24F-E2	SYP	FAB. REQ'D	5,987.87
4	F1	5	42.625	49	0	COMB. 46	SYP	FAB. REQ'D	3,481.04
2	F2	5	46.75	52	6	COMB. 46	SYP	FAB. REQ'D	2,045.31
2	F3	5	46.75	45	6	COMB. 46	SYP	FAB. REQ'D	1,772.60
2	F4	5	42.625	28	0	COMB. 46	SYP	FAB. REQ'D	994.58
2	F5	5	46.75	28	0	COMB. 46	SYP	FAB. REQ'D	1,090.83

Matt Smith

LAMINATED CONCEPTS INC.
P.O. BOX 389
3310 STATE RTE. 352
BIG FLATS, NEW YORK 14814
PHONE: 607.562.8110
FAX: 607.562.8105

DRAWN	DATE
MSS	1/26/00
CHK'D	DATE
APP'D	DATE
SCALE	

REVISIONS			
NO.	DATE	BY	DESCRIPTION

PROJECT NAME: PAPERMILL COVERED BRIDGE
TOWN OF BENNINGTON COUNTY OF BENNINGTON
BRIDGE NO. 31
BENNINGTON, VERMONT

PREPARED FOR: BLOW & COTE
MORRISVILLE, VERMONT

PROJECT JOB NO. 2799-126-CB

SHEET NO. 2 OF 2