REV.	BY	DATE	DESCRIPTION
3	CWC	5/22/08	REVISED WW 1 & WW 2 ELEVATIONS
4	CWC	7/01/08	EXISTING BOTTOM OF FOOTING ELEVATION REVISED

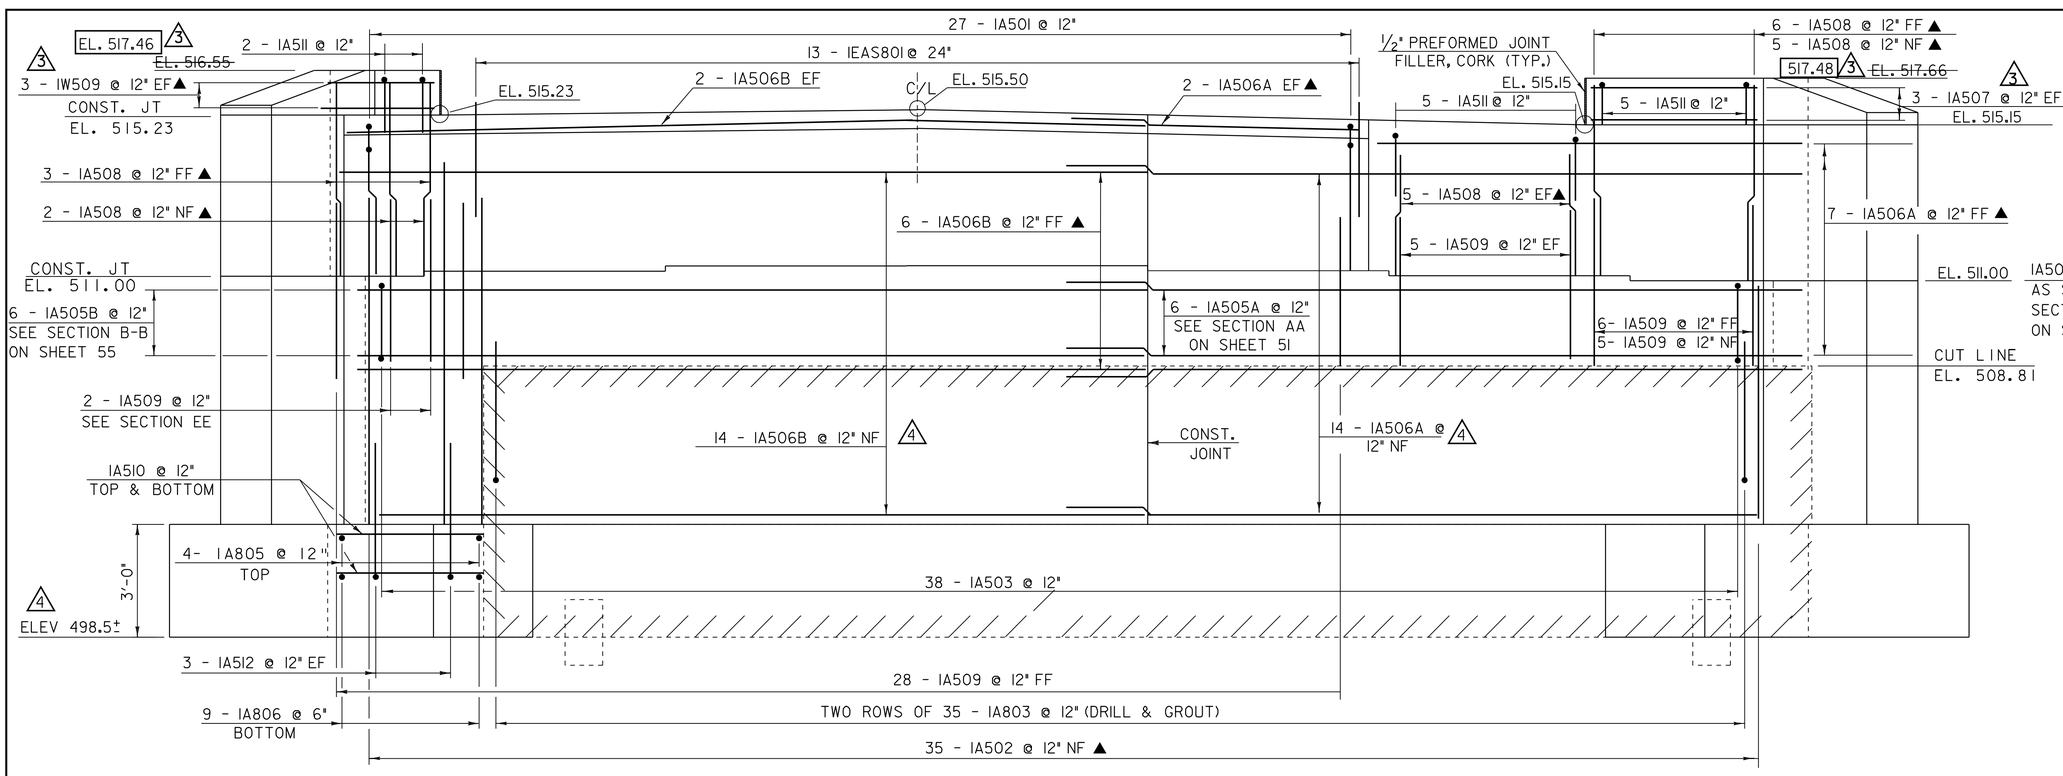

ABUTMENT NO. 1 BACKWALL ELEVATION (LOOKING AT BACK OF ABUTMENT)

(NTS)

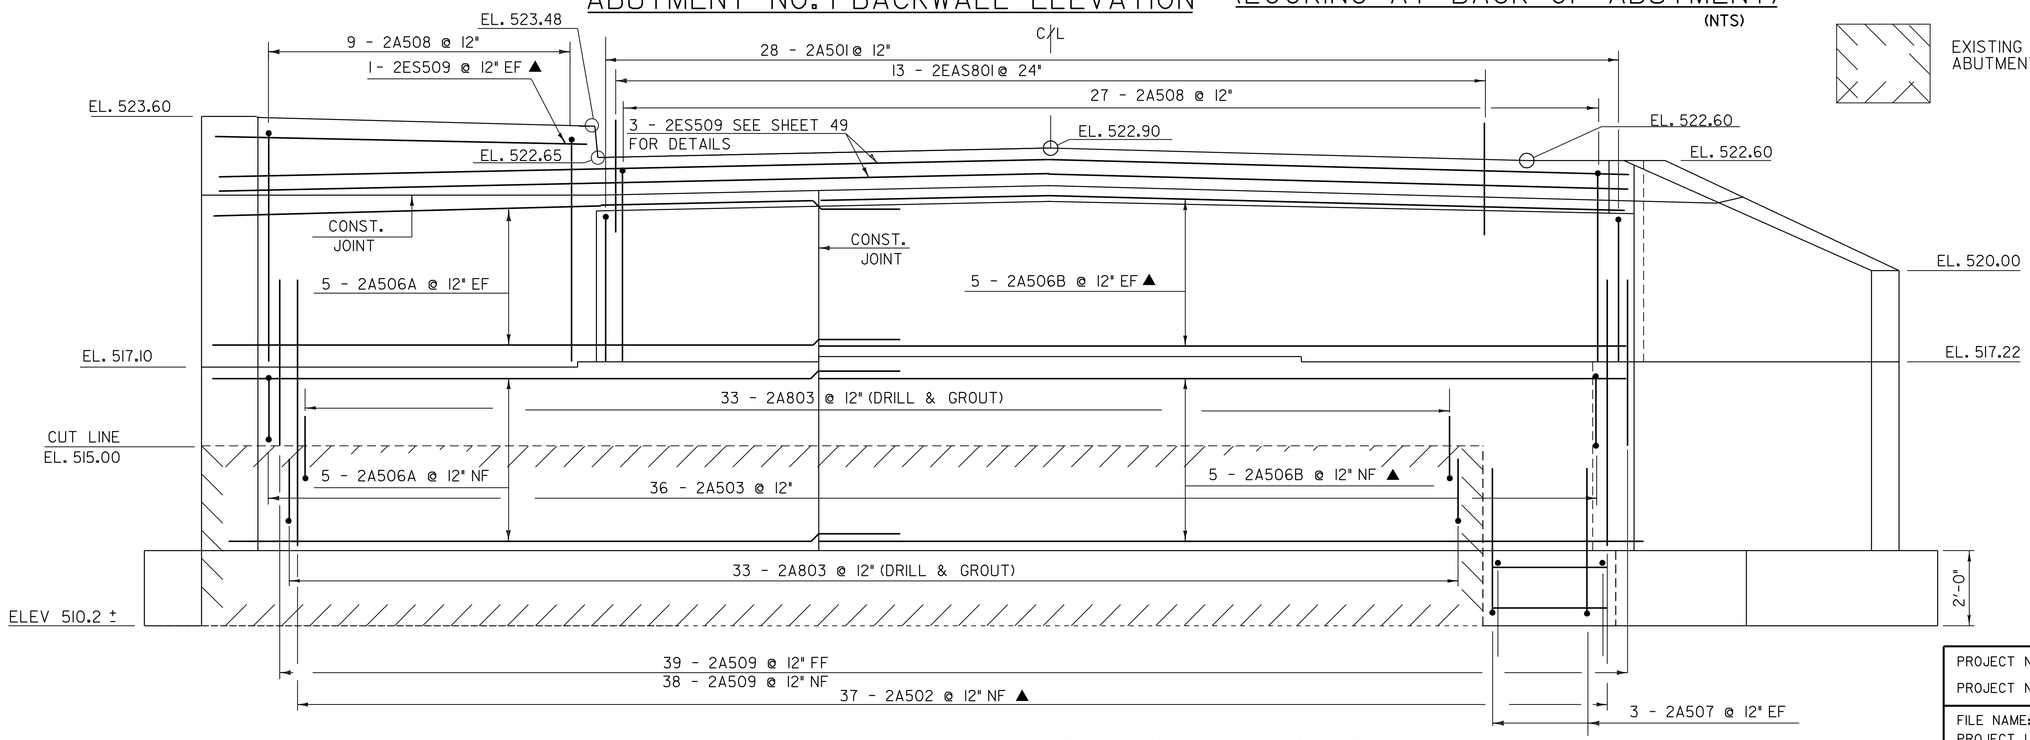

ABUTMENT NO. 2 BACKWALL ELEVATION (LOOKING AT BACK OF ABUTMENT)

SCALE 1/2" = 1'-0

EXISTING ABUTMENT

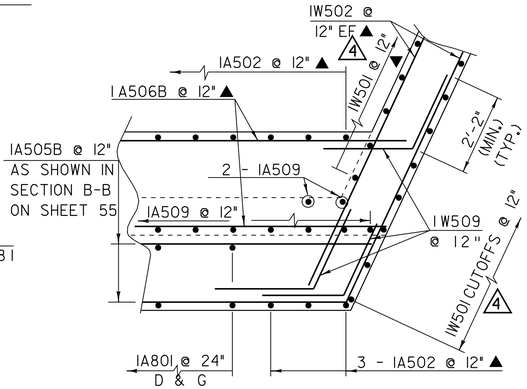

WINGWALL NO. 1 CORNER REINFORCING SECTION E-E

SCALE 1/2" = 1'-0

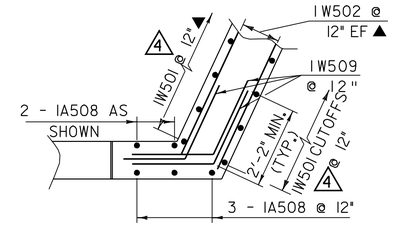

WINGWALL NO. 1 CORNER REINFORCING SECTION F-F

SCALE 1/2" = 1'-0

NOTES:

1. NF = NEAR FACE
2. FF = FAR FACE
3. EF = EACH FACE
4. ▲ = CUT TO FIT IN FIELD
5. 3" CLR. UNLESS OTHERWISE SPECIFIED ON THE PLANS
6. SEE SHEET 57 FOR FOOTING REINFORCING
7. SEE SHEET 56 & 56A FOR CORNER DETAILS.
8. SEE SHEET 55 FOR WW NO. 1 CORNER REINFORCING SECTION D-D

ABUTMENT NO. 1 & NO. 2 BACKWALL DETAILS

PROJECT NAME:	POWNAL
PROJECT NUMBER:	BRZ 1441(19) C/2

FILE NAME: 87e045/str/se045sub.dgn		PLOT DATE: 23-AUG-2010	
PROJECT LEADER: R. WHITCOMB		DRAWN BY: D. PETERSON	
DESIGNED BY: C. CARLSON		CHECKED BY: W. LAMMER	
se045sub3.1		SHEET 53	OF 108