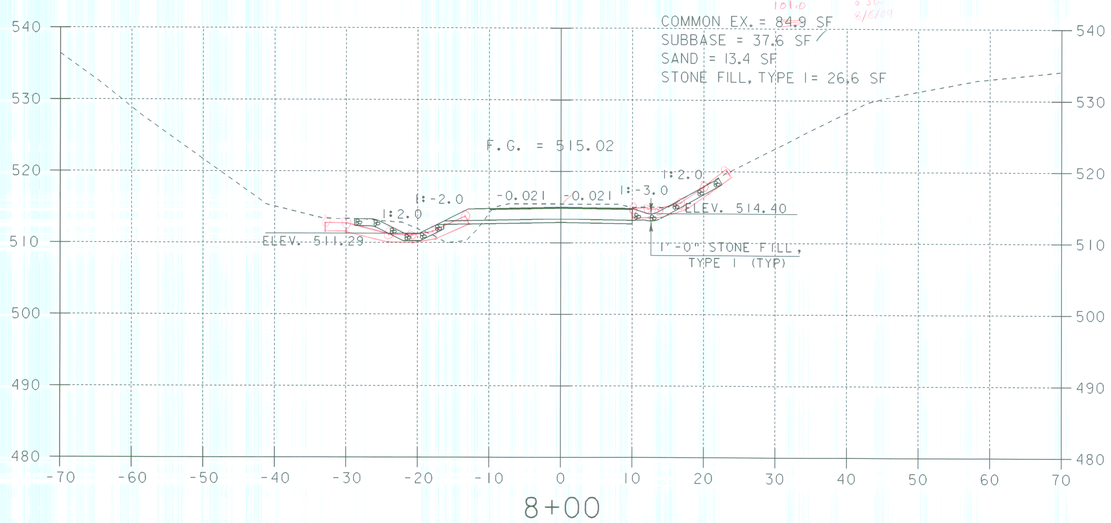

8+00

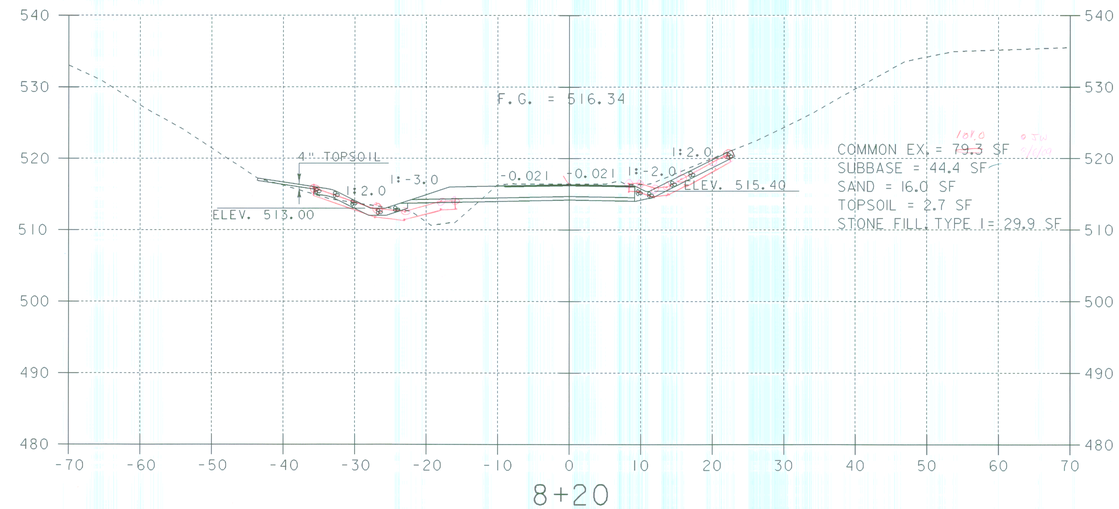

8+20

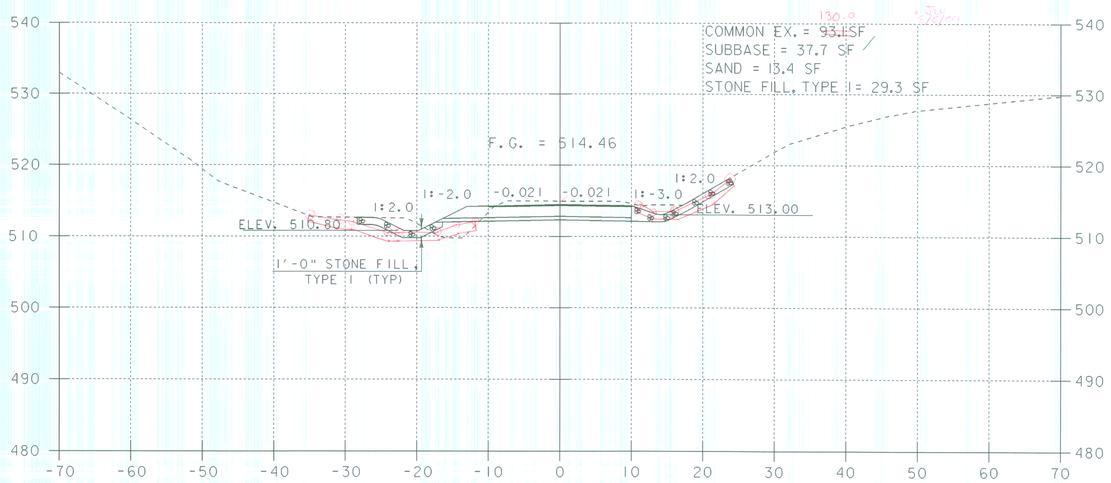

7+90

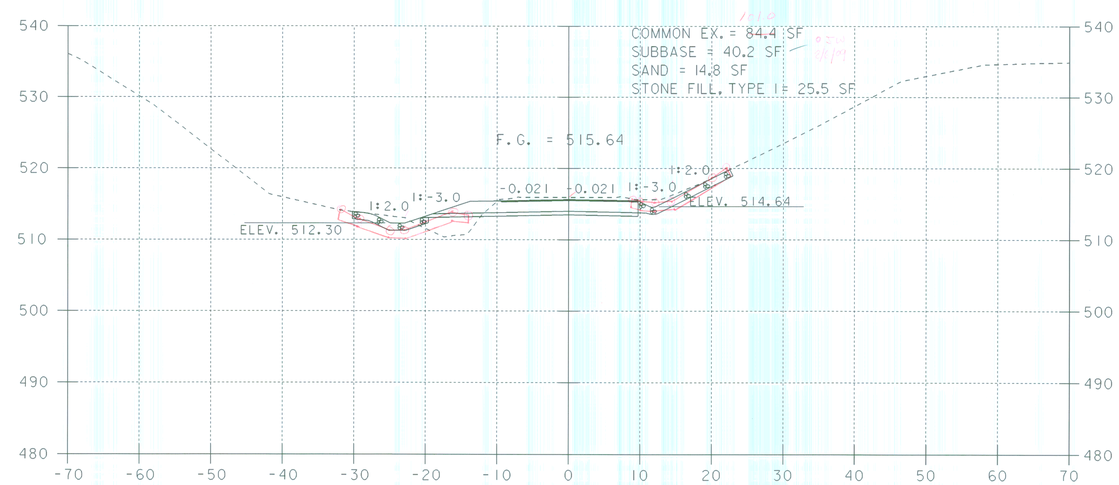

8+10

SCALE 1" = 10'-0
10 0 10

FURLONG ROAD

SHEET NAME:	TOWN HIGHWAY 26 CROSS SECTIONS		
PROJECT NAME:	POWNAL	HIGHWAY NO.:	TH 24
PROJECT NUMBER:	BRZ 1441(19) C/2	BRIDGE NO.:	41
		OVER:	HOOSIC RIVER
FILE NAME: 87e045/str/se045xs2.dgn		PLOT DATE:	19-FEB-2009
PROJECT MANAGER: R. WHITCOMB		DRAWN BY:	J.GILMORE
DESIGNED BY:	C. CARLSON	IPARM NAME:	se045sx6.i
		SHEET 81 OF 108	