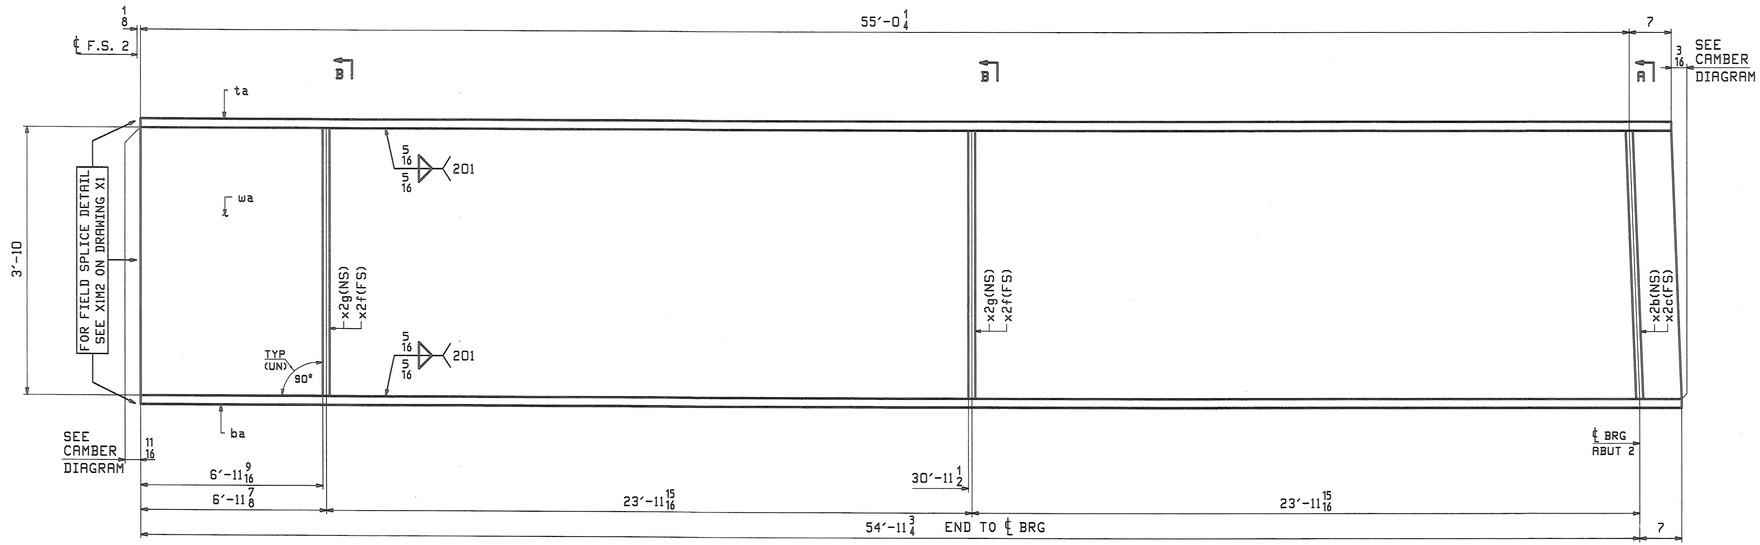

ABM INFO		SHIP	BILL OF MATERIAL					JOB NO.	DRAWING NO.	REV.
								367	14	
PAGE	LINE	MARK	QTY	MARK	MATERIAL	LENGTH FT	LENGTH INCHES	REMARKS	WT	PROCUREMENT NOTES
		14G4C	1		GIRDER				12709	
1	Q		1	wa	PL 5/8×46	55	7 7/16	(A709-50WT2) (H2-3)		
1	G		1	ta	PL 1x18	55	7 1/4	(A709-50WT2) (H2-3)		
1	G		1	ba	PL 1x18	55	6 3/4	(A709-50WT2) (H2-3)		
2	N		1	x2b	PL 7/8×8 1/2	3	10	MIE		
2	N		1	x2c	PL 7/8×8 1/2	3	10	MIE		
2	P		2	x2f	PL 5/8×8	3	10			
2	P		2	x2g	PL 5/8×8	3	10			

ONE - GIRDER - 14G4C

FOR GIRDER STANDARDS SEE DRAWINGS X1 & X2.
FOR CAMBER & FLANGE DIAGRAMS SEE DRAWING C2.
FOR GENERAL NOTES & WELD PROCEDURES SEE DRAWING GN1.
H2-3 DENOTES MATERIAL SUBJECT TO CHARPY V-NOTCH TESTING.

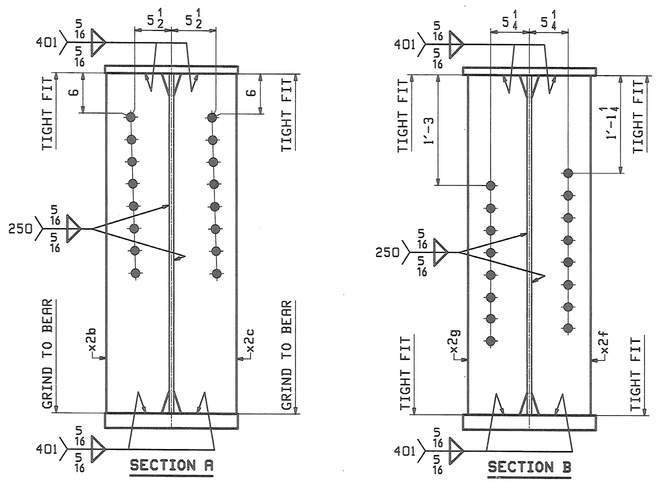

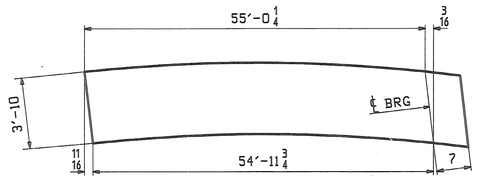

ORIENTATION DIAGRAM
FOR CAMBER SEE DWG C2

RECEIVED
CK'D BY WRA CK'D BY AWC
MAY 15 2008 ✓
RESUBMIT ____ APPROVED ____
BY DATE

REV.	DATE	REMARKS	DWN	CHK	APVL	SHOP
0					5-12-08	

MATERIAL:	SURFACE PREP. & PAINT:	HOLES:	SHOP BOLTS:
A709-50W (UN)	SEE DWG GN1	15/16"Ø	NONE

DESCRIPTION: GIRDER - 14G4C

CASCO BAY STEEL STRUCTURES, INC.
75 SPRING HILL ROAD SACO, MAINE 04072
PHONE (207) 282-7360 FAX. (207) 282-1179
TENSOR 2776

STRUCTURE: TH24 over Hoosic River BRIDGE NO. 41 POWNAL, VERMONT COUNTY OF BENNINGTON	DRAWN: JTB	DATE: 04/25
	CHK'D: TM	DATE: 05/05
LOCATION: TOWN OF POWNAL	JOB NO.	DWG NO.
PROJ NO. BRZ 1441 (19) C/2	367	14
CUSTOMER: VERMONT AGENCY OF TRANSPORTATION		REV. △

ITB Tue May 6 13:38:03 EDT 2008 /users/jobs/2776/14 1 Rev0