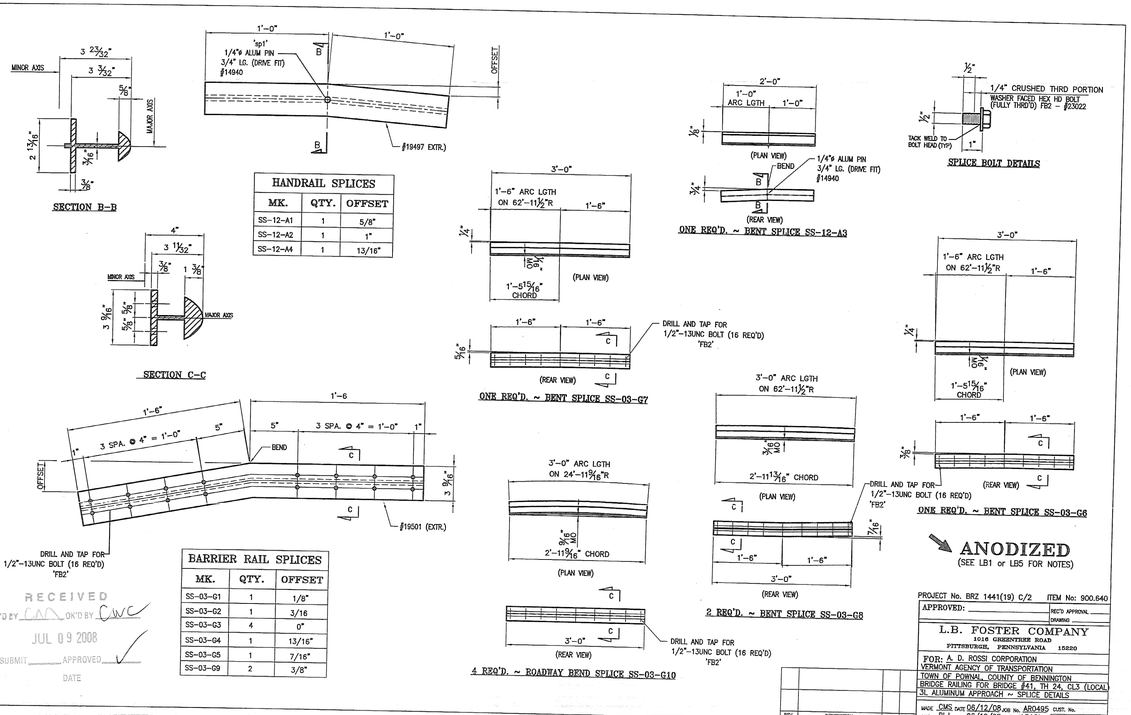

ANODIZED
(SEE LB1 or LB5 FOR NOTES)

RECEIVED
OK'D BY CMS OK'D BY CWC
JUL 09 2008
RESUBMIT ____ APPROVED ✓
BY DATE

PROJECT No. BRZ 1441(19) C/2 ITEM No: 900.640
APPROVED: ____ REQ'D APPROVAL ____ DRAWING

L.B. FOSTER COMPANY
1016 GREENTREE ROAD
PITTSBURGH, PENNSYLVANIA 15220

FOR: A. D. ROSSI CORPORATION
VERMONT AGENCY OF TRANSPORTATION
TOWN OF POWNAL, COUNTY OF BENNINGTON
BRIDGE RAILING FOR BRIDGE #41, TH 24, CL3 (LOCAL)
3L ALUMINUM APPROACH ~ SPLICE DETAILS

MADE CMS DATE 06/12/08 JOB No. AR0495 CUST. No.
CHECK BLJ DATE 06/19/08 DRAWING LB160A97 REV. No.

REV.	DESCRIPTION	BY	DATE