BRIDGE RAILING - HEAVY DUTY STEEL BEAM/FASCIA MOUNTED/STEEL TUBING

REV STA 50+53 - REV STA 51+78 LT & RT

HEAVY DUTY STEEL BEAM GUARDRAIL

REV STA 50+23 - REV STA 50+53 LT
REV STA 50+36 - REV STA 50+53 RT
REV STA 51+78 - REV STA 52+39 LT
REV STA 51+78 - REV STA 52+25 RT

ANCHOR FOR STEEL BEAM RAIL

REV STA 52+33 LT
REV STA 52+24 RT

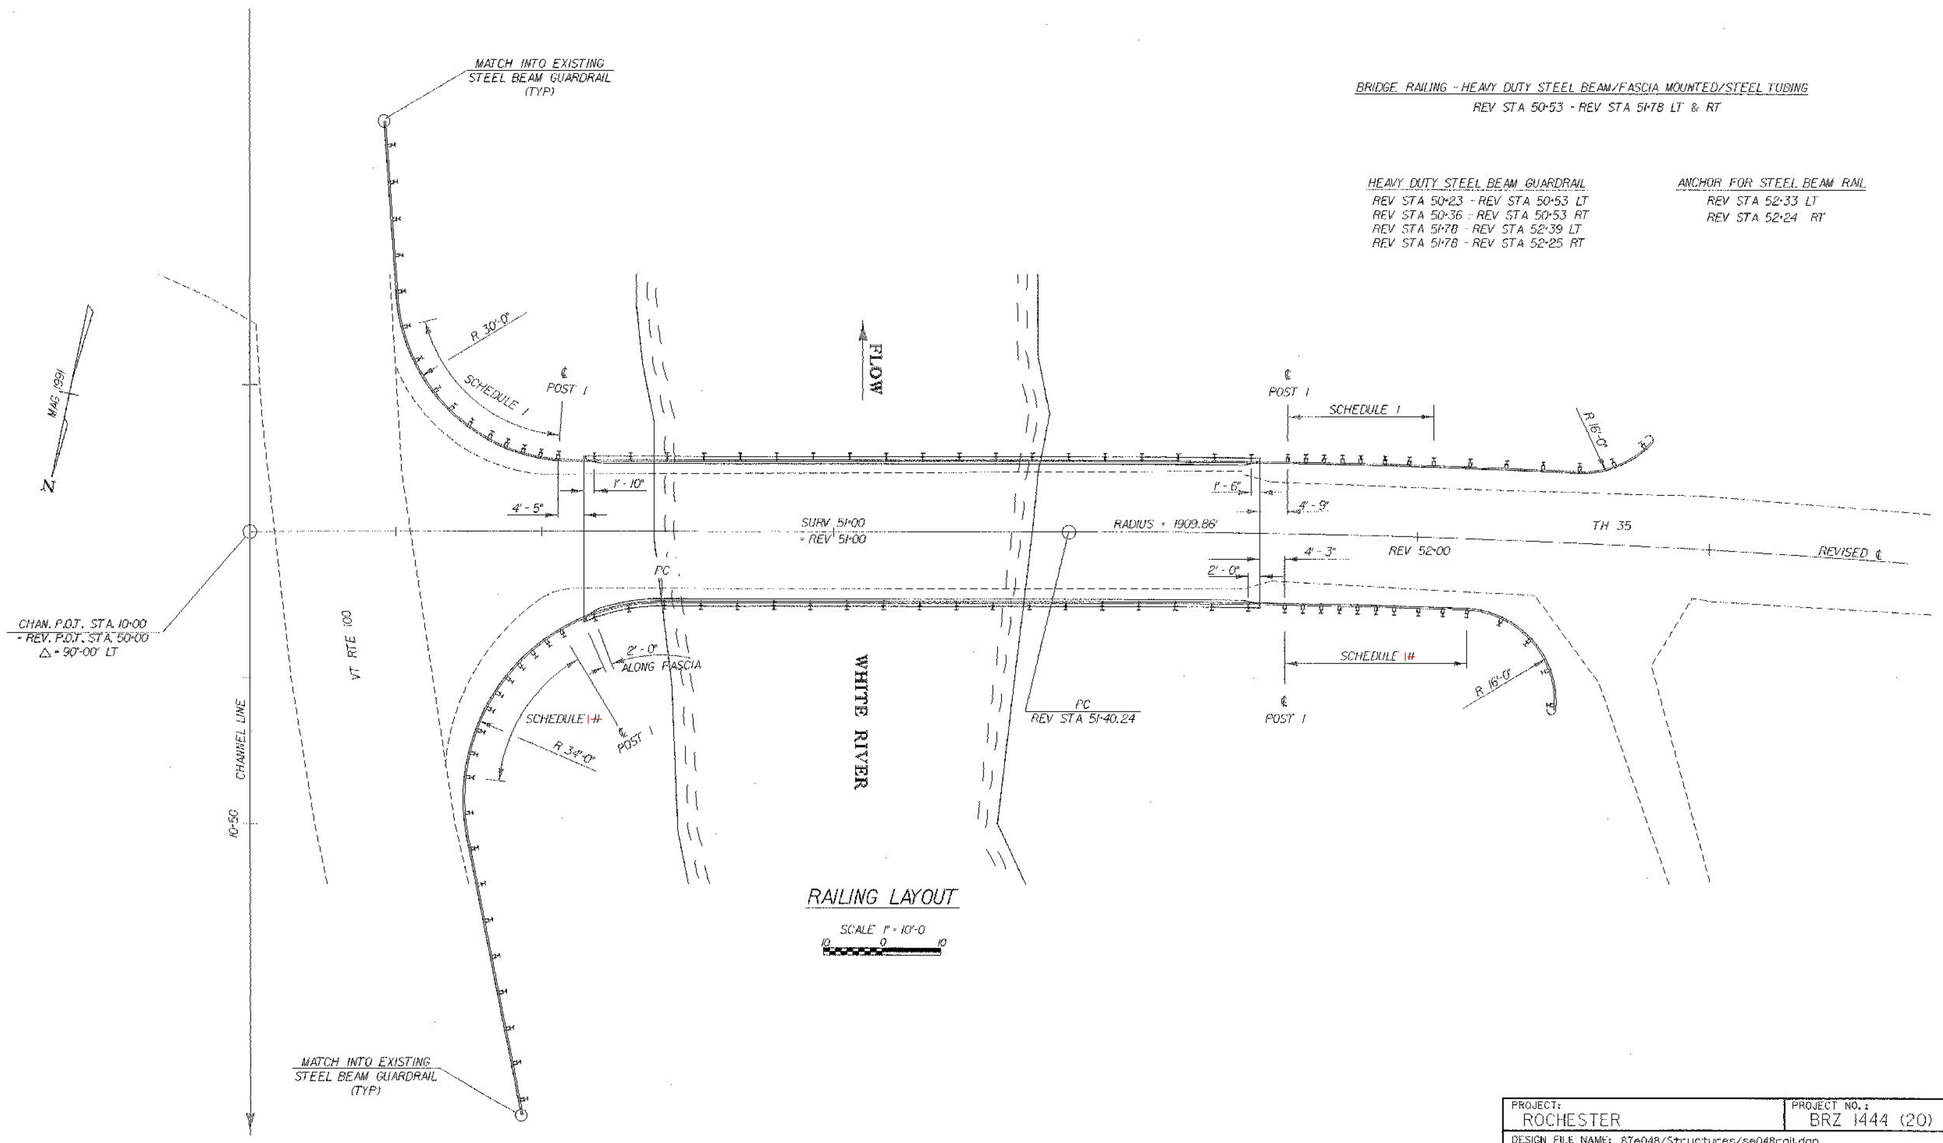

RAILING LAYOUT

SCALE 1" = 10'-0

PROJECT: ROCHESTER	PROJECT NO.: BRZ 1444 (20)
DESIGN FILE NAME: 87e048/Structures/se048rail.dgn	
IPARM FILE NAME: se048rail.I	PLOT DATE: 25-JAN-2002
SURVEYED BY: GILMAN	SURVEY DATE: 3/91
SQUAD LEADER: C.P. WILLIAMS	DRAWN BY: P. ROWE
RAILING LAYOUT	SHEET: 37 OF 52