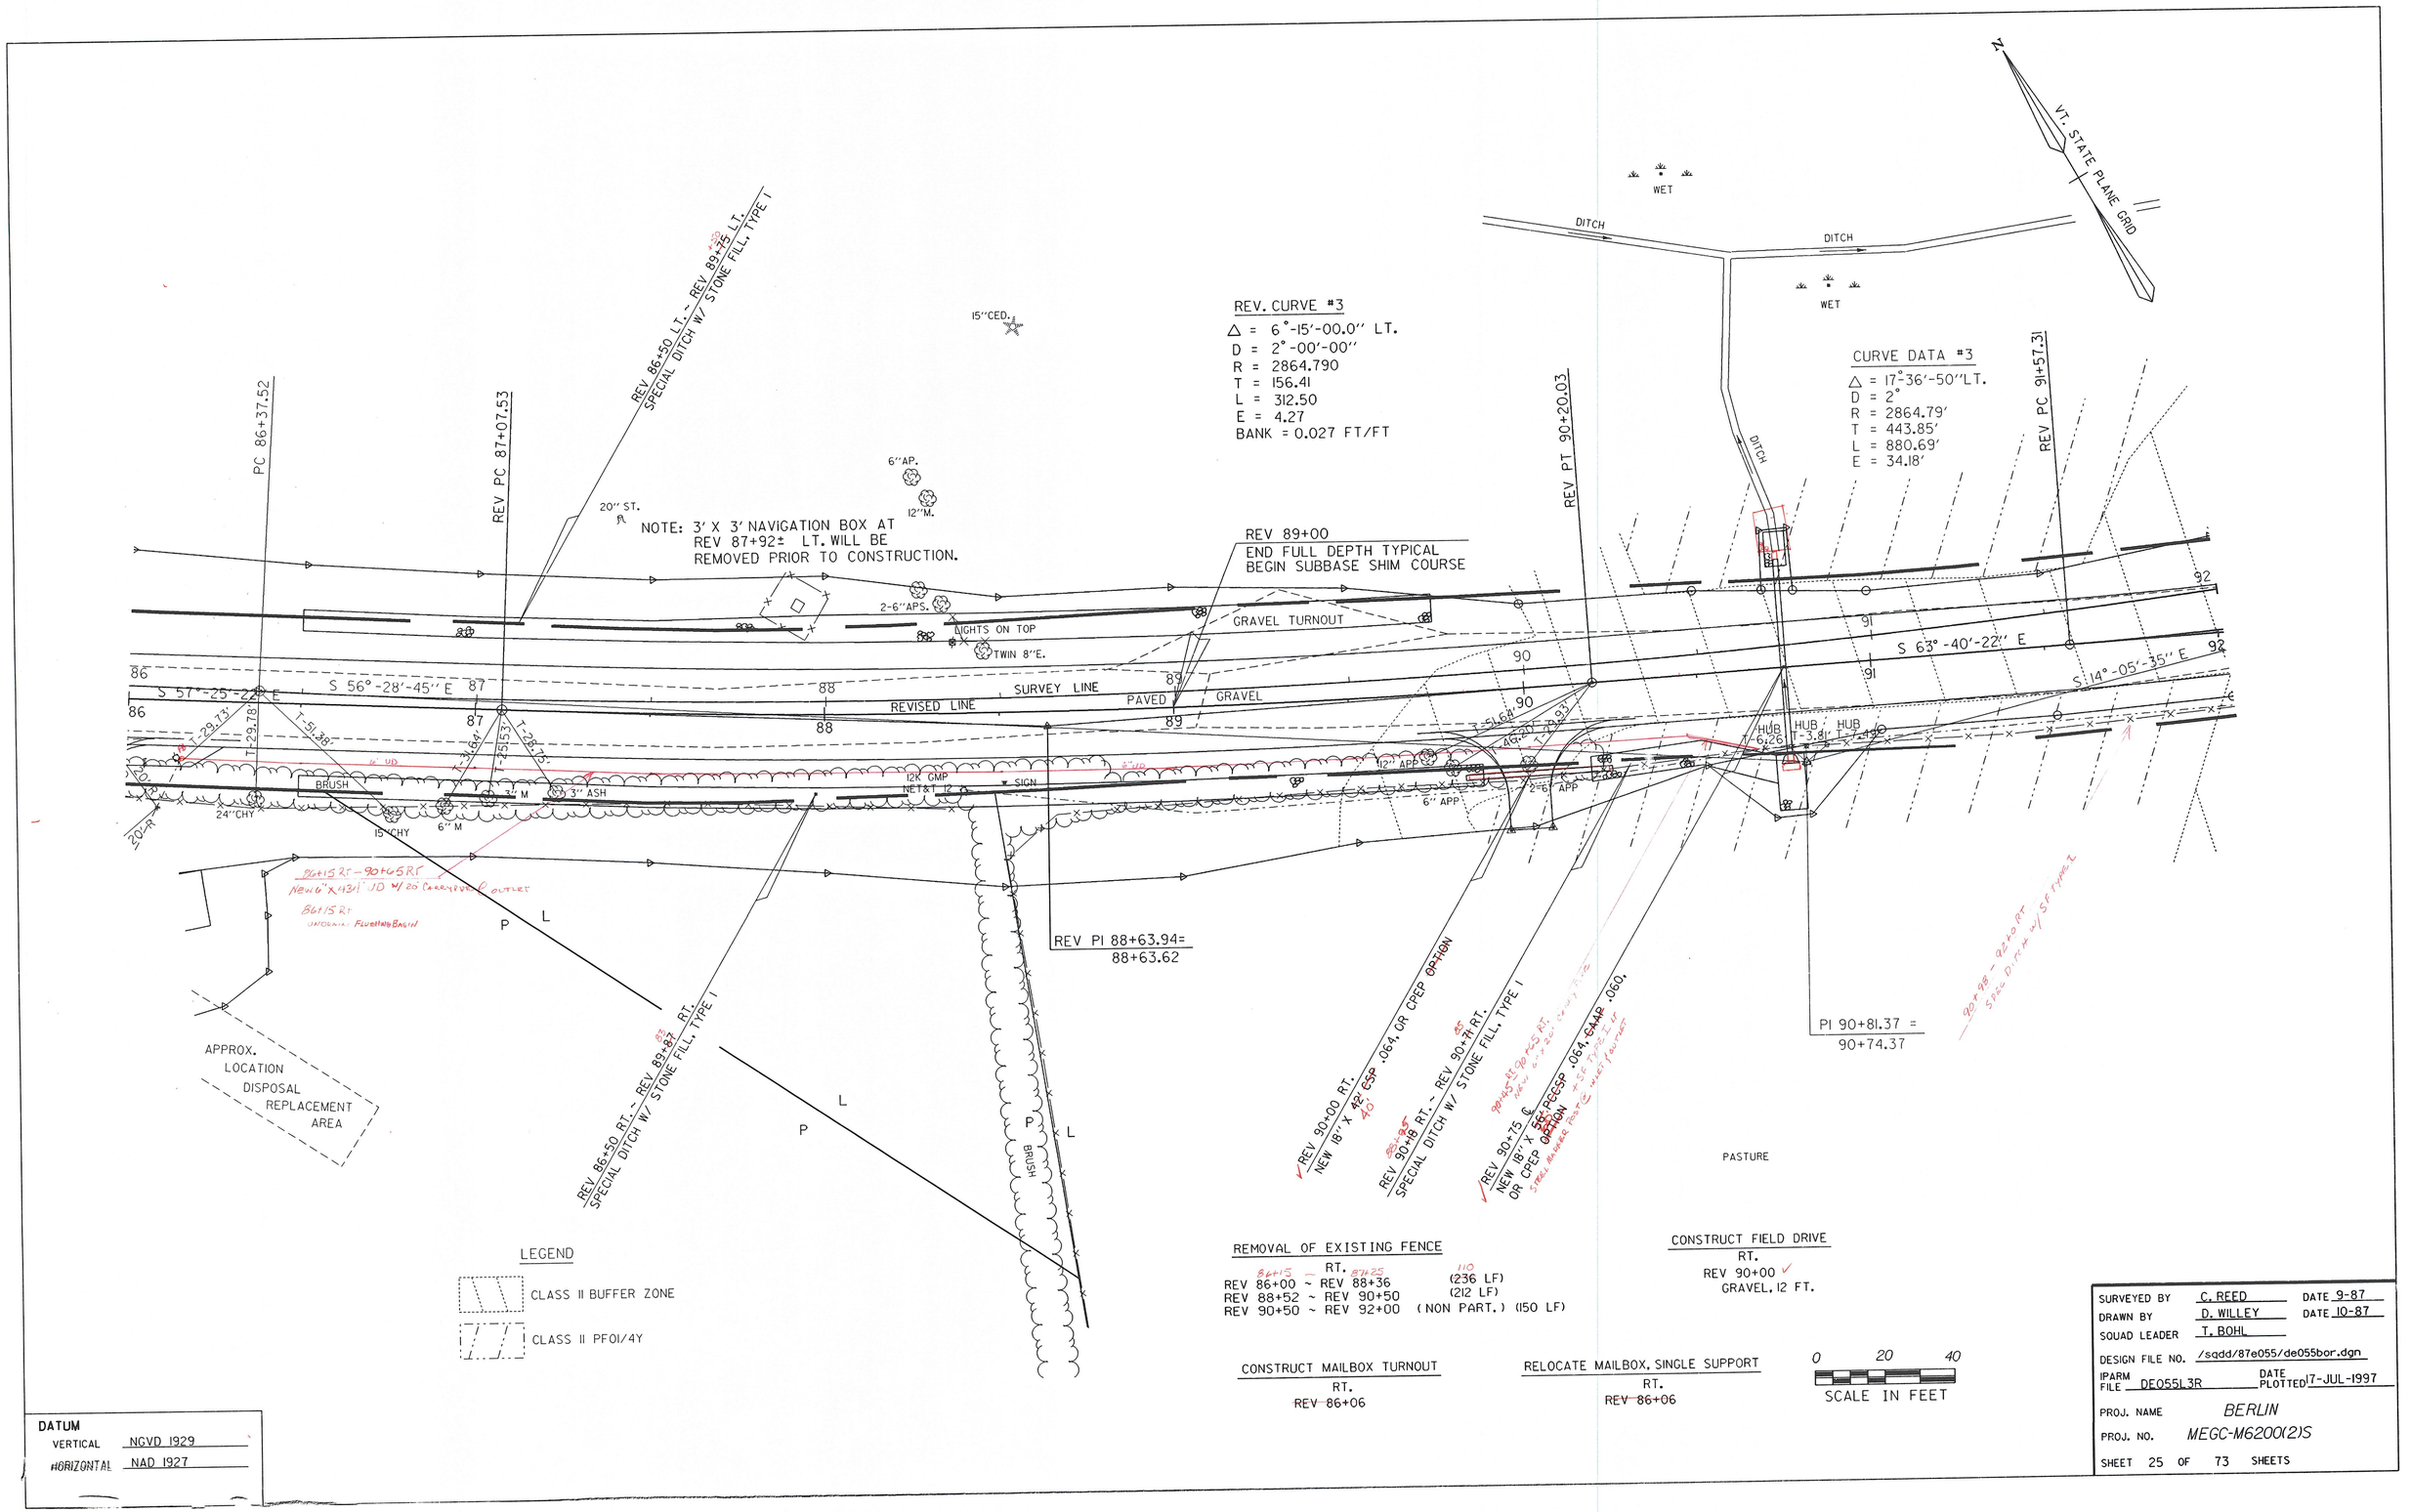

LEGEND

CLASS II BUFFER ZONE

CLASS II PF01/4Y

REMOVAL OF EXISTING FENCE

RT.

REV 86+00 ~ REV 88+36	(236 LF)	
REV 88+52 ~ REV 90+50	(212 LF)	
REV 90+50 ~ REV 92+00	(NON PART.)	(150 LF)

CONSTRUCT FIELD DRIVE

RT.

REV 90+00

GRAVEL, 12 FT.

CONSTRUCT MAILBOX TURNOUT

RT.

REV 86+06

RELOCATE MAILBOX, SINGLE SUPPORT

RT.

REV 86+06

0 20 40

SCALE IN FEET

DATUM

VERTICAL NGVD 1929

HORIZONTAL NAD 1927

SURVEYED BY	C. REED	DATE	9-87
DRAWN BY	D. WILLEY	DATE	10-87
SQUAD LEADER	T. BOHL		
DESIGN FILE NO.	/sqdd/87e055/de055bor.dgn		
IPARM FILE	DE055L3R	DATE PLOTTED	17-JUL-1997
PROJ. NAME	BERLIN		
PROJ. NO.	MEGC-M6200(2)S		
SHEET	25 OF 73 SHEETS		