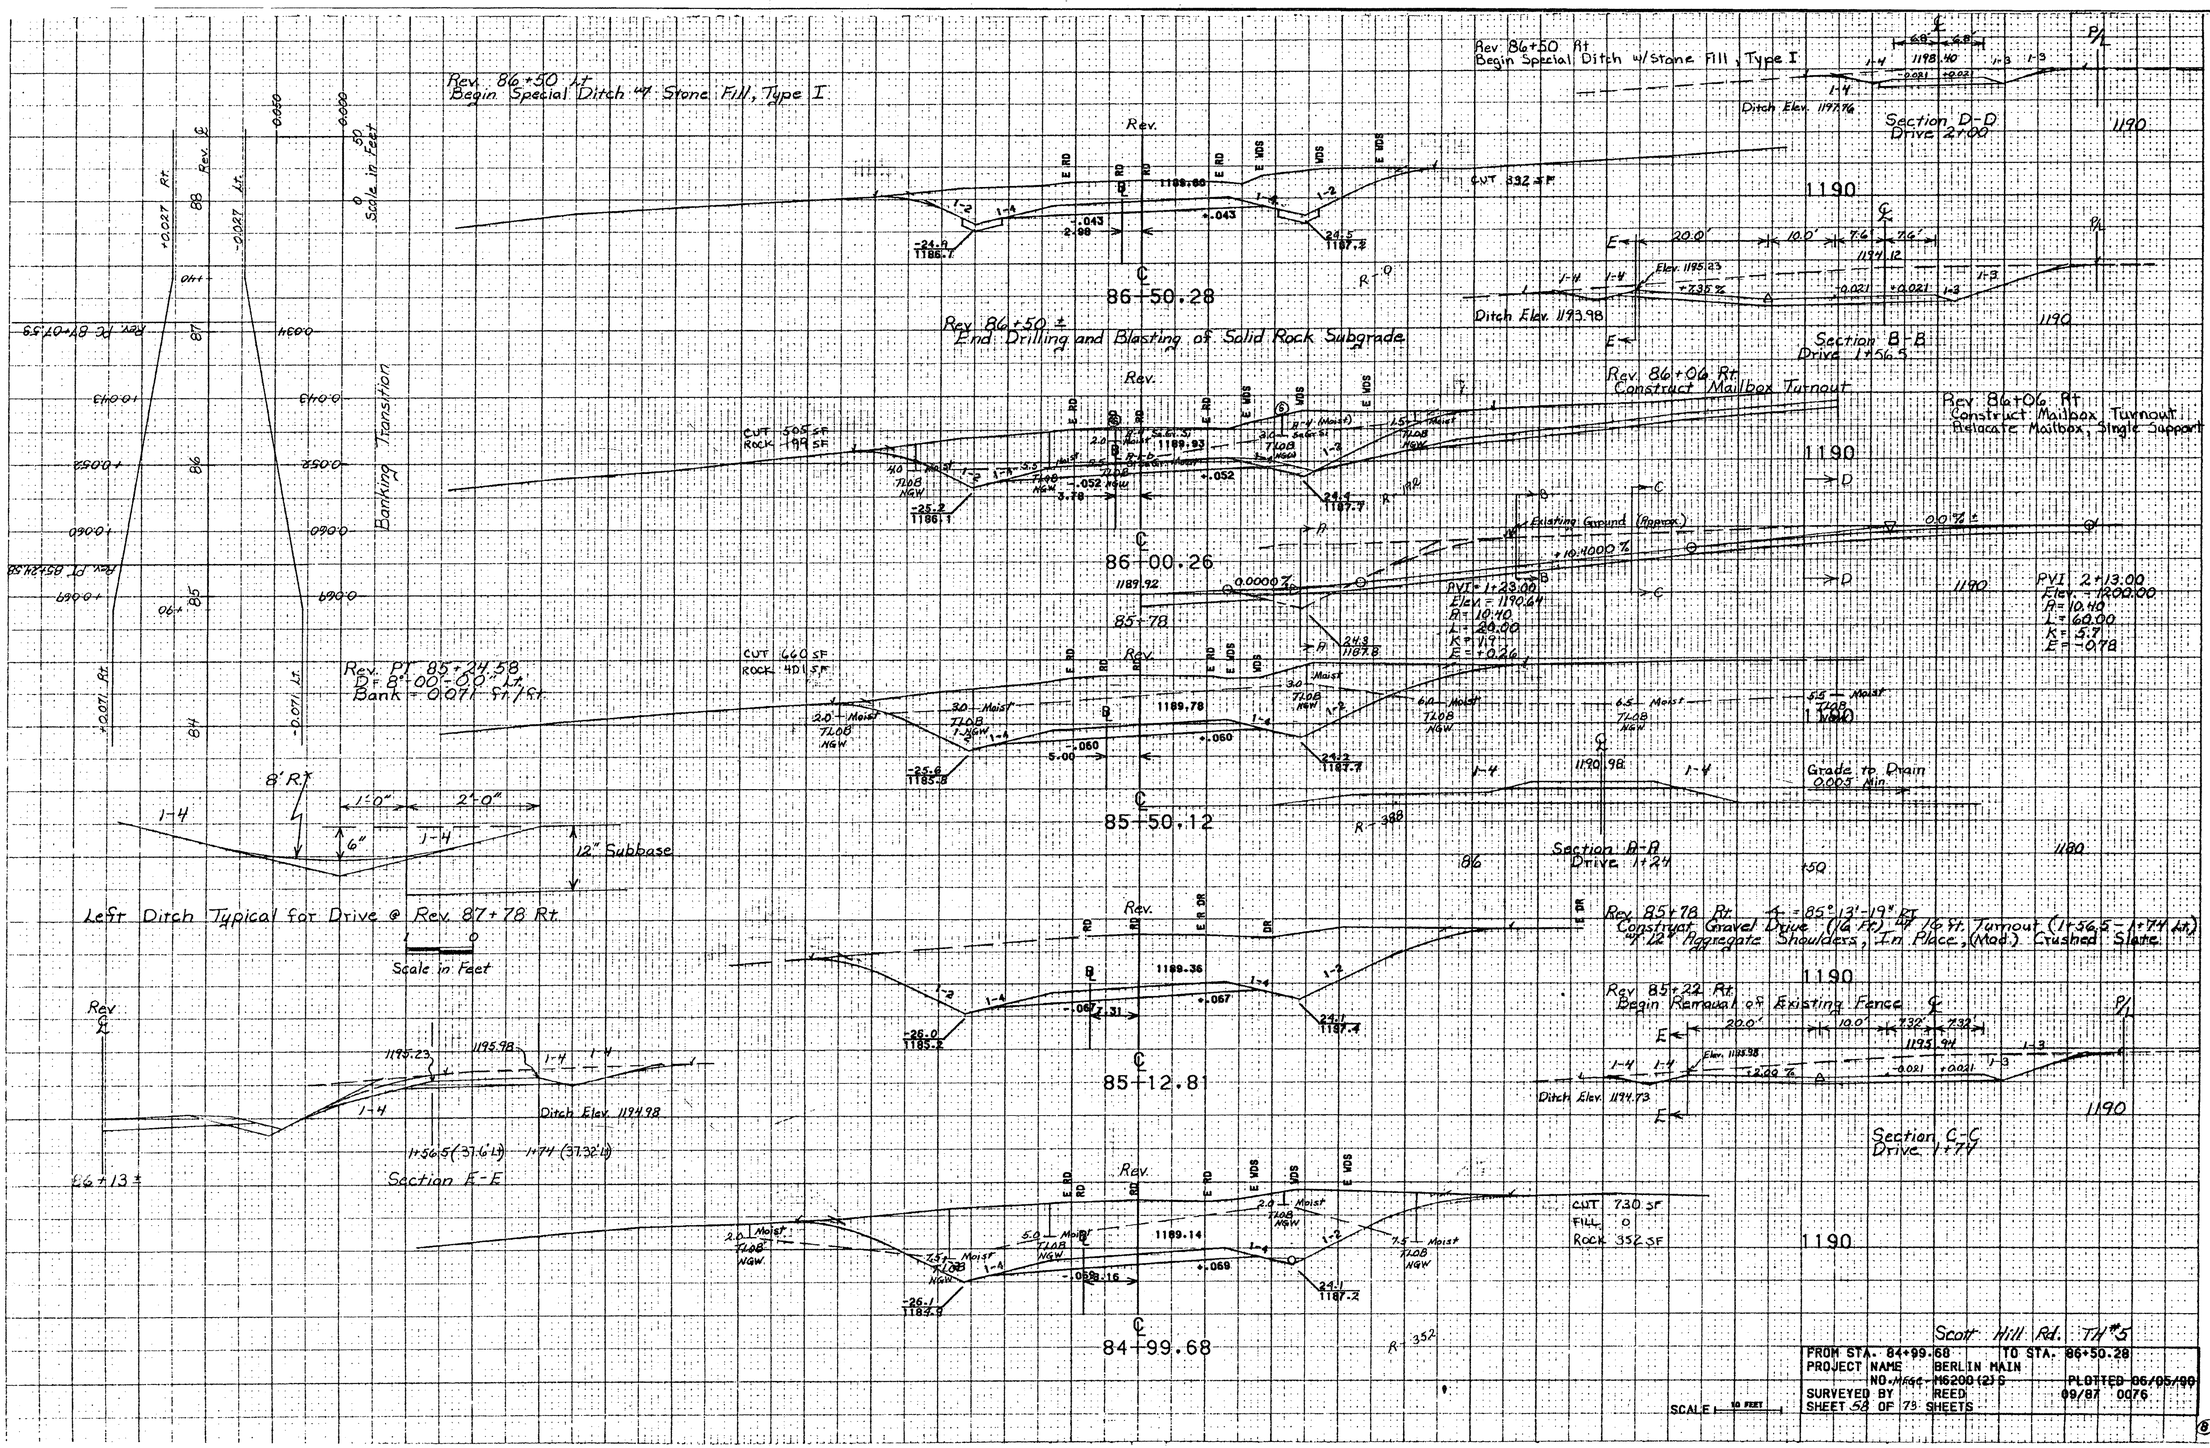
Rev. 86+50 Lt
Begin Special Ditch w/ Stone Fill, Type I
Rev. 86+50 Rt
Begin Special Ditch w/Stone Fill, Type I
Section D-D
Drive 2+00
Rev. 86+50 ±
End Drilling and Blasting of Solid Rock Subgrade
Section B-B
Drive 1+56.5
Rev. 86+06 Rt
Construct Mailbox Turnout
Rev. 86+06 Rt
Construct Mailbox Turnout
Relocate Mailbox Single Support
Rev. PT 85+24.58
D = 8°-00'-00" Lt
Bank = 0.071 ft/ft
Banking Transition
Scale in Feet
Grade to Drain
0.005 Min.
Section A-A
Drive 1+24
Left Ditch Typical for Drive @ Rev. 87+78 Rt
Rev. 85+78 Rt
Construct Gravel Drive (16 Ft) & 16 ft. Turnout (1+56.5 - 1+74 Lt)
w/ 12" Aggregate Shoulders, In Place, (Mod.) Crushed Slate
Rev. 85+22 Rt
Begin Removal of Existing Fence
Section C-C
Drive 1+74
Section E-E
Scott Hill Rd. TH #5
FROM STA. 84+99.68 TO STA. 86+50.28
PROJECT NAME BERLIN MAIN
NO. M6200(2)0 PLOTTED 06/05/99
SURVEYED BY REED 09/97 0076
SHEET 58 OF 73 SHEETS
SCALE 10 FEET