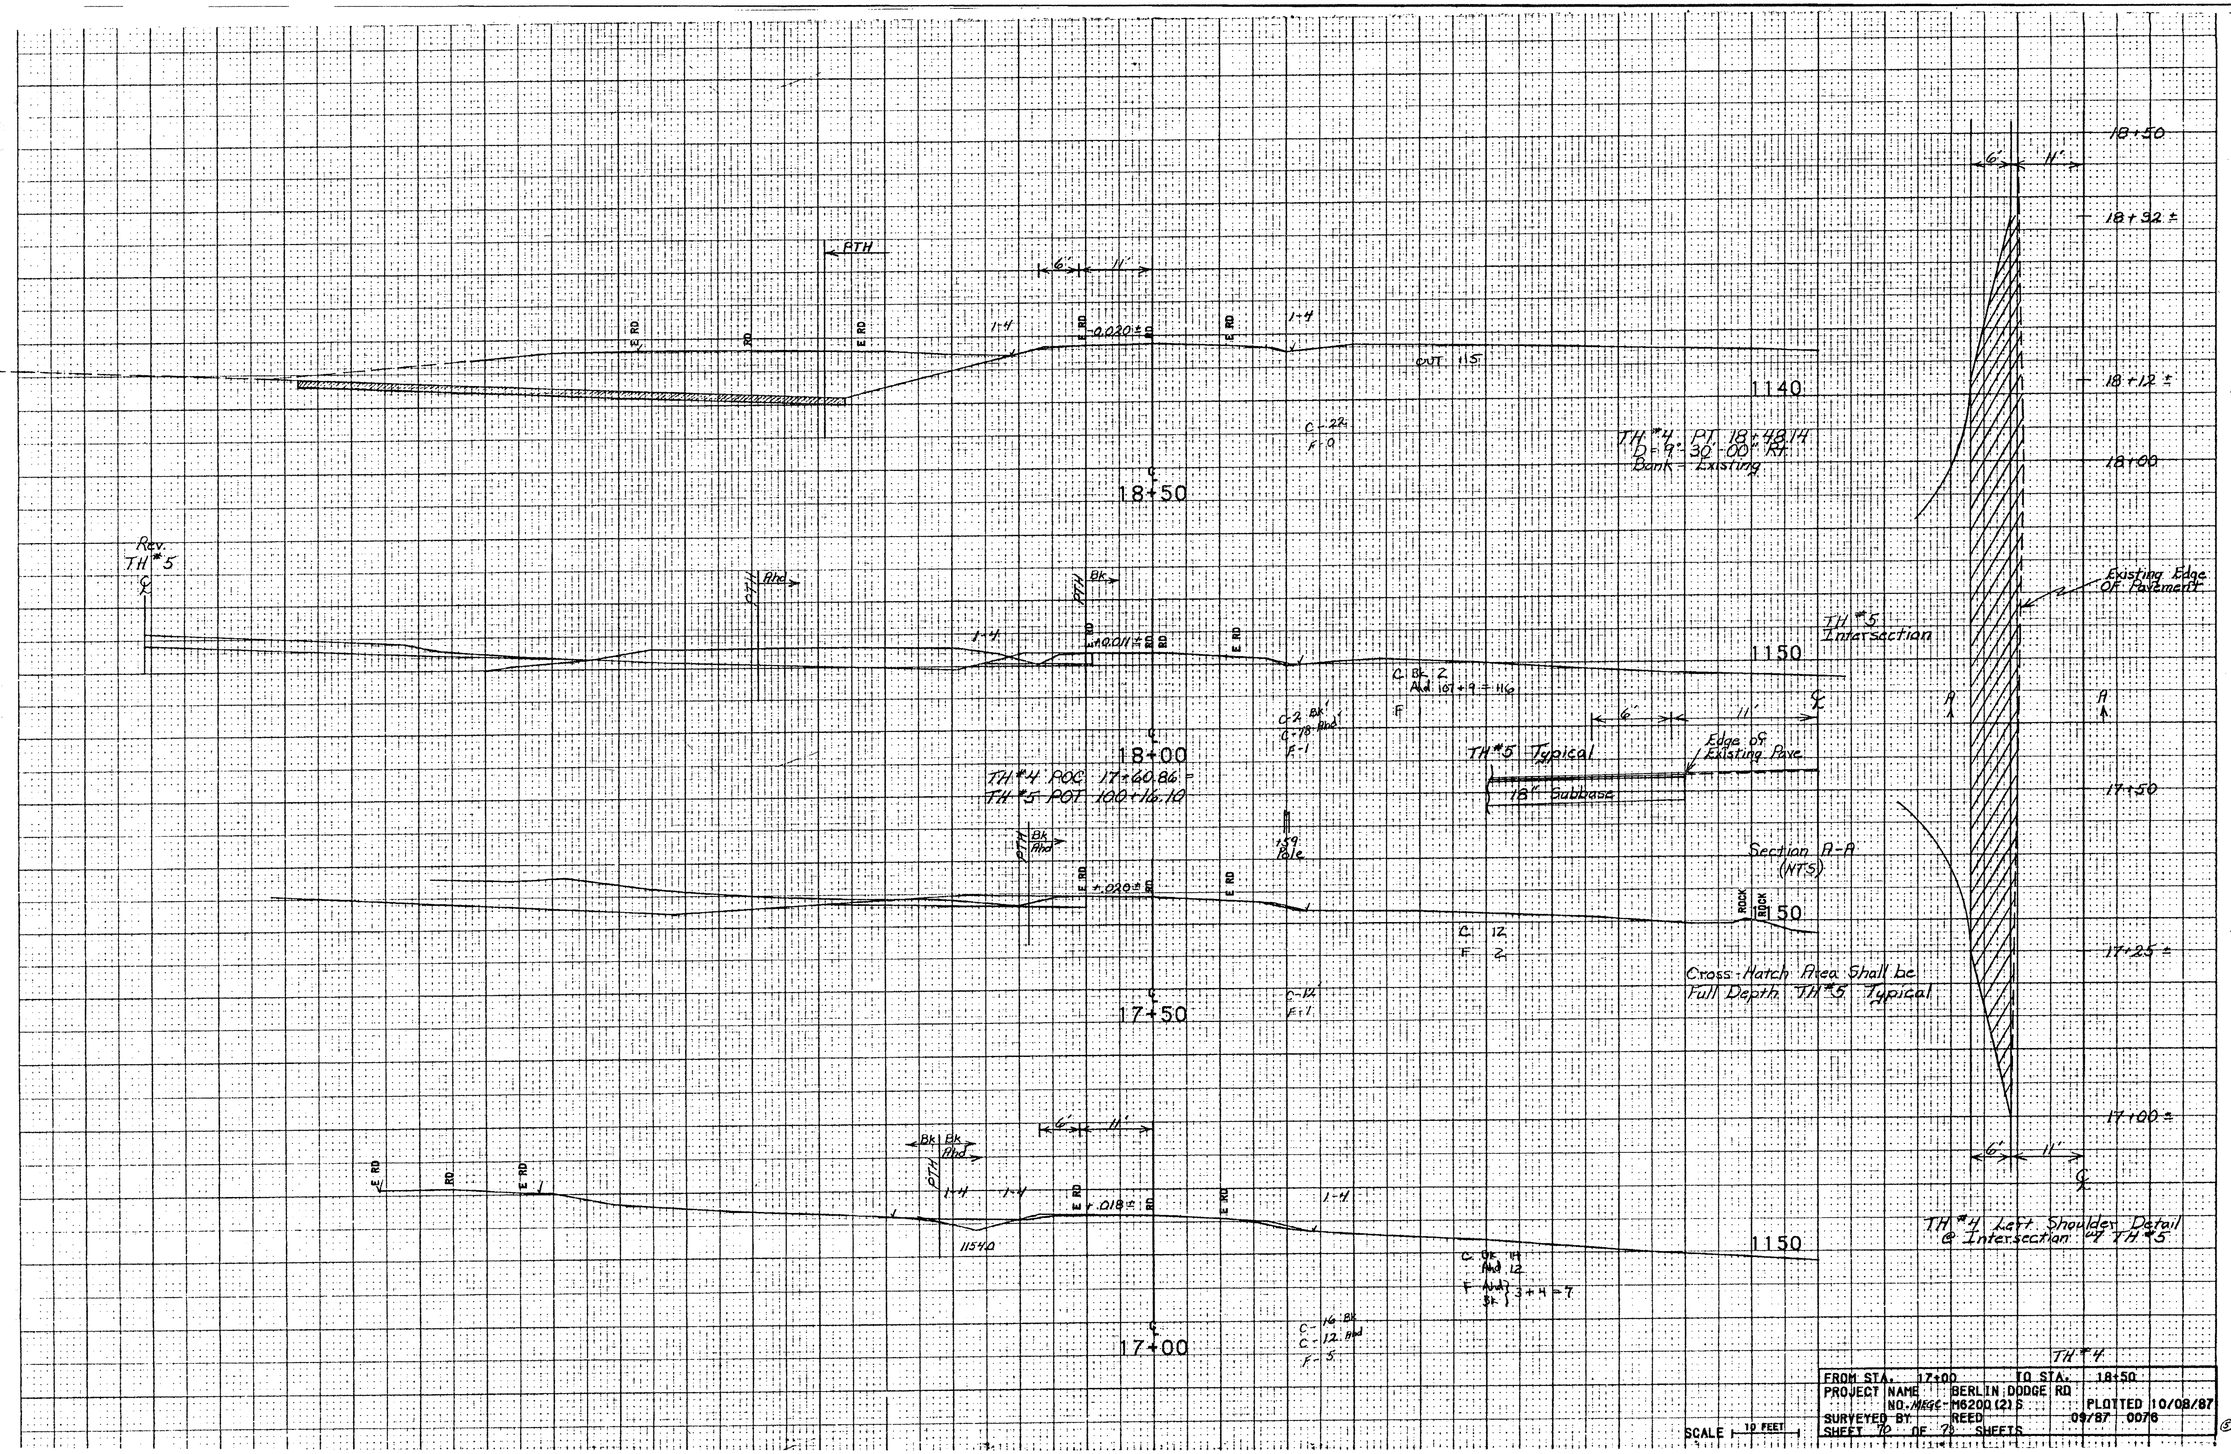

FROM STA. 17+00		TO STA. 18+50	
PROJECT NAME	BERLIN DODGE RD		
NO. MEGC-M6200(2)S			PLOTTED 10/08/87
SURVEYED BY	REED		09/87 0076
SHEET 70 OF 78 SHEETS			

5