


BERLIN MEGC M6200(2)S
 REVISED SECTIONS
 SCOTT HILL ROAD
 73+50 - 77+50

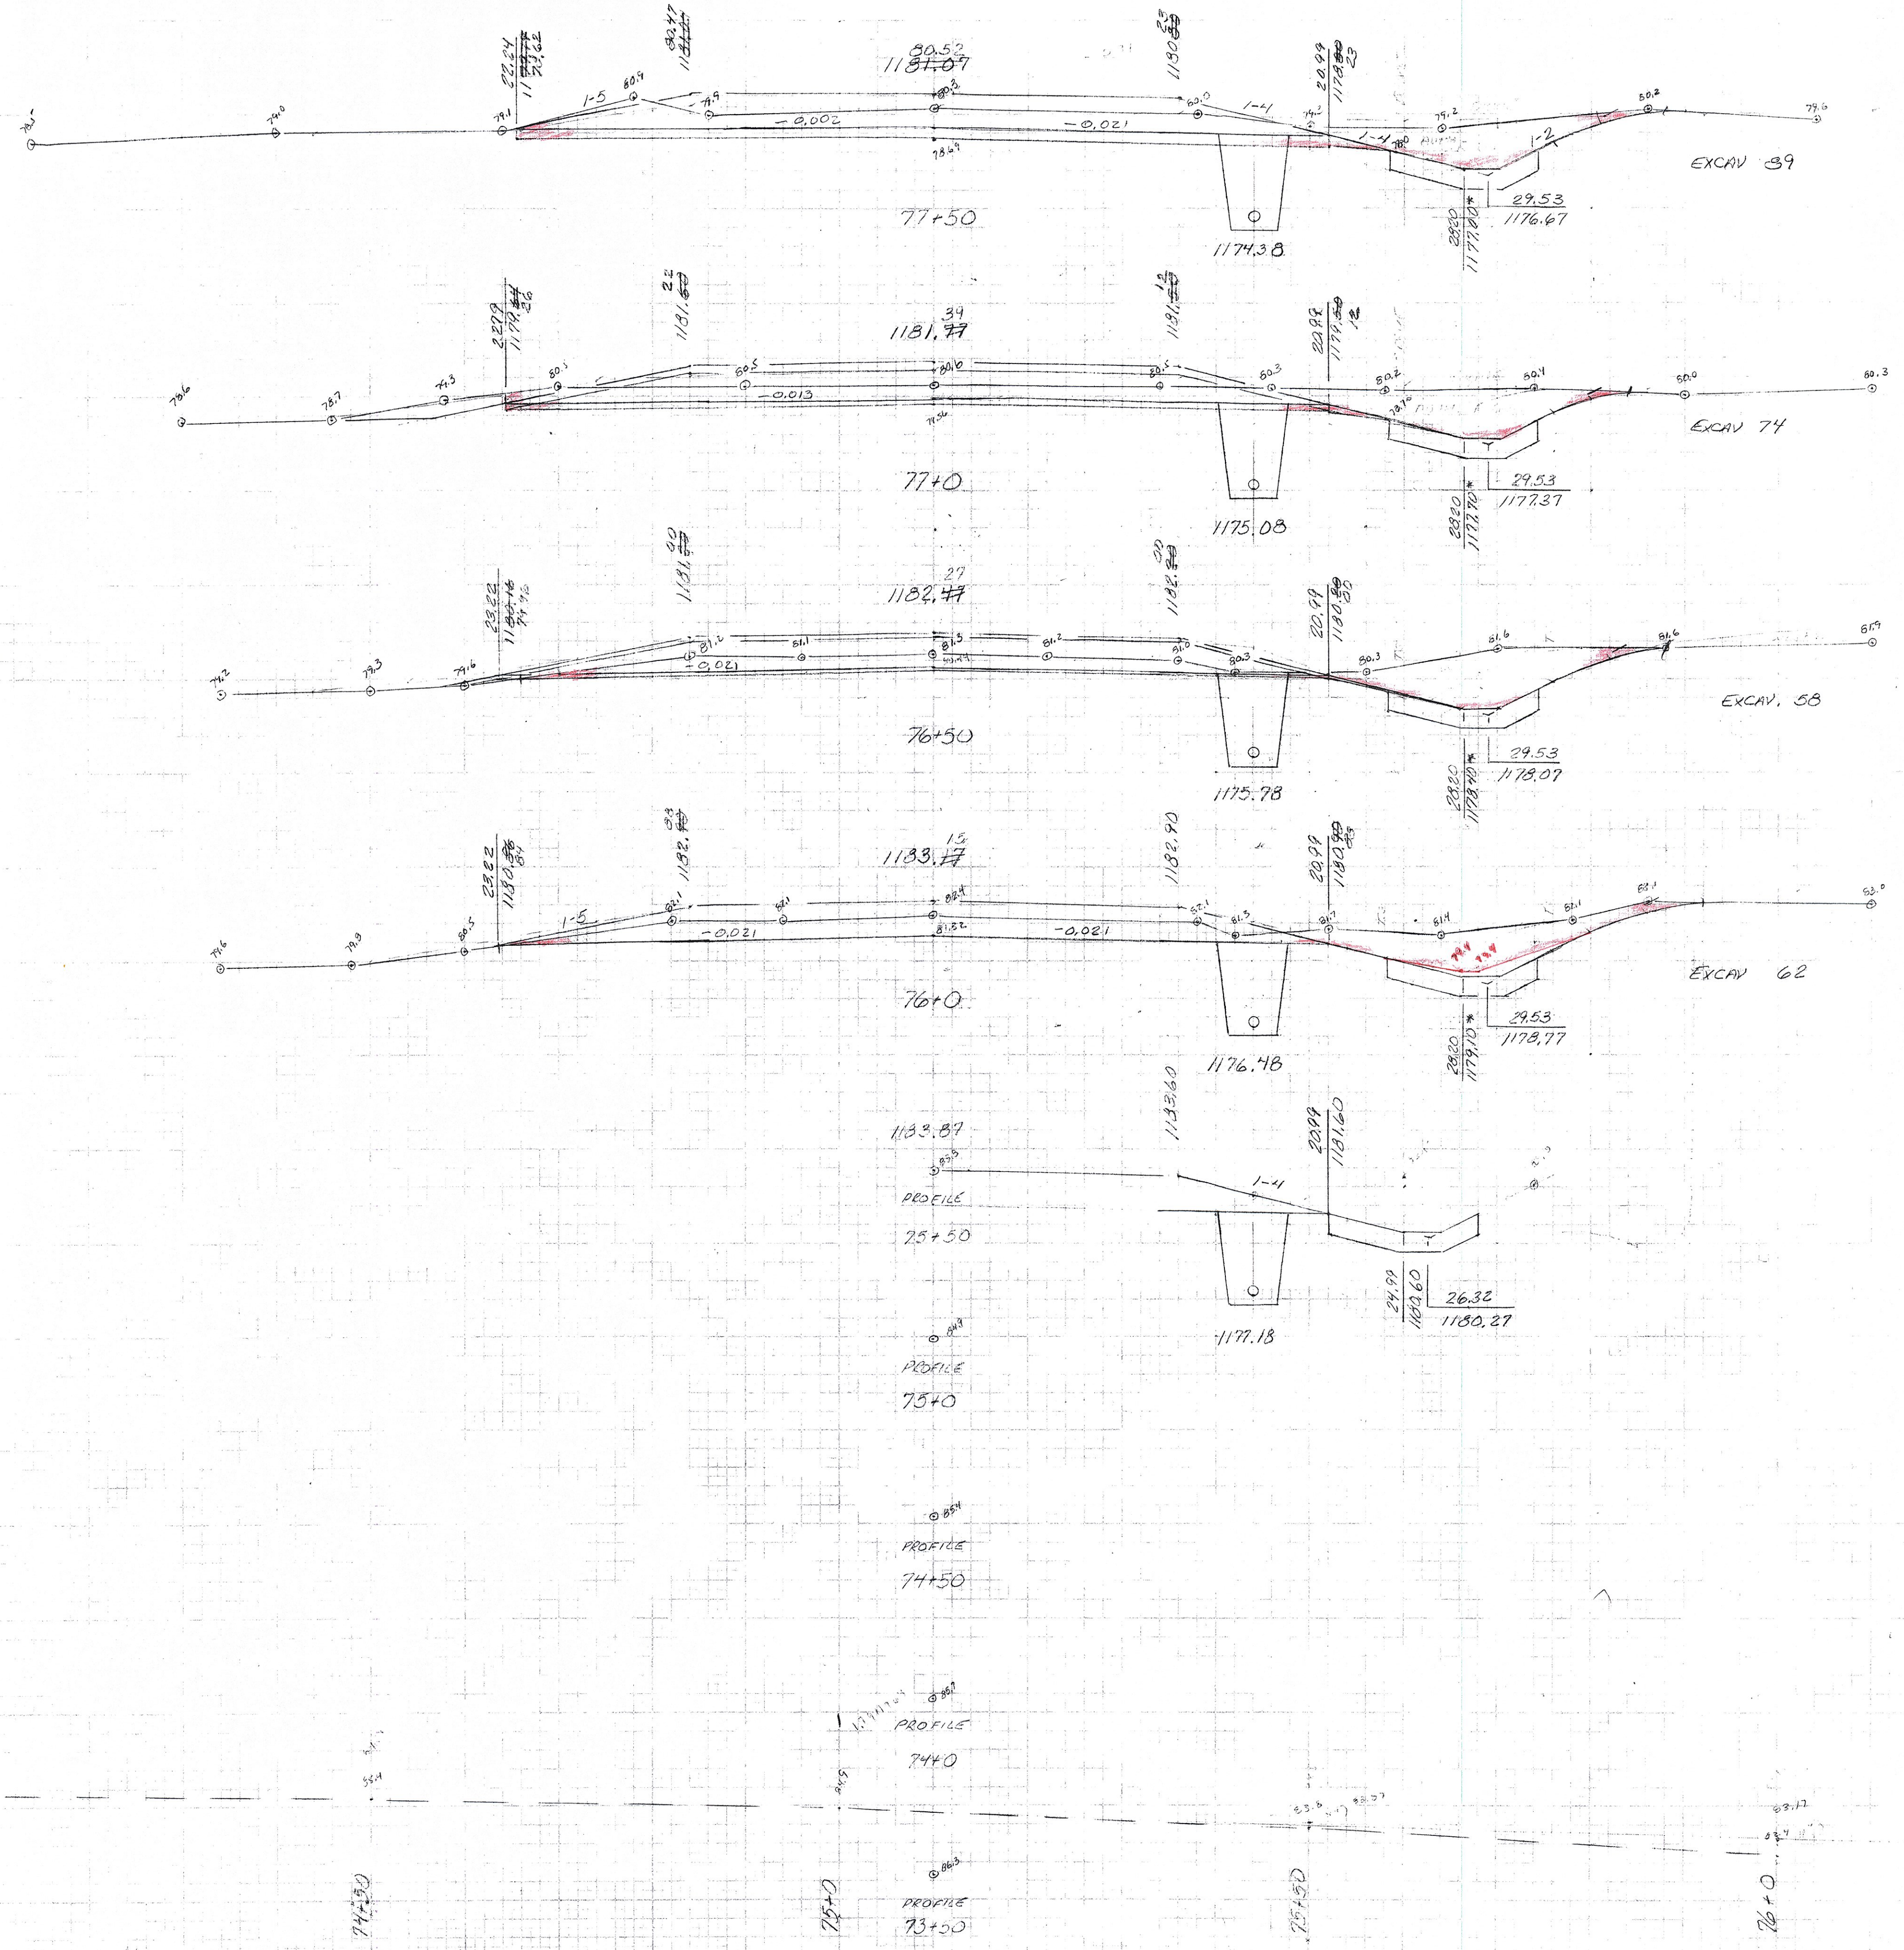

Comp. - Cassette - Mark
 R. Conn.
 Hilltop Data Rev. 6/22/93
 R. Conn.

* No change in the ditch, alterations of top were constructed before the grade was changed.