


BEGIN MEBC M 2200(2) =
 REVISED SECTIONS
 SCOTT HILL ROAD
 81+50 ~ 84+50

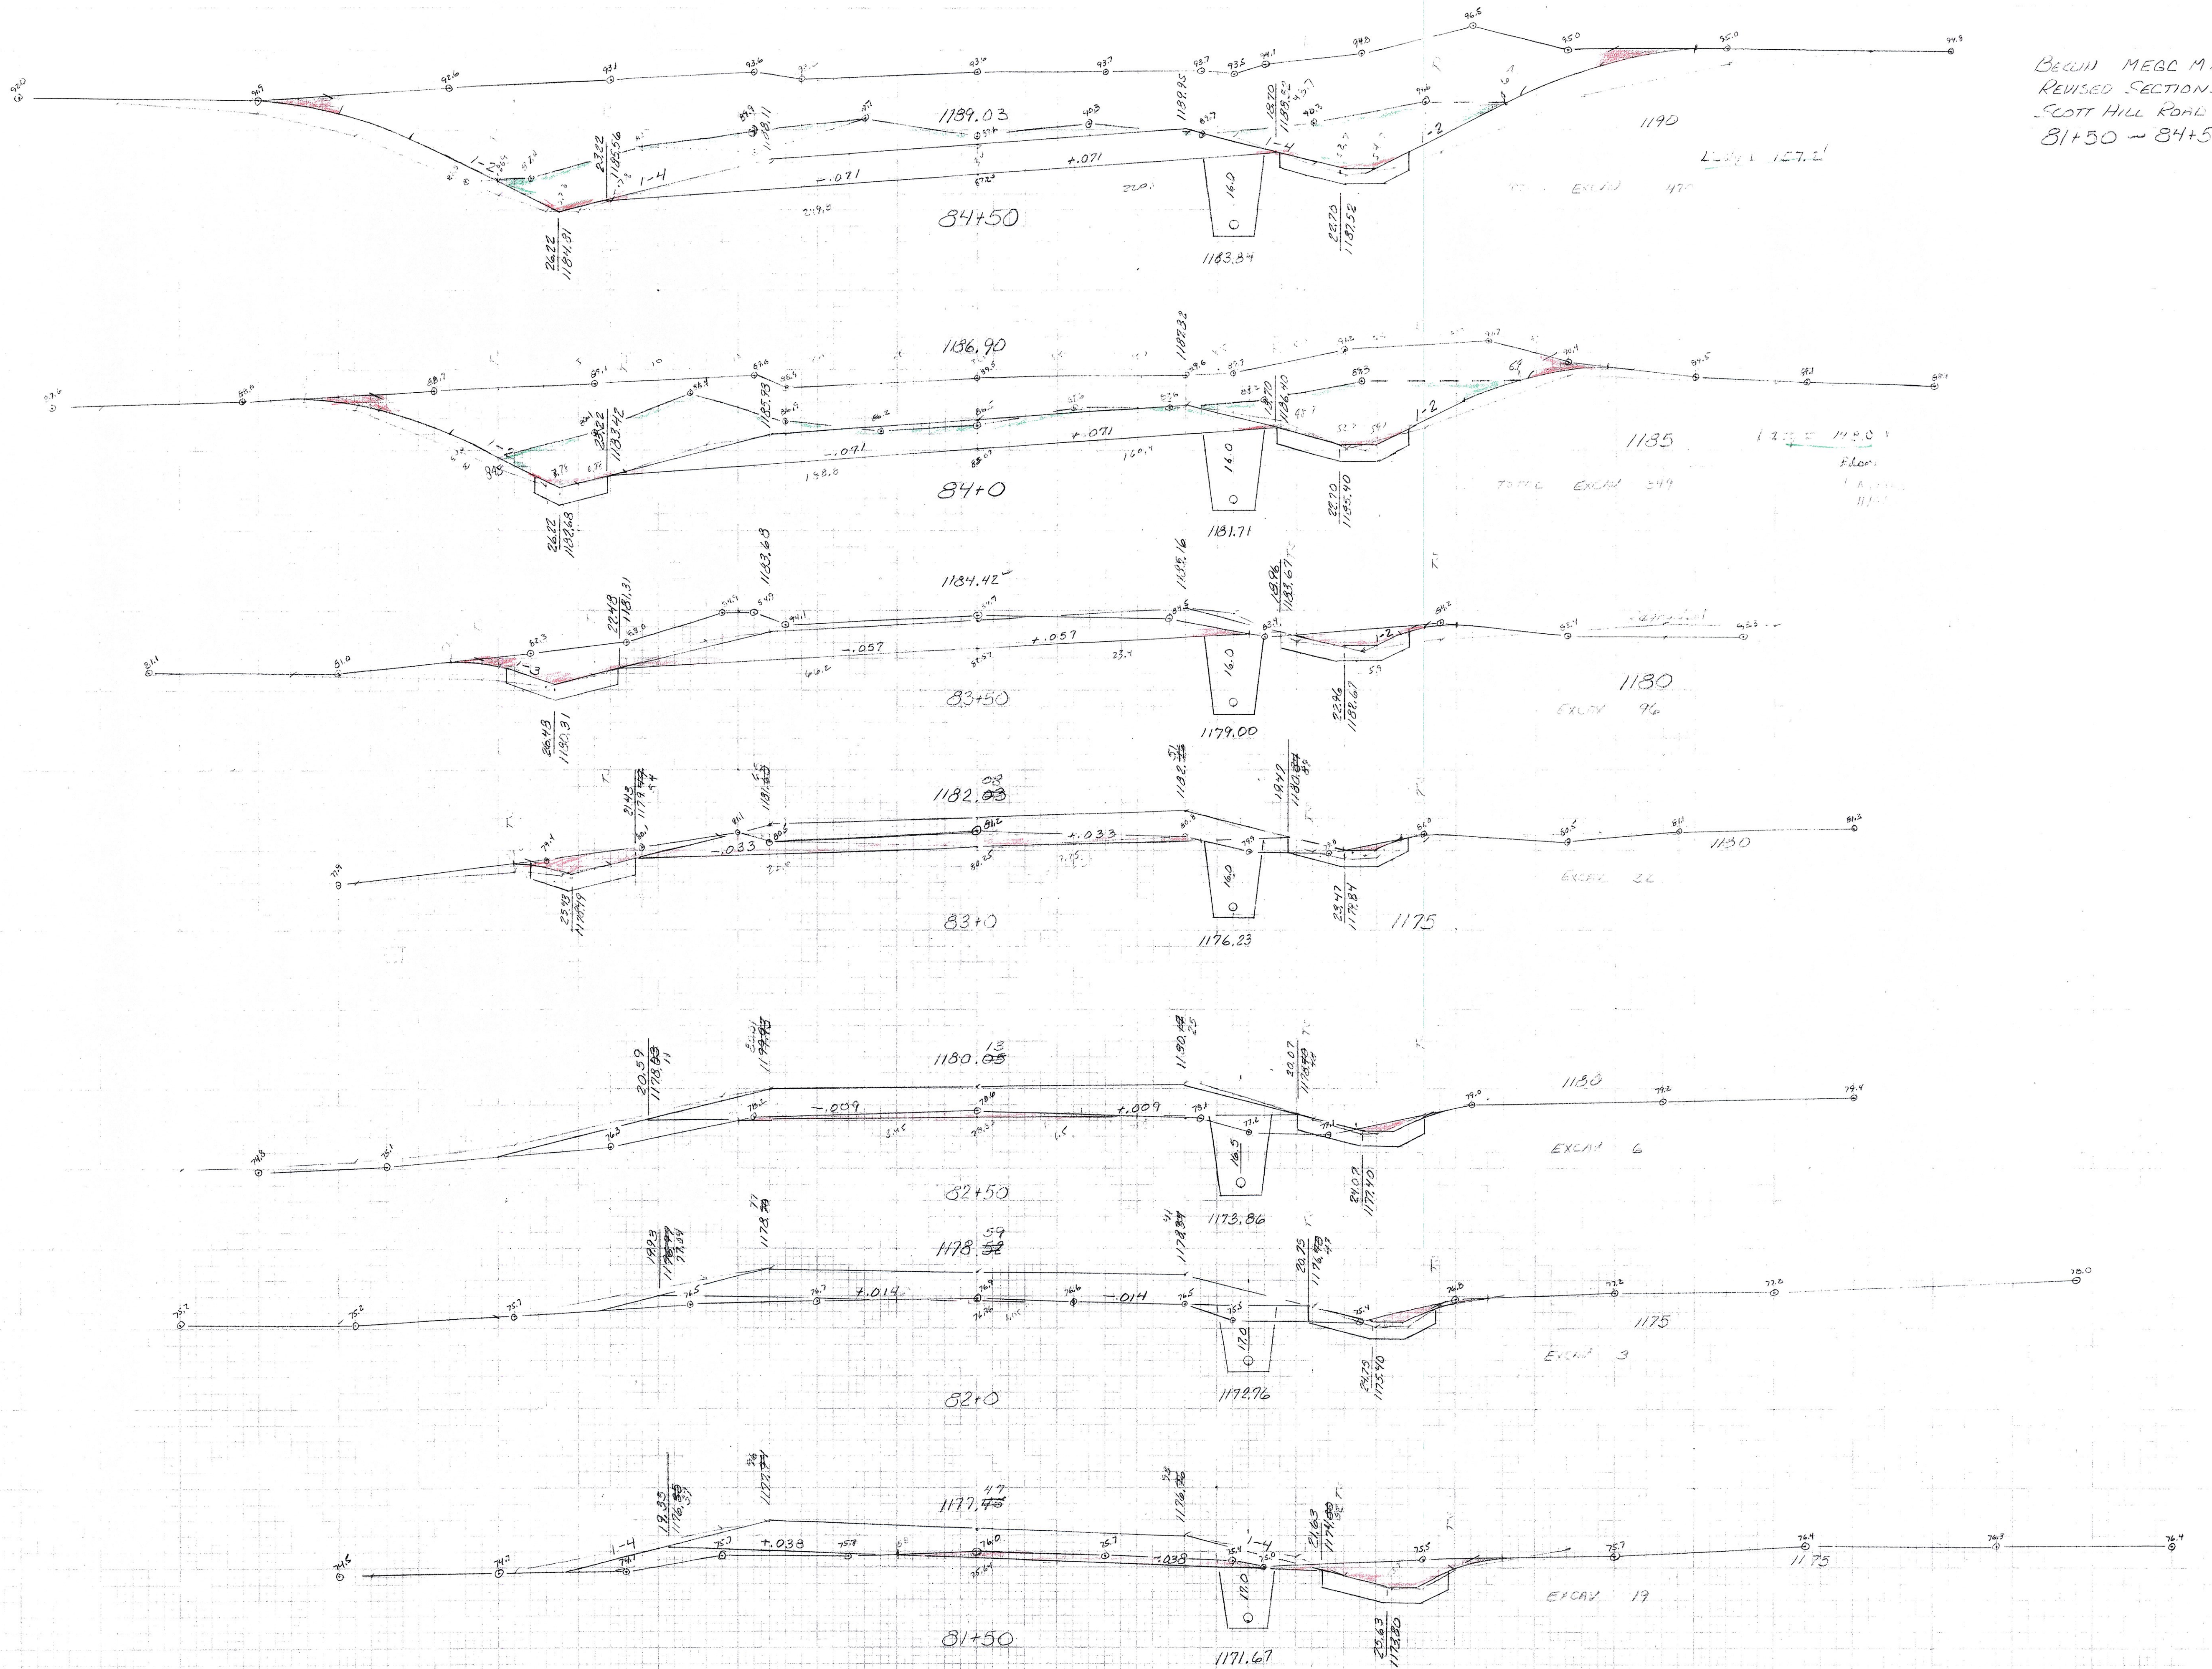

Copy - Cassette - March 1978
 4/25/78
 R. Con.