


BERLIN MEGC M 6200(2)S  
 REVISED SECTIONS  
 SCOTT HILL ROAD  
 87+50 - 90+0

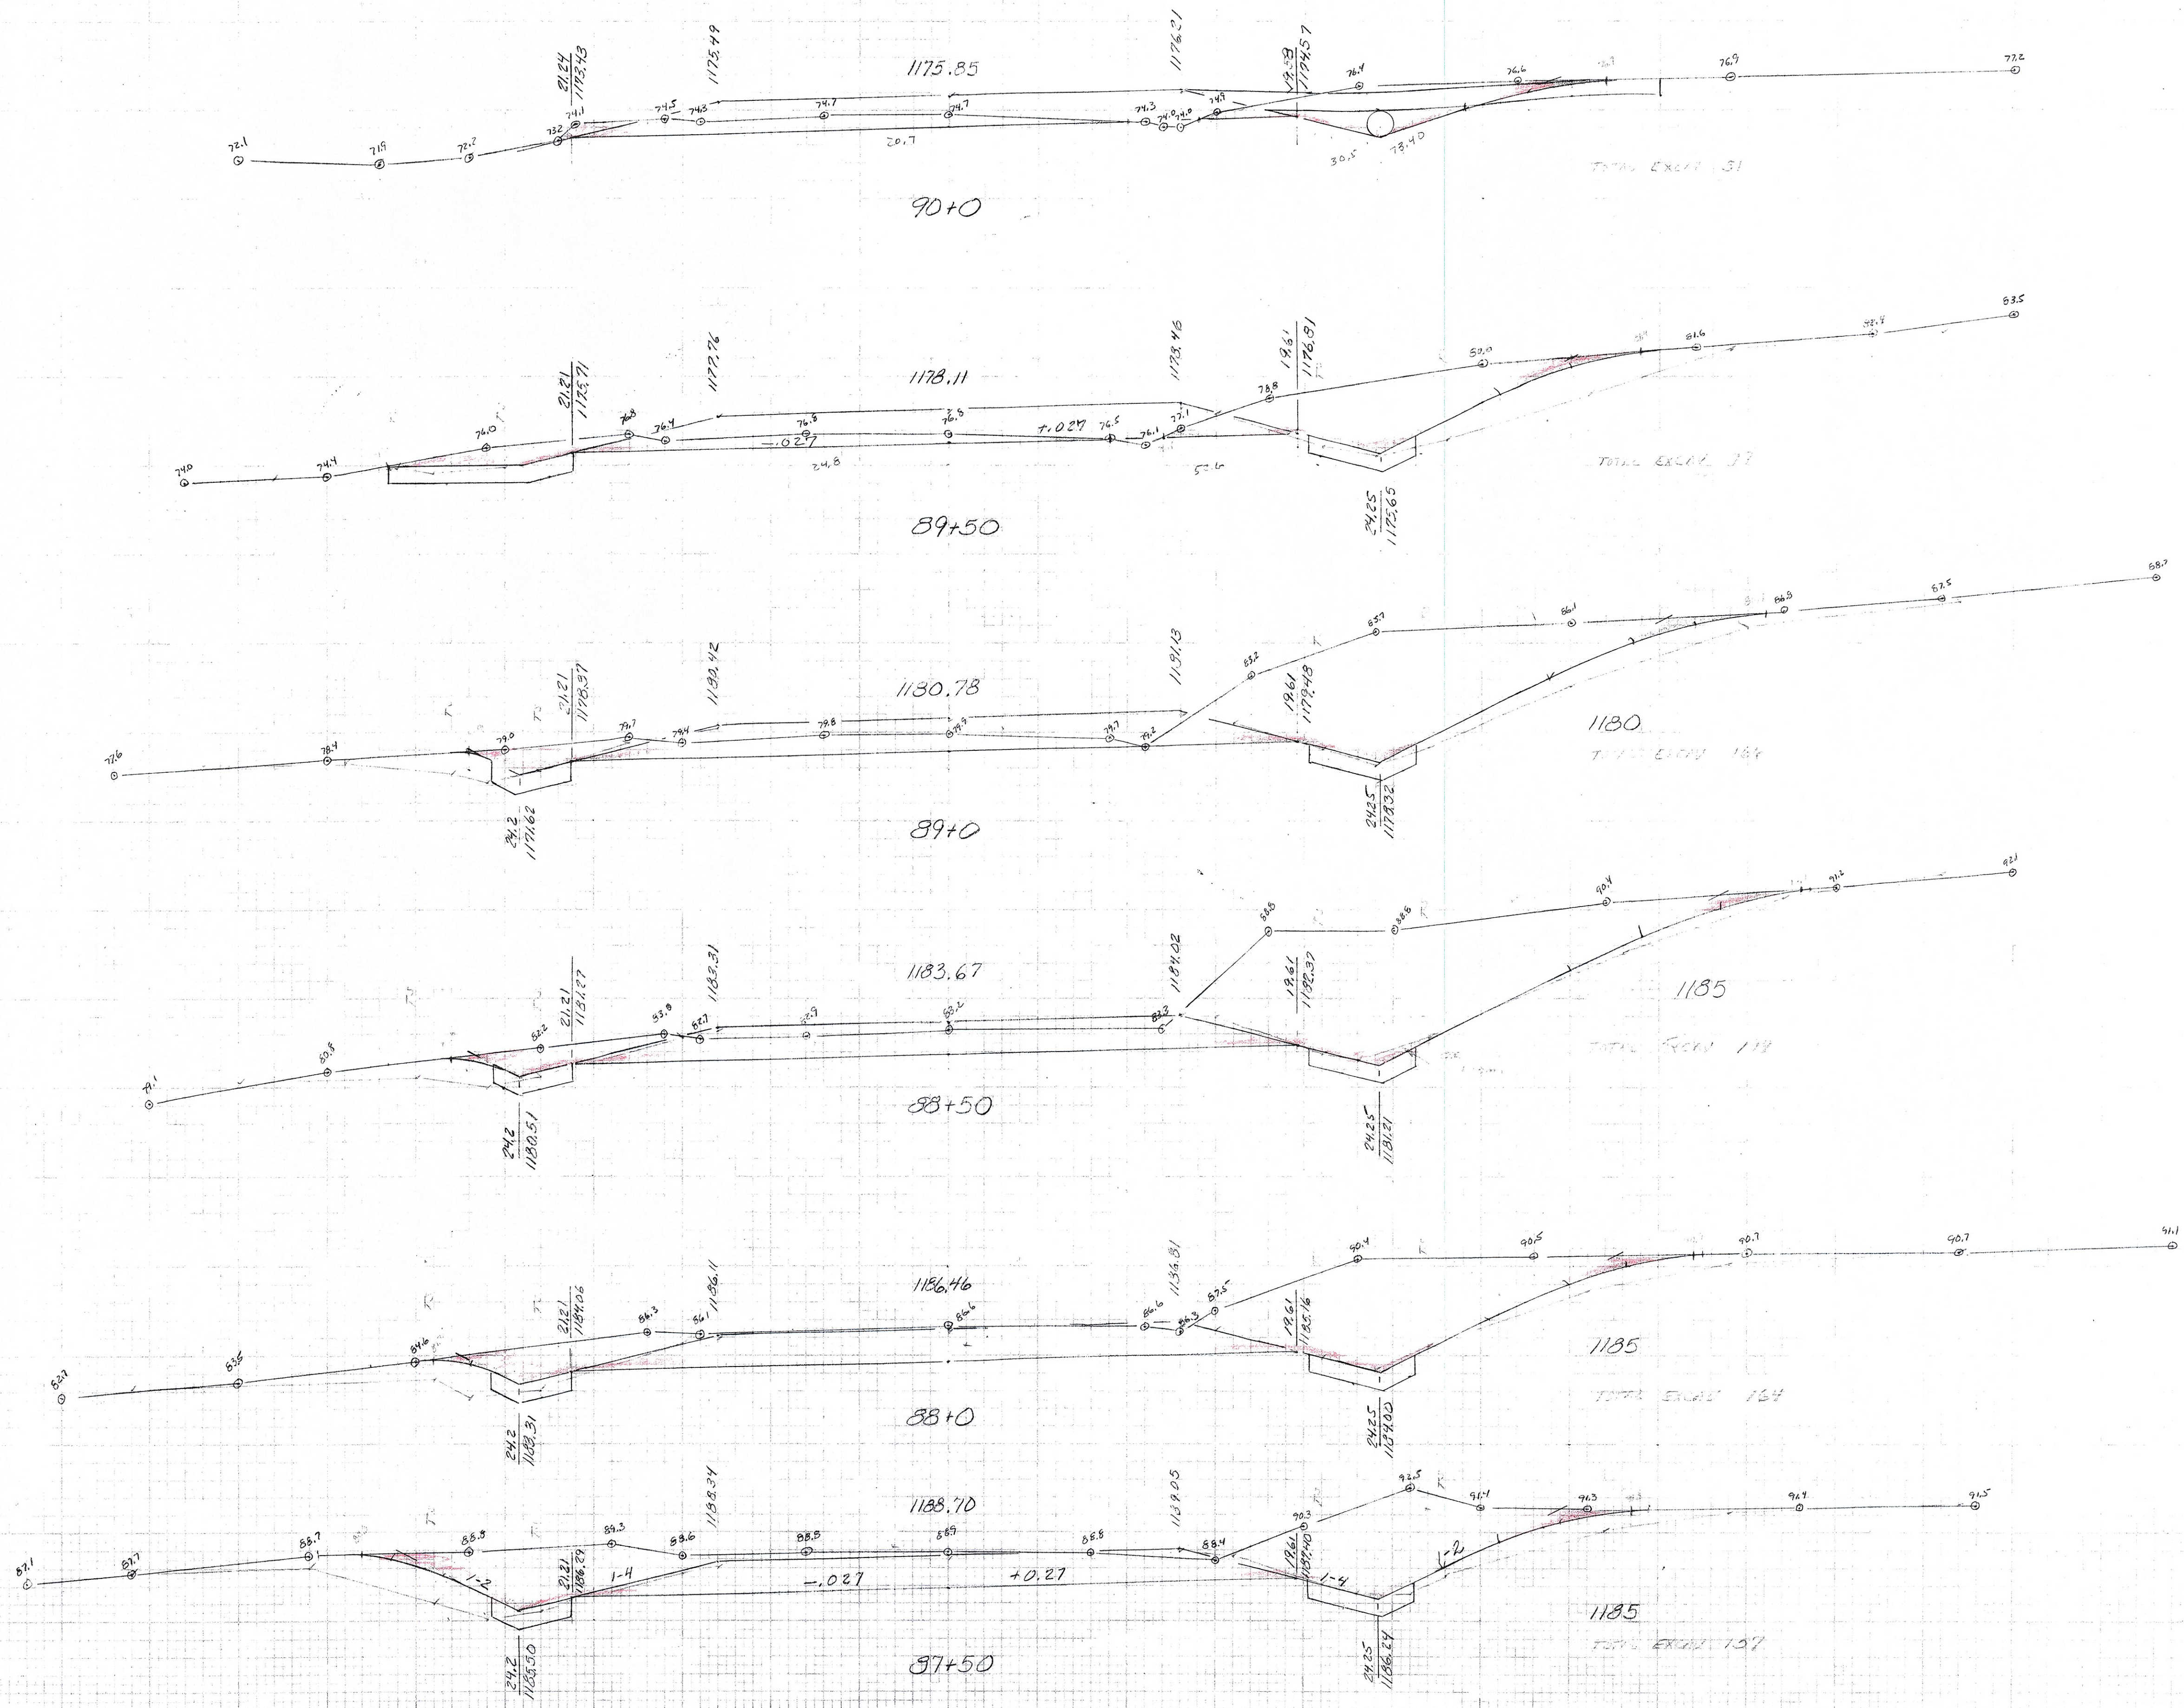

4/21/88  
 R. Gunn  
 11/14/88  
 R. Gunn  
 8/25/83