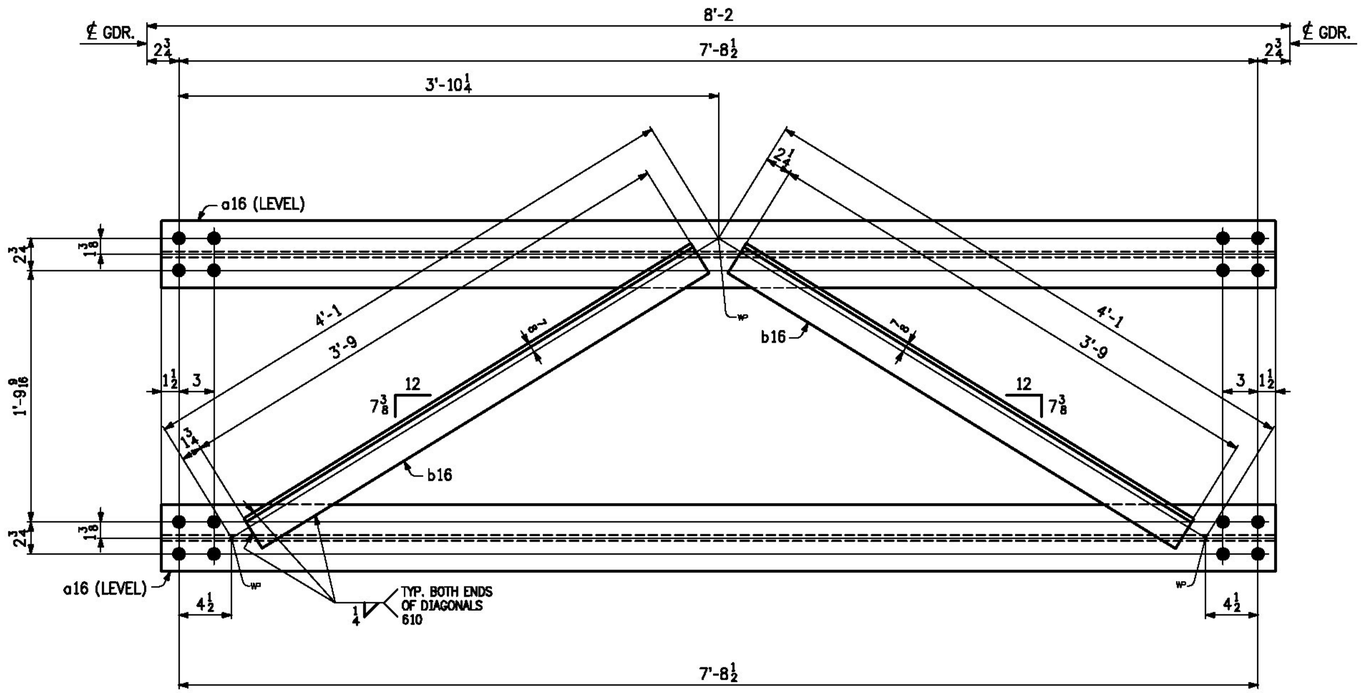

30 ~ CROSSFRAMES ~ 16CF1

LINE	NO. OF PCS.	SHIP MARK	ASS'Y MARK	MATERIAL SHAPE	MATERIAL SECTION	LENGTH FT.	LENGTH IN.	MATERIAL SPEC.	ITEM NO.	REMARKS
1	30	16CF1			CROSSFRAMES					6873 lbs
2	60		a16	WT	5 x 11	7	11½	M270-50W	4/2	5253 lbs
3	60		b16	L	3 x 3 x ⅜	3	9	M270-50W	4/3	1620 lbs
4										
5										
NOTES:

1. FOR GENERAL NOTES, SEE SHT. GN1.

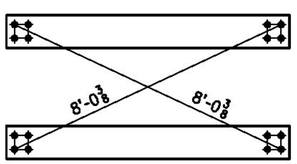

CROSS CORNER CHECK

T.Y. LIN INTERNATIONAL

THE STAMPED DOCUMENTS ARE HEREBY:

__X__ APPROVED
_____ APPROVED AS NOTED
_____ REVISE AND RESUBMIT

SEE TRANSMITTAL FOR ADDITIONAL INFORMATION AS APPLICABLE.

THIS REVIEW IS FOR GENERAL CONFORMANCE WITH DESIGN CONCEPT ONLY. ANY DEVIATION FROM THE PLANS OR SPECIFICATIONS NOT CLEARLY NOTED BY THE CONTRACTOR HAS NOT BEEN REVIEWED. REVIEW BY THE ENGINEER SHALL NOT RELIEVE THE CONTRACTOR OF THE CONTRACTUAL RESPONSIBILITY FOR ANY ERRORS OR DEVIATION FROM THE CONTRACT REQUIREMENTS.

RICK HEBERT — REVIEWER
2/2/2015 — DATE

NO.	DATE	REMARKS	BY

REVISIONS

CASCO BAY STEEL STRUCTURES
ONE WALLACE AVENUE
SOUTH PORTLAND, ME 04106
PHONE: 207-780-6722
FAX: 207-780-6726

STRUCTURE	BENMONT AVE. (TH-7) (URBAN MINOR ARTERIAL)
LOCATION	TOWN OF BENNINGTON, VERMONT
PROJECT NO.	BRIDGE NO. 57 PROJECT NO. BRF 1000(16)
ENGINEER	STATE OF VERMONT AGENCY OF TRANSPORTATION
CUSTOMER	ALPINE CONSTRUCTION
ITEM	CROSSFRAMES
SURFACE PREP.	SSPC-SP10 OPEN HOLES 15/16ø
PAINT	NONE

APPROVAL	DRAWN	GDC	12-4-14	SHEET NO. 16	JOB NO. 605
SHOP	CHECKED	PM	1-6-15		

1411-13

CF-INT-1411A

Sheet 16 - Plotted: 01/09/2015 @ 08:40 (WEATHER)