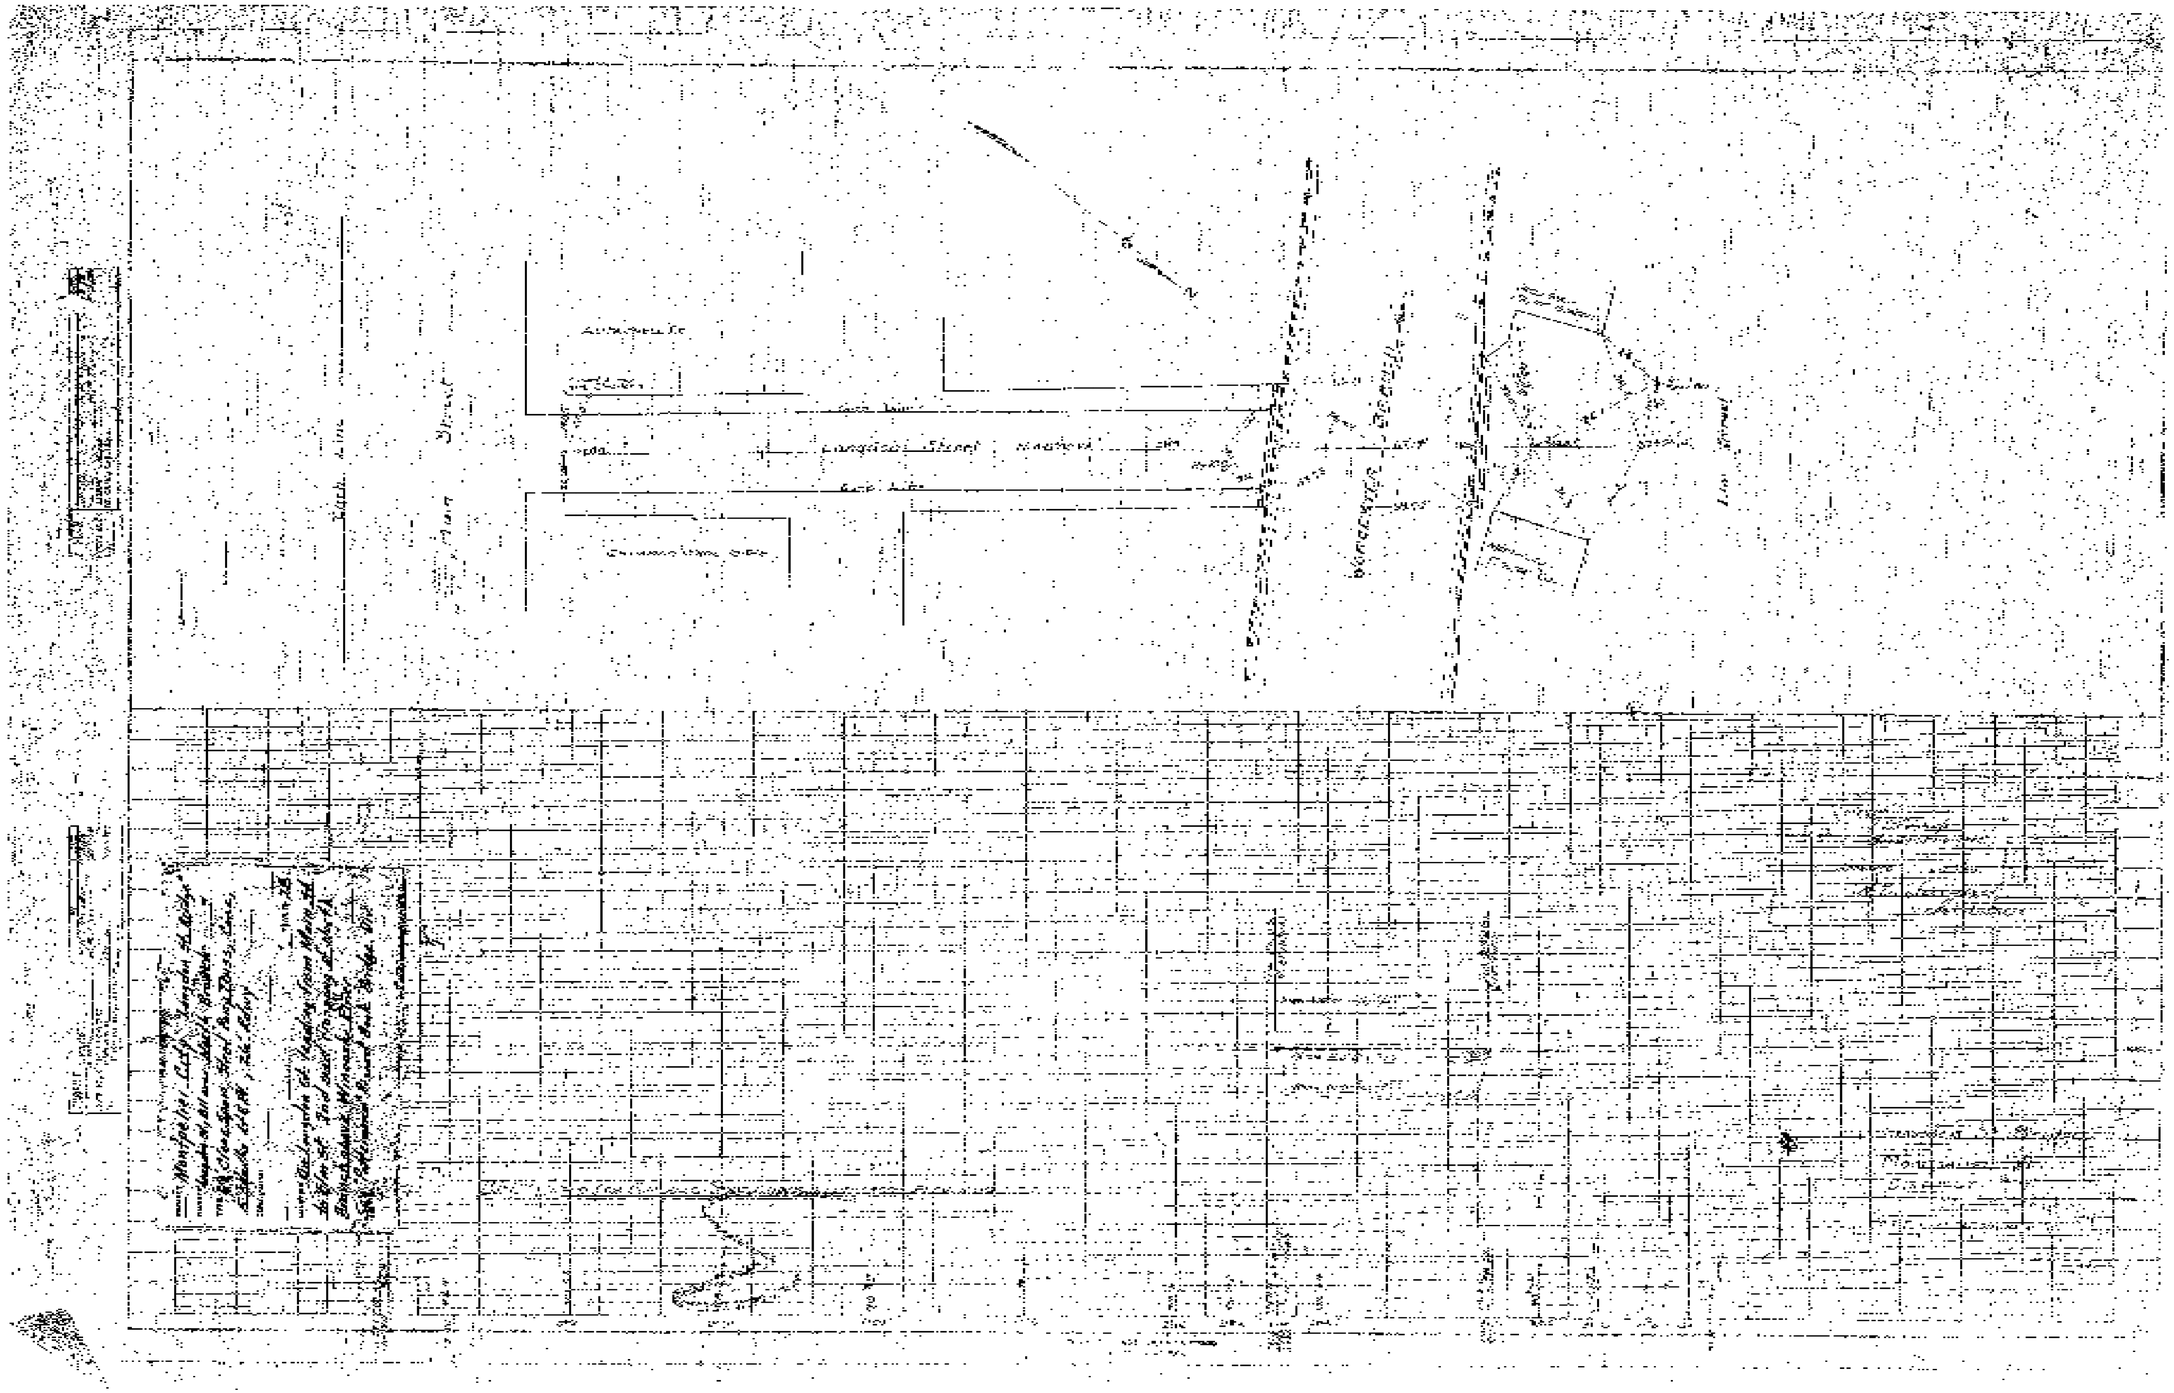

NTS

PROJECT: MONTPELIER	PROJECT NO.: BRM_6400_(25)
DESIGN FILE NAME: 88j100/structures/sj100cef.dgn	
IPARM FILE NAME: sj100cefl.i	PLOT DATE: 27-DEC-2011
DESIGNED BY: B.S. YOUNG	DRAWN BY: M. FESSEL
SQUAD LEADER: C.P. WILLIAMS	CHECKED BY: B.S. YOUNG
REFERENCE SHEETS	SHEET: 39 OF 49