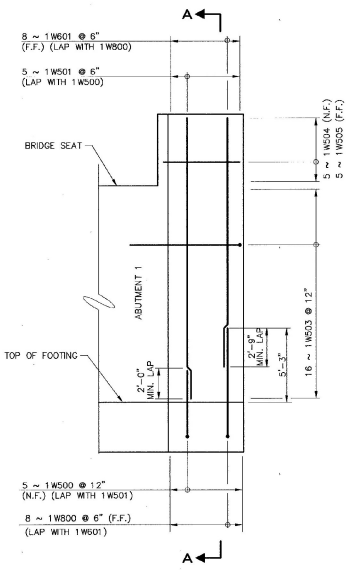

WEST ELEVATION
WINGWALL No. 1

SCALE: ¼" = 1'-0"

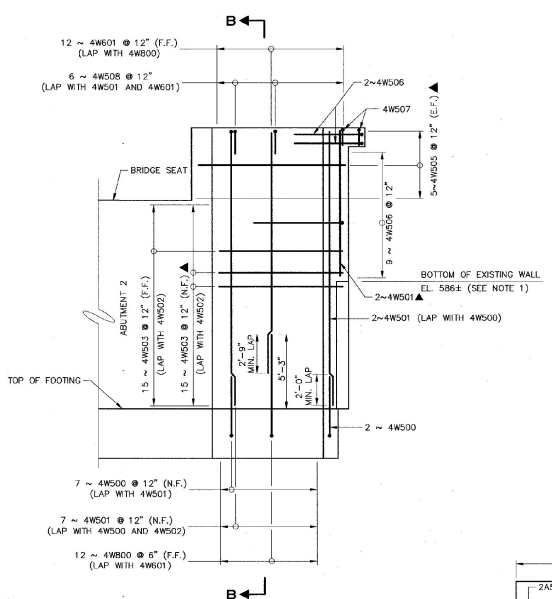

EAST ELEVATION
WINGWALL No. 4

SCALE: ¼" = 1'-0"

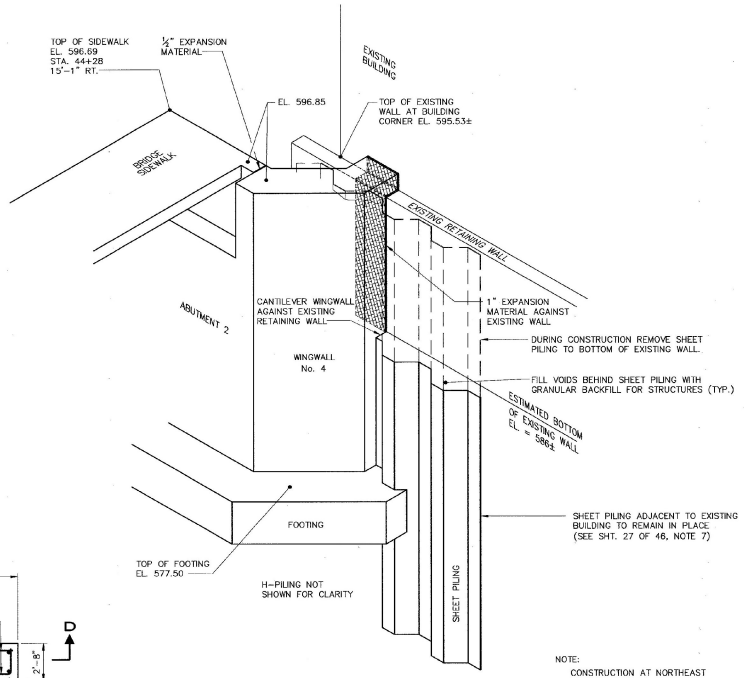

SOUTHEAST CORNER DETAIL

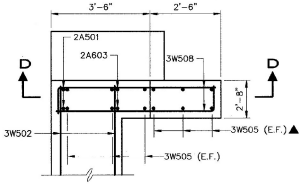

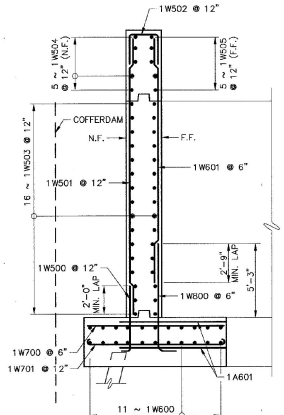

SECTION A-A

SCALE: ¼" = 1'-0"

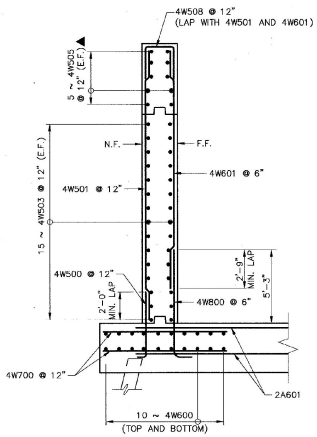

SECTION B-B

SCALE: ¼" = 1'-0"

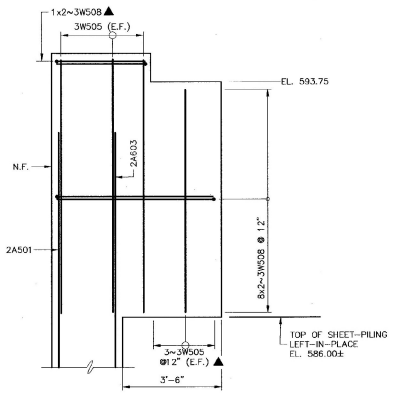

SECTION D-D
WINGWALL No. 3

SCALE: ½" = 1'-0"

NOTE

1. THE CONTRACTOR SHALL VERIFY ALL ELEVATIONS AND DIMENSIONS ADJACENT TO EXISTING STRUCTURES PRIOR TO THE INITIATION OF WORK.

LEGEND

N.F.	NEAR FACE
F.F.	FAR FACE
E.F.	EACH FACE
▲	CUT TO FIT IN FIELD

BETTIGOLE ANDREWS & CLARK, INC.
Consulting Engineers

STATE OF VERMONT
AGENCY OF TRANSPORTATION

CITY OF BARRE	BRIDGE NO. B-10
STREET NAME BLACKWELL STREET	LOG STA. / SURV. STA.
BLACKWELL STREET BRIDGE OVER STEVENS BRANCH	
WINGWALL REINFORCING and DETAILS	
DESIGNED BY V. DeAngelo	DRAWN BY S. Belanger
CHECKED BY J. Patusky DATE 12/98	BRIDGE DESIGN SUPERVISOR J. Patusky DATE 12/98
PROJECT BARRE CITY	PROJECT NO. BRM 6000(13)
BA&C DRAWING NO. BLACK08/48	DATE 12/98
BRIDGE SHEET NO. BR116	SHEET 29 OF 46

V:\2003\2003\DWGS\BLACK08.DWG Fri Feb 26 13:05:36 1999 Computer 120