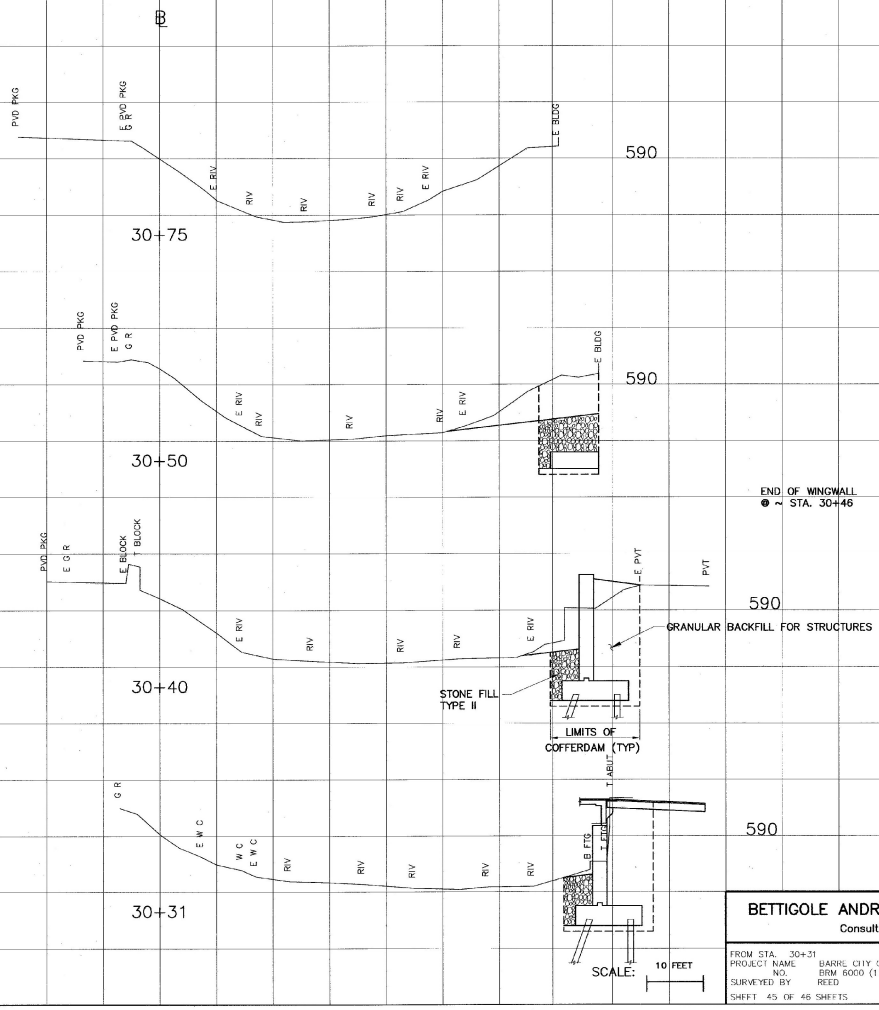

FINAL SURVEY		BY	DATE
NOTE BOOK	SURVEYED		
NO.	PLOTTED		
	TIDPLATE		
	AREAS CHECKED		

ORIGINAL SURVEY		BY	DATE
NOTE BOOK	SURVEYED		
NO. 32/179	PLOTTED		
	TIDPLATE		
	AREAS CHECKED		

BETTIGOLE ANDREWS & CLARK, INC.
Consulting Engineers

FROM STA. 30+31 TO STA. 30+75
PROJECT NAME BARRE CITY CHAN
NO. BRM 6000 (13) PLOTTED 12/98
SURVEYED BY REED 08/90 0325
SHEET 45 OF 46 SHEETS B A & C NO. 92038885 (1=10)

Y:\92038815\DWGS\92038885.DWG Fri Feb 26 15:03:06 1999 Computer # 20