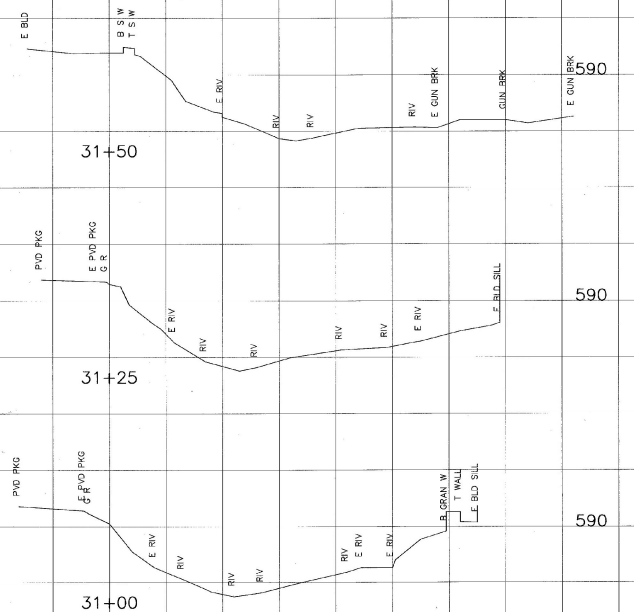

SCALE: 10 FEET

BETTIGOLE ANDREWS & CLARK, INC.
Consulting Engineers

FROM STA. 31+00		TO STA. 31+50	
PROJECT NAME	BARRE CITY CHAN		
NO.	BRM 6000 (13)		PLOTTED 12/98
SURVEYED BY	REED		08/90 0325
SHEET 46 OF 46 SHEETS			B A & C NO. 92038086 (1=10)

FINAL SURVEY		BY	DATE
NOTE BOOK	SURVEYED		
	PLOTTED	R.P.	6/98
	TEMPLATE	D.Dunn	6/98
	AREAS		
NO.	AREAS CHECKED		

ORIGINAL SURVEY		BY	DATE
NOTE BOOK	SURVEYED		
	PLOTTED	R.P.	6/98
	TEMPLATE	D.Dunn	6/98
	AREAS		
NO. 32/179	AREAS CHECKED		

V:\92038086\MCV\92038086.DWG Fri Feb 26 15:04:09 1999 Computer # 20