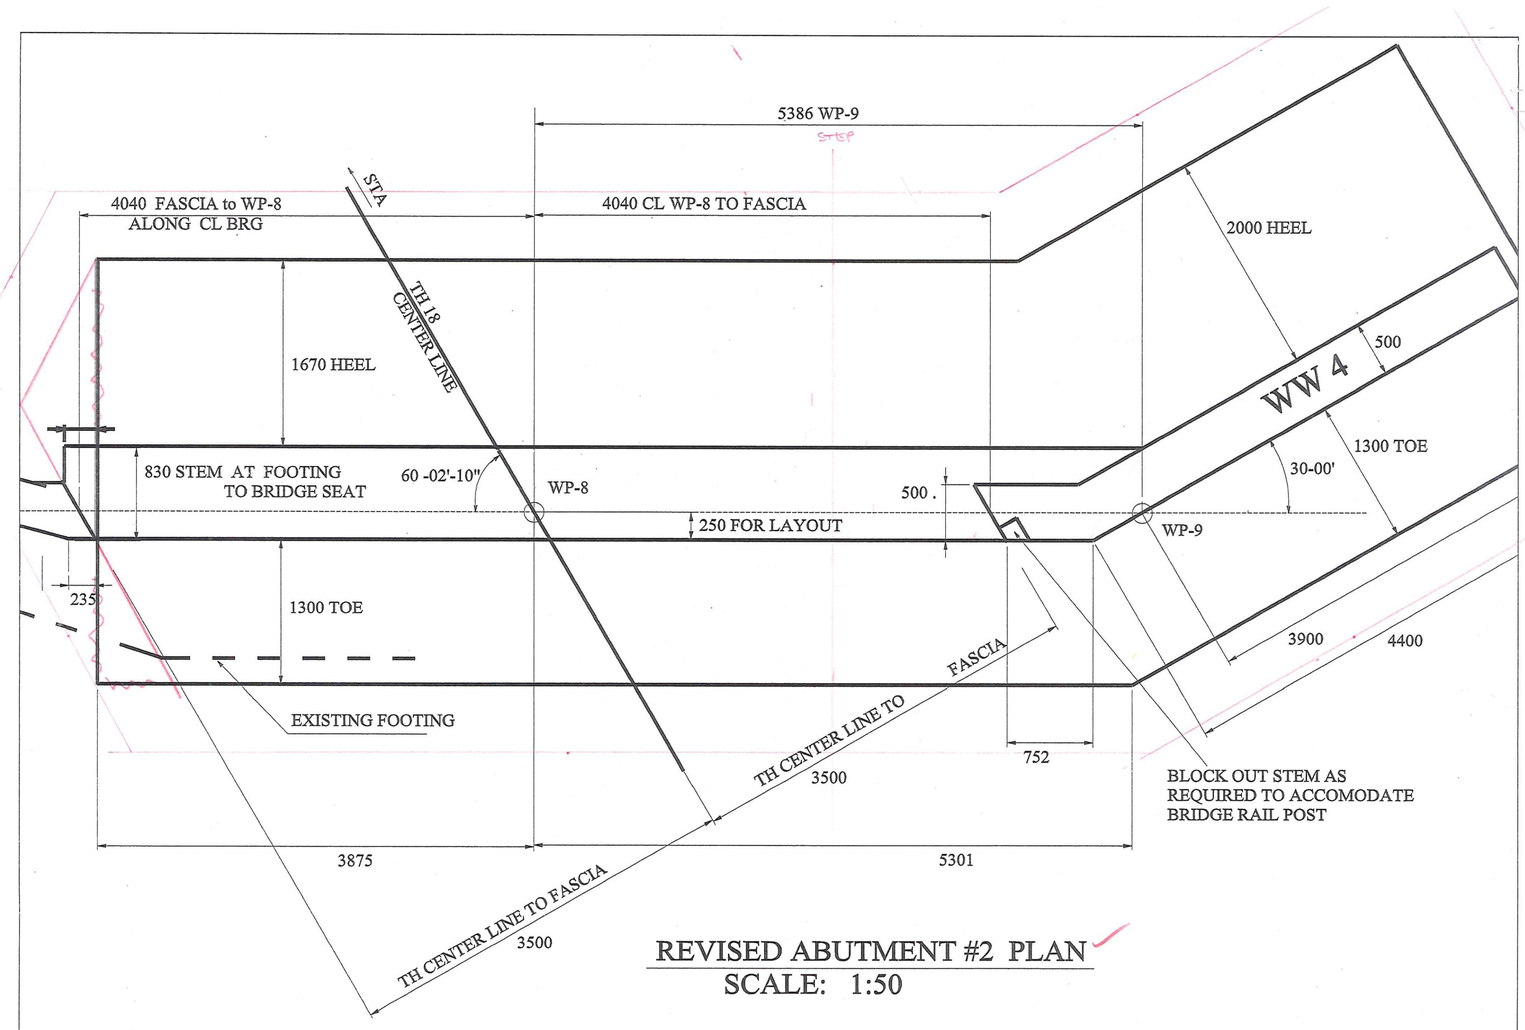

REVISED ABUTMENT #2 PLAN
SCALE: 1:50

NOTES: 1. THE WORKING POINTS (WP) LAYOUT HAVE NOT CHANGED. WW #4 IS IN THE SAME LOACTION.

2. THERE HAVE BEEN NO CHANGES TO WINGWALL #4.

3. RETAIN WINGWALL #3. DEWATER AND PUMP CONCRETE, CLASS "C" UNDER FOOTING.

3 of 7

RIPTON FH 010-1(42)
VTRANS - SEPT. 9, 2010
BY S.FARNSWORTH