RECORD PLANS
R.E. JOSH HULETT

RIPTON FH 010-1(42)

LEDGE PROFILE ALONG ℄ BRG @ ABUT #2 10-10-10

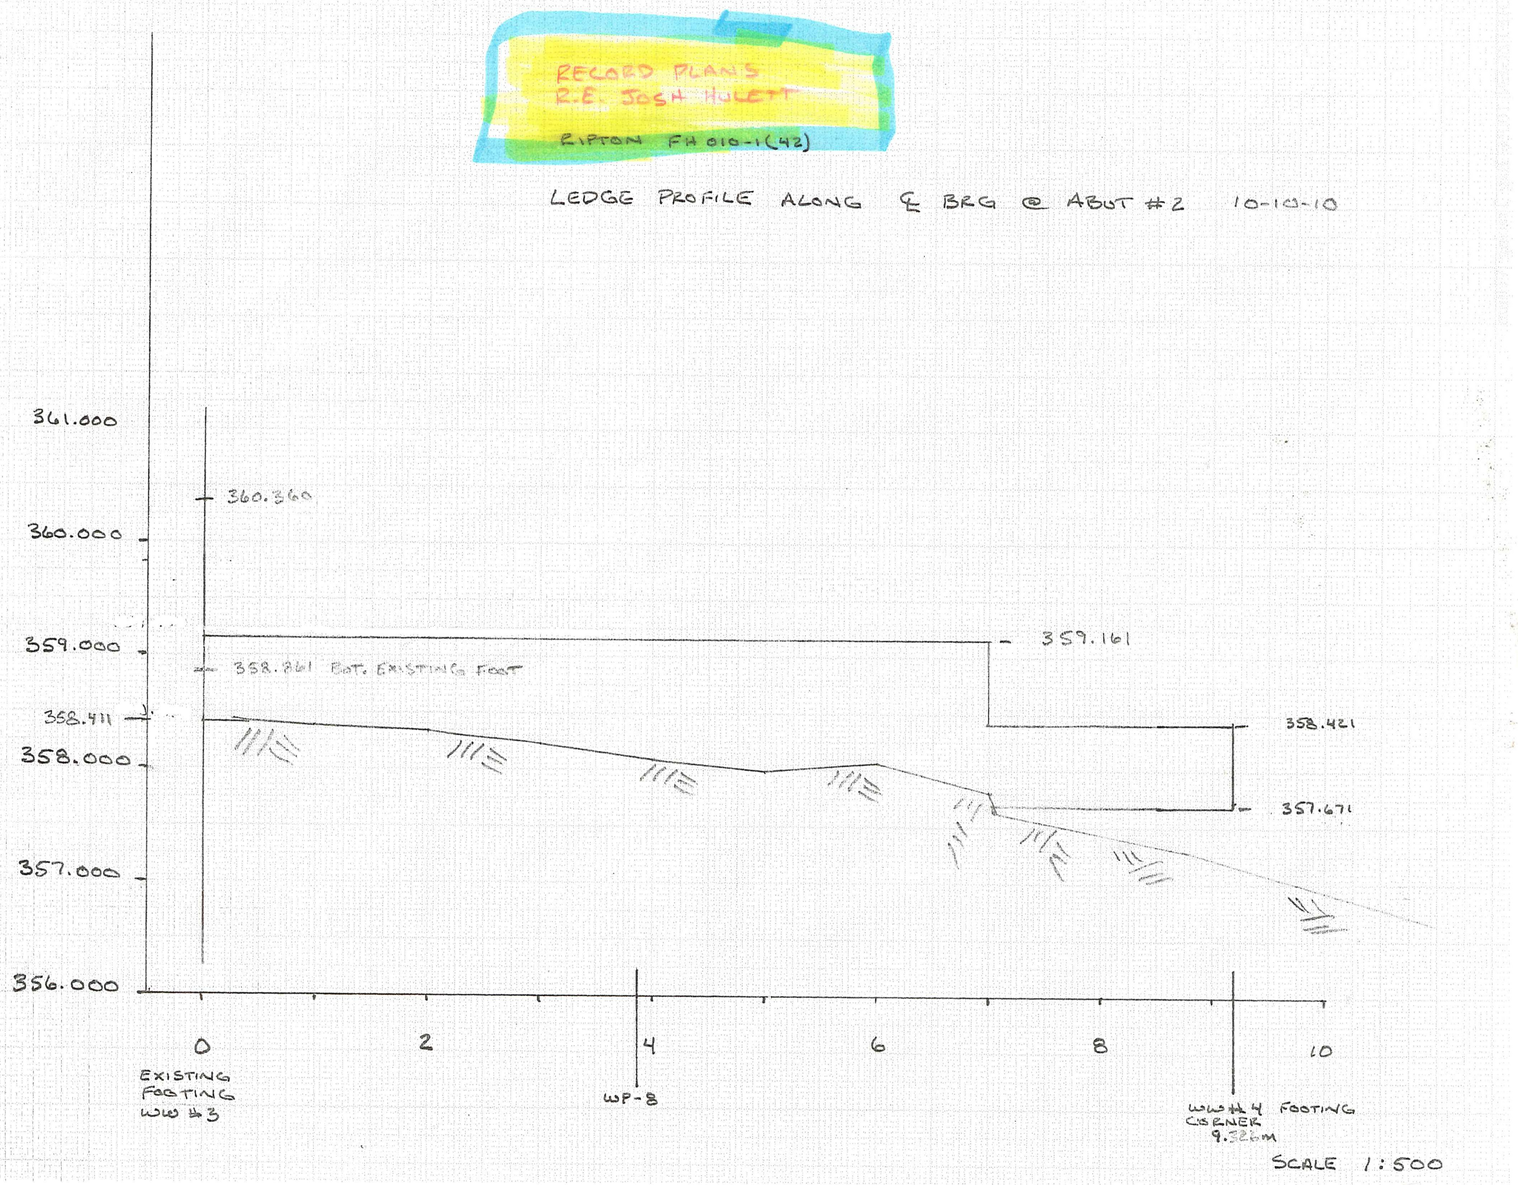

SCALE 1:500