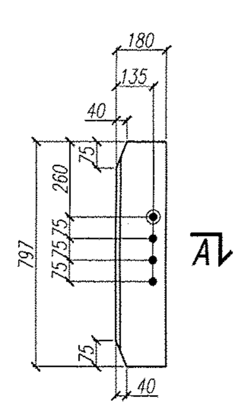

6 – PL12.7x180x797 – 1p1

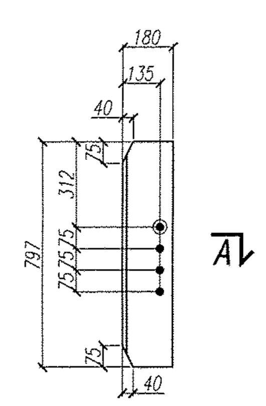

6 – PL12.7x180x797 – 1p2

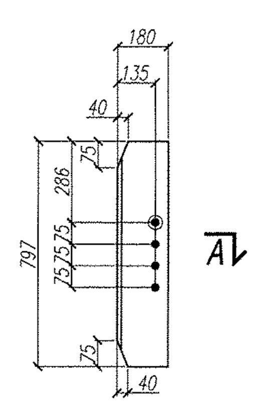

6 – PL12.7x180x797 – 1p3

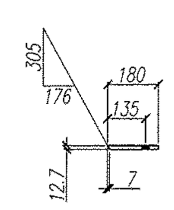

SECTION A

NOTES:

1.) FOR GENERAL NOTES SEE DWG GN1

2.) LENGTH OF PLs **1p1–1p3** AND HOLE DIMENSIONS ARE THEORETICAL AND MAY NEED TO BE ADJUSTED TO SUIT ACTUAL BEAM DEPTH

3.) HARDWARE DEPT: CHECK ALL PARTS BEFORE RELEASING

4.) ◉ DENOTES REFERENCE HOLE

5.) LOCATE ON DWGS S1A/B – S2A/B

☐ Reviewed
☐ Rejected

☒ Furnish as Corrected
☐ Revise and Resubmit
☐ Submit Specified Item

This review is only for general conformance with the design concept and the information given in the Construction Documents. Corrections or comments made on the shop drawings during this review do not relieve the contractor from compliance with the requirements of the plans and specifications. Review of a specific item shall not include review of an assembly of which the item is a component. The Contractor is responsible for: dimensions to be confirmed and correlated at the jobsite; information that pertains solely to the fabrication process or to the means, methods, techniques, sequences and procedures of construction; coordination of the Work with that of all other trades and performing all Work in a safe and satisfactory manner.

McFarland-Johnson, Inc. ____________

Date 7/9/2010

By RMK

NO.	DATE	BY	REVISION

STS STEEL, INC.
ENGINEERS • FABRICATORS • ERECTORS
PH: (518) 370-2693 FAX: (518) 370-2696

DRAWING TITLE
HARDWARE

ARCHITECT : VERMONT AGENCY OF TRANSPORTATION
CUSTOMER : THE FORT MILLER CO., INC.
PROJECT : RIPTON FH 010-1(2) TH 18 OVER SOUTH BRANCH MIDDLEBURY RIVER
TOWN OF RIPTON, STATE OF VERMONT

HOLES:	15/16"ϕ UN	FINISH:	SEE GN1	DATE:	5-11-10
BOLTS:	-----	DR.BY:	WMN	JOB NO.	1060
WELDS:	-----	CHK.BY:	DT 6-18-10	DWG NO.	1