ABM INFO		SHOP BILL							JOB NO. 329	DRG. NO. D1
PAGE	LINE	NO.	DESCRIPTION	FT	IN	ASSEM. MARK	SHIPPING MARK	REMARKS		WEIGHT
		1	TS6x5x¼	9	6		DS1	ASTM A500-B		
		2	BAR 4x¼	1	10±		BK	BEND.		
		4	1" Ø EXP. BOLTS		8		FIELD			
			PAY ITEM 506.60							

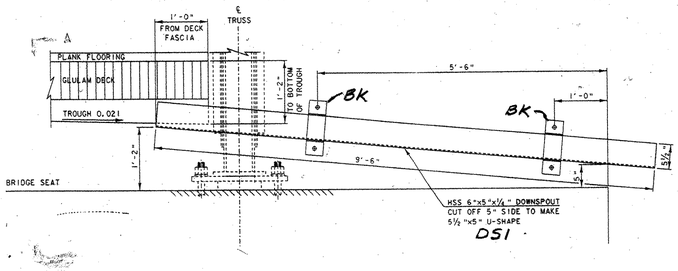

DOWNSPOUT ELEVATION

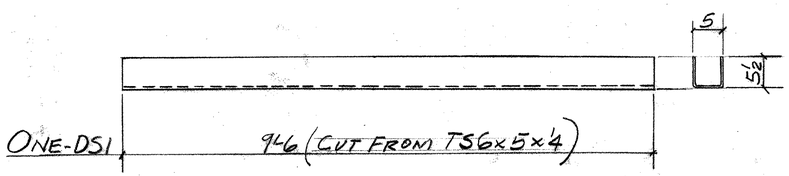

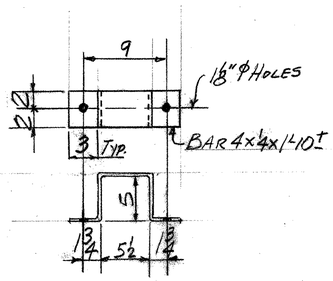

BK-2-REQ'D.

STRUCTURES COPY

RECEIVED
JUN 21 2007
CONTRACTORS CASTLE SUPPLY, INC.
MORRISVILLE, VT

CCS Constructors LLC
138 Munson Avenue
Morrisville, VT 05661
Ph: 802-888-7701 f: 802-888-4746

REV.	REMARKS	DATE	DWN	CHK	APP	Q.A.	NO.	DIA.	LGT	TYPE	WASHER
	OUT FOR APPROVAL	6-20-07									
	OUT FOR APPROVAL										
	ISSUED TO SHOP										
	FIELD & OFFICE										

PROJECT NO. BHO-BTM-2005(1) STATE PROJECT NO.

MATERIAL: AASHTO M270-Gr50 | ELECTRODES: — | HOLES: — | SHOP BOLTS: —

SURFACE PREP. & PAINT:
GALV. AFTER FAB (ASTM-A123)

DESCRIPTION: DOWNSPOUT

JOB: BRIDGE IMPROVEMENTS NEW HAVEN & WEYBRIDGE VT.

CUSTOMER: CCS

	DRAWN BY	DATE
	JPF	6-07
	CHKD BY	
	EJ.	
	APPROV BY	
	Q.A.	
	JOB NO.	DRG. NO.
	329	D1
		REV. △

CASCO BAY STEEL STRUCTURES, INC.
75 SPRING HILL ROAD SACO, MAINE 04072
PHONE (207) 282-7360 FAX. (207) 282-1179

RECEIVED
CK'D BY HJS CK'D BY RSY
JUN 26 2007
RESUBMIT ____ APPROVED ✓
BY JPW DATE 7/12/07

1" = 1'-0"

064-DS