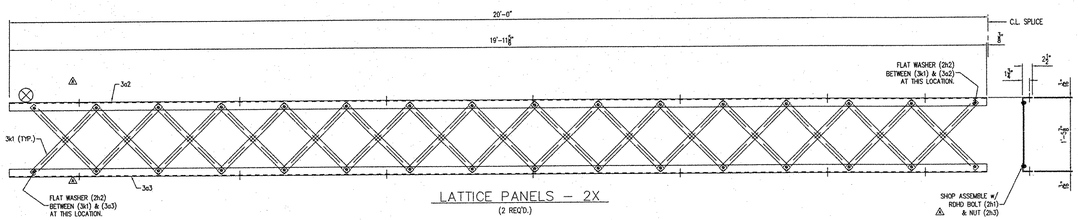

LATTICE PANELS – 2X

(2 REQ'D.)

MK	QTY.	DESCRIPTION	MATERIAL	LENGTH	REMARKS	PART NO.
2X	2	LATTICE PANELS			19'-11 5/8"	
2k1	70	3/8W X 1 3/8 SLOTTED ROUND HEAD BOLT	A307 GR A		(64); A153-HDG; NONE	
2k2	10	3/8W FLAT WASHER	F844		(4); A153-HDG	
2k3	70	3/8W HEX NUT	A563 GR A		(64); A153-HDG	
3o2	2	2 1/2 X 2 X 3/16	A709 GR 50 OR GR A992	19'-11 5/8	A123-HDG; NONE	
3o3	2	2 1/2 X 2 X 3/16	A709 GR 50 OR GR A992	19'-11 5/8	A123-HDG; NONE	
3k1	60	3/16 X 2	A572 GR 50	1'-11 5/16	[illegible]	

NOTE: ALL MATERIAL SPECIFICATION DESCRIPTIONS ARE ASTM, UNLESS OTHERWISE NOTED.

RECEIVED

OK'D BY EVR OK'D BY RSY

AUG 07 2007

RESUBMIT _____ APPROVED ✓

BY OPW DATE 8/17/07

– SEE SHEET 3 FOR PIECE DETAILS.

– SEE DS BROWN PROJECT 20388-1206 SHEET E1 & E2 FOR FIELD LOCATION AND DETAILS

REV.	DESCRIPTION	DATE	DET.	CHKD.
1	PER APPROVAL	7/26/07	JEB	TSF

	ITEM	QUANTITY
LOCATION — TOWNS OF NEW HAVEN & WEYBRIDGE	–	–
BRIDGE — 26	–	–
PROJECT — ROUTE NO. TH7/11, CL3	–	–
F.A.P. NO. — BHG-BTN 2005(1)	–	–
P.O. NO. — –	–	–
DESIGNER — VERMONT DEPARTMENT OF TRANSPORTATION	–	–
CUSTOMER — CONTRACTORS CRANE SERVICE, LLC	–	–

D.S. BROWN
THE D.S. BROWN COMPANY
300 E. CHERRY STREET
NORTH JAMES, OHIO 45872
419.257.3300
FAX: 419.257.3333
WWW.DSBROWN.COM

DESCRIPTION: LATTICE DETAILS
ADDISON COUNTY, VT

SCALE	DRAWN BY	CHECKED BY	DATE
N.T.S.	JEB	TSF	6/15/07

PROJECT NUMBER	PRODUCT NO.	REVISION	SHEET
20388	1209	1	02

SHOP NOTE:
⊗ – INDICATES LOCATION OF SHIPPING PIECE MARK

092-P2