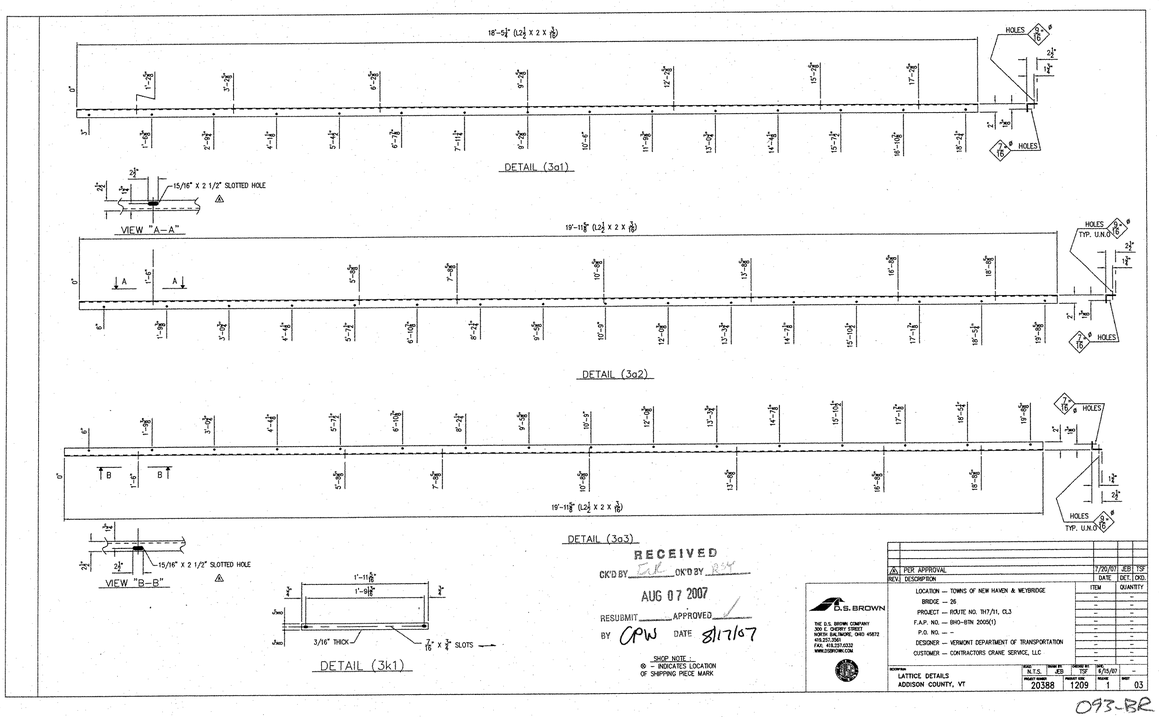

RECEIVED
OK'D BY EAK OK'D BY RSY
AUG 07 2007
RESUBMIT ____ APPROVED ✓
BY CPW DATE 8/7/07

SHOP NOTE:
⊗ – INDICATES LOCATION OF SHIPPING PIECE MARK

REV.	DESCRIPTION	DATE	DET.	CKD.
1	PER APPROVAL	7/26/07	JEB	TSF

D.S. BROWN

THE D.S. BROWN COMPANY
300 E. CHERRY STREET
WWW.DSBROWN.COM

LOCATION — TOWNS OF NEW HAVEN & WEYBRIDGE
BRIDGE — 26
PROJECT — ROUTE NO. TH7/11, CL3
F.A.P. NO. — BHO-BTN 2005(1)
P.O. NO. — –
DESIGNER — VERMONT DEPARTMENT OF TRANSPORTATION
CUSTOMER — CONTRACTORS CRANE SERVICE, LLC

ITEM	QUANTITY
–	–
–	–
–	–
–	–
–	–
–	–
–	–

DESCRIPTION: LATTICE DETAILS
ADDISON COUNTY, VT

SCALE	DRAWN BY	CHECKED BY	DATE
N.T.S.	JEB	TSF	6/15/07

PROJECT NUMBER	PROJECT NO.	REVISION	SHEET
20388	1209	1	03

093-BR