PORTLAND CEMENT CONCRETE SIDEWALK, 125 mm
STATION 1+150.00 - 1+214.000 RIGHT

SEE NOTE ON SHEET 13
~~CAST IN PLACE CONCRETE CURB, TYPE B~~
~~STATION 1+150.000 - 1+200.000 LEFT~~
~~STATION 1+150.000 - 1+ 210.000 RIGHT~~

Metric

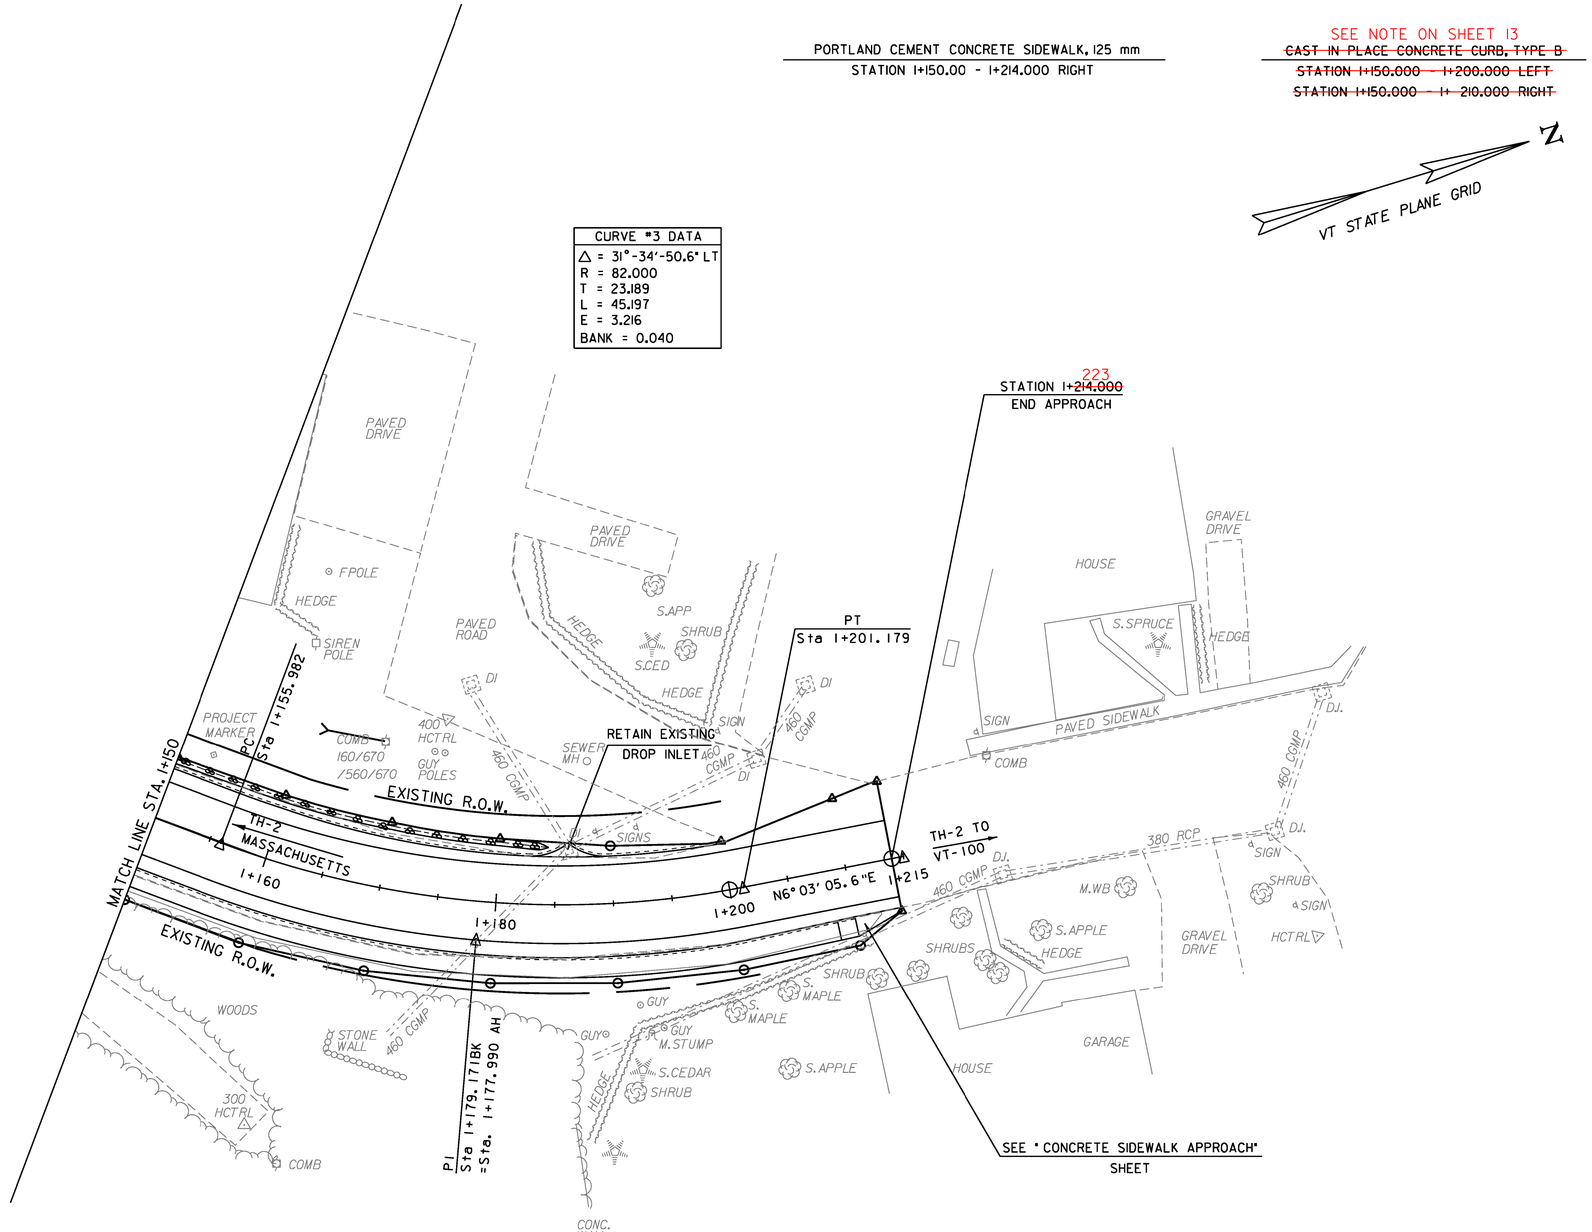

0 10 20
SCALE 1:250

PROJECT NAME: READSBORO	
PROJECT NUMBER: BRF 0105 (3)	
FILE NAME: 89J088/STR/s89J088bdr.dgn	PLOT DATE: 07-MAR-2012
PROJECT LEADER: J. LACROIX	DRAWN BY: G. ROKES
DESIGNED BY: W. PELLETIER	CHECKED BY: W. PELLETIER
LAYOUT SHEET 2	SHEET 14 OF 90