Metric

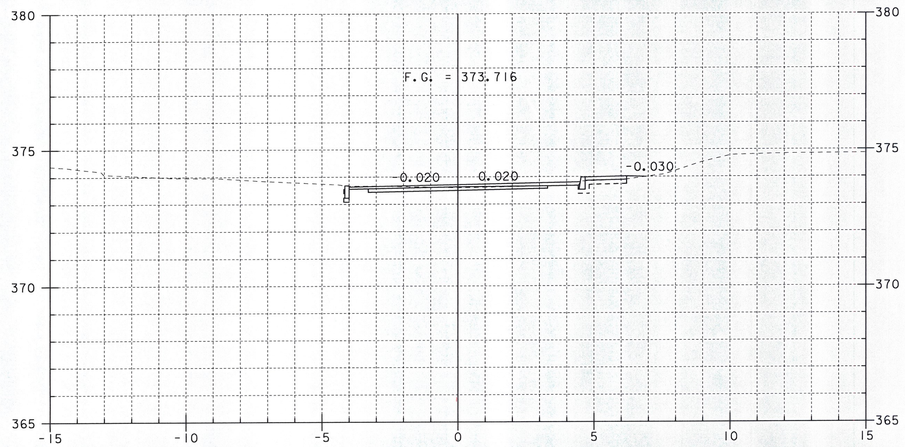


1+200

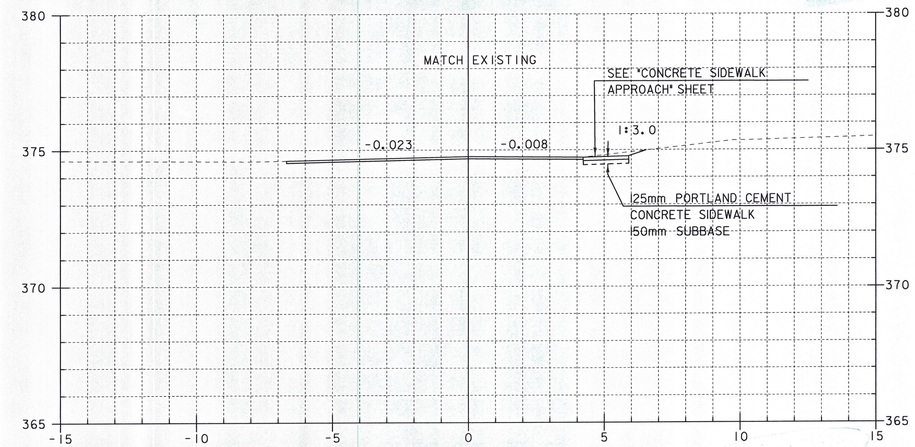


1+214
END APPROACH

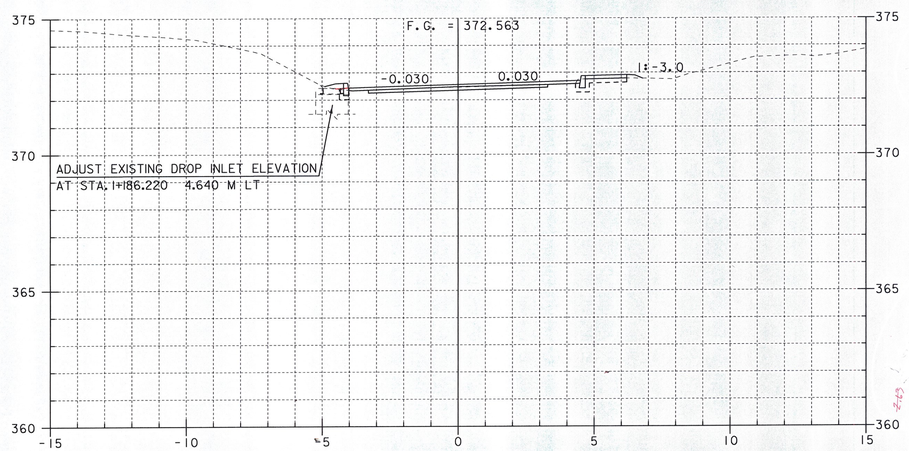


1+190

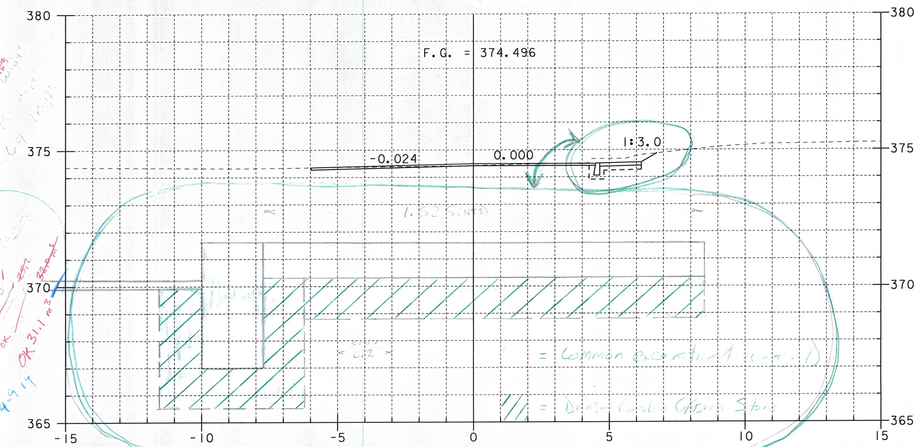


1+210

STA. 1+090.000 TO STA. 1+214.000

| | |
|---|---|
| PROJECT NAME: READSBORO | |
| PROJECT NUMBER: BRF 0105 (3) | |
| FILE NAME: 89J088/STR/sj088xs.dgn | PLOT DATE: 07-MAR-2012 |
| PROJECT LEADER: J. LACROIX | DRAWN BY: G. ROKES |
| DESIGNED BY: W. PELLETIER | CHECKED BY: W. PELLETIER |
| MAINLINE CROSS SECTIONS SHEET 7 | SHEET 86 OF 90 |