Readsboro BRF 0125 (3)
New Sewer Line
Drainage Sheet #1

Total Trench Depth from this Sheet
8.85 + 7.85 + 12.95 + 27.85 + 5.64 + 11.69 = 64.31cm for 1-28-14
for 1-28-14
RM 3-31-14

Total Structure Excavation from this Sheet
7.85 + 5.64 = 13.49cm for 1-28-14
RM 3-31-14

Total Granular Backfill for Sewer
64.31 + 13.49 + 1.50 + 2.50 = 71.00cm
for 1-28-14
RM 3-31-14

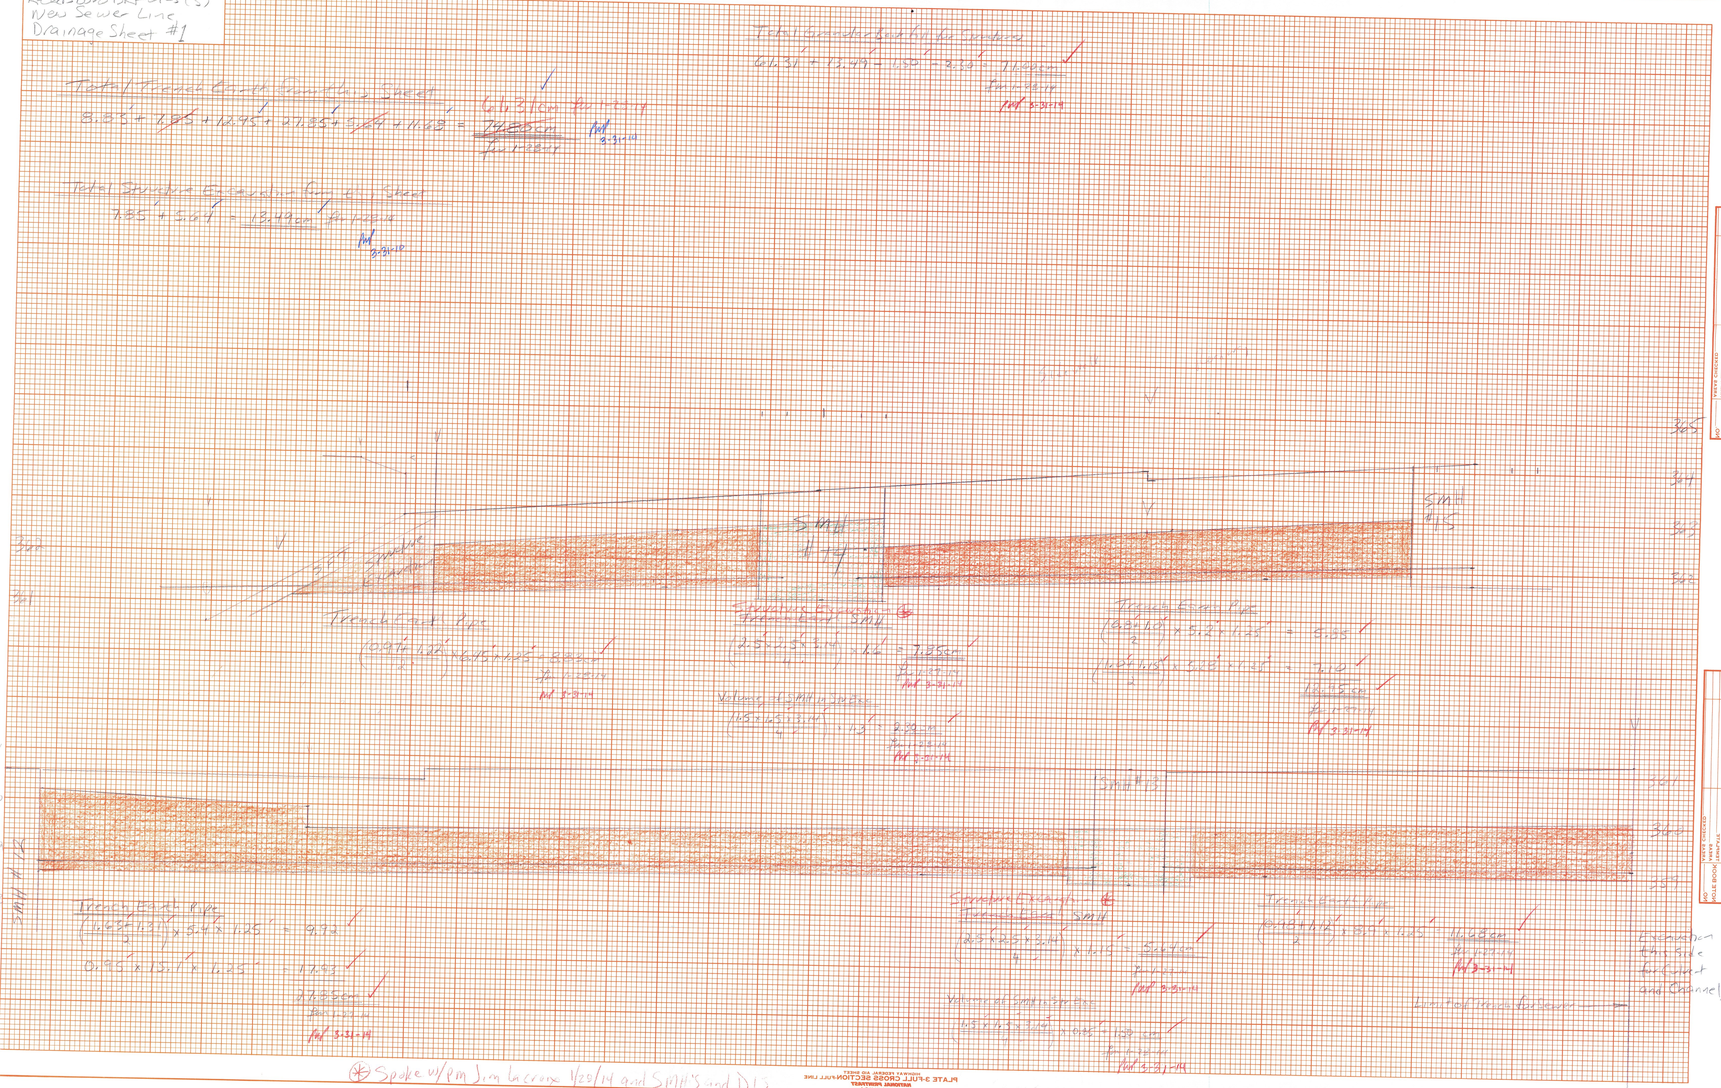

PROJECT
NO.
HOLE BOOK
PAGE
TRENCH CHECKED
BY
DATE
INSPECTOR
ENGINEER
STRUCTURE
ORIGINAL
DATE
BY

PROJECT
NO.
HOLE BOOK
PAGE
TRENCH CHECKED
BY
DATE
INSPECTOR
ENGINEER
STRUCTURE
ORIGINAL
DATE
BY

PLATE 3-FOOT CROSS SECTION FOR LINE

(*) Spoke w/ RM Jim Lacroix 1/28/14 and SMH's 13 and D15 were set into our Structure Excavation